

11













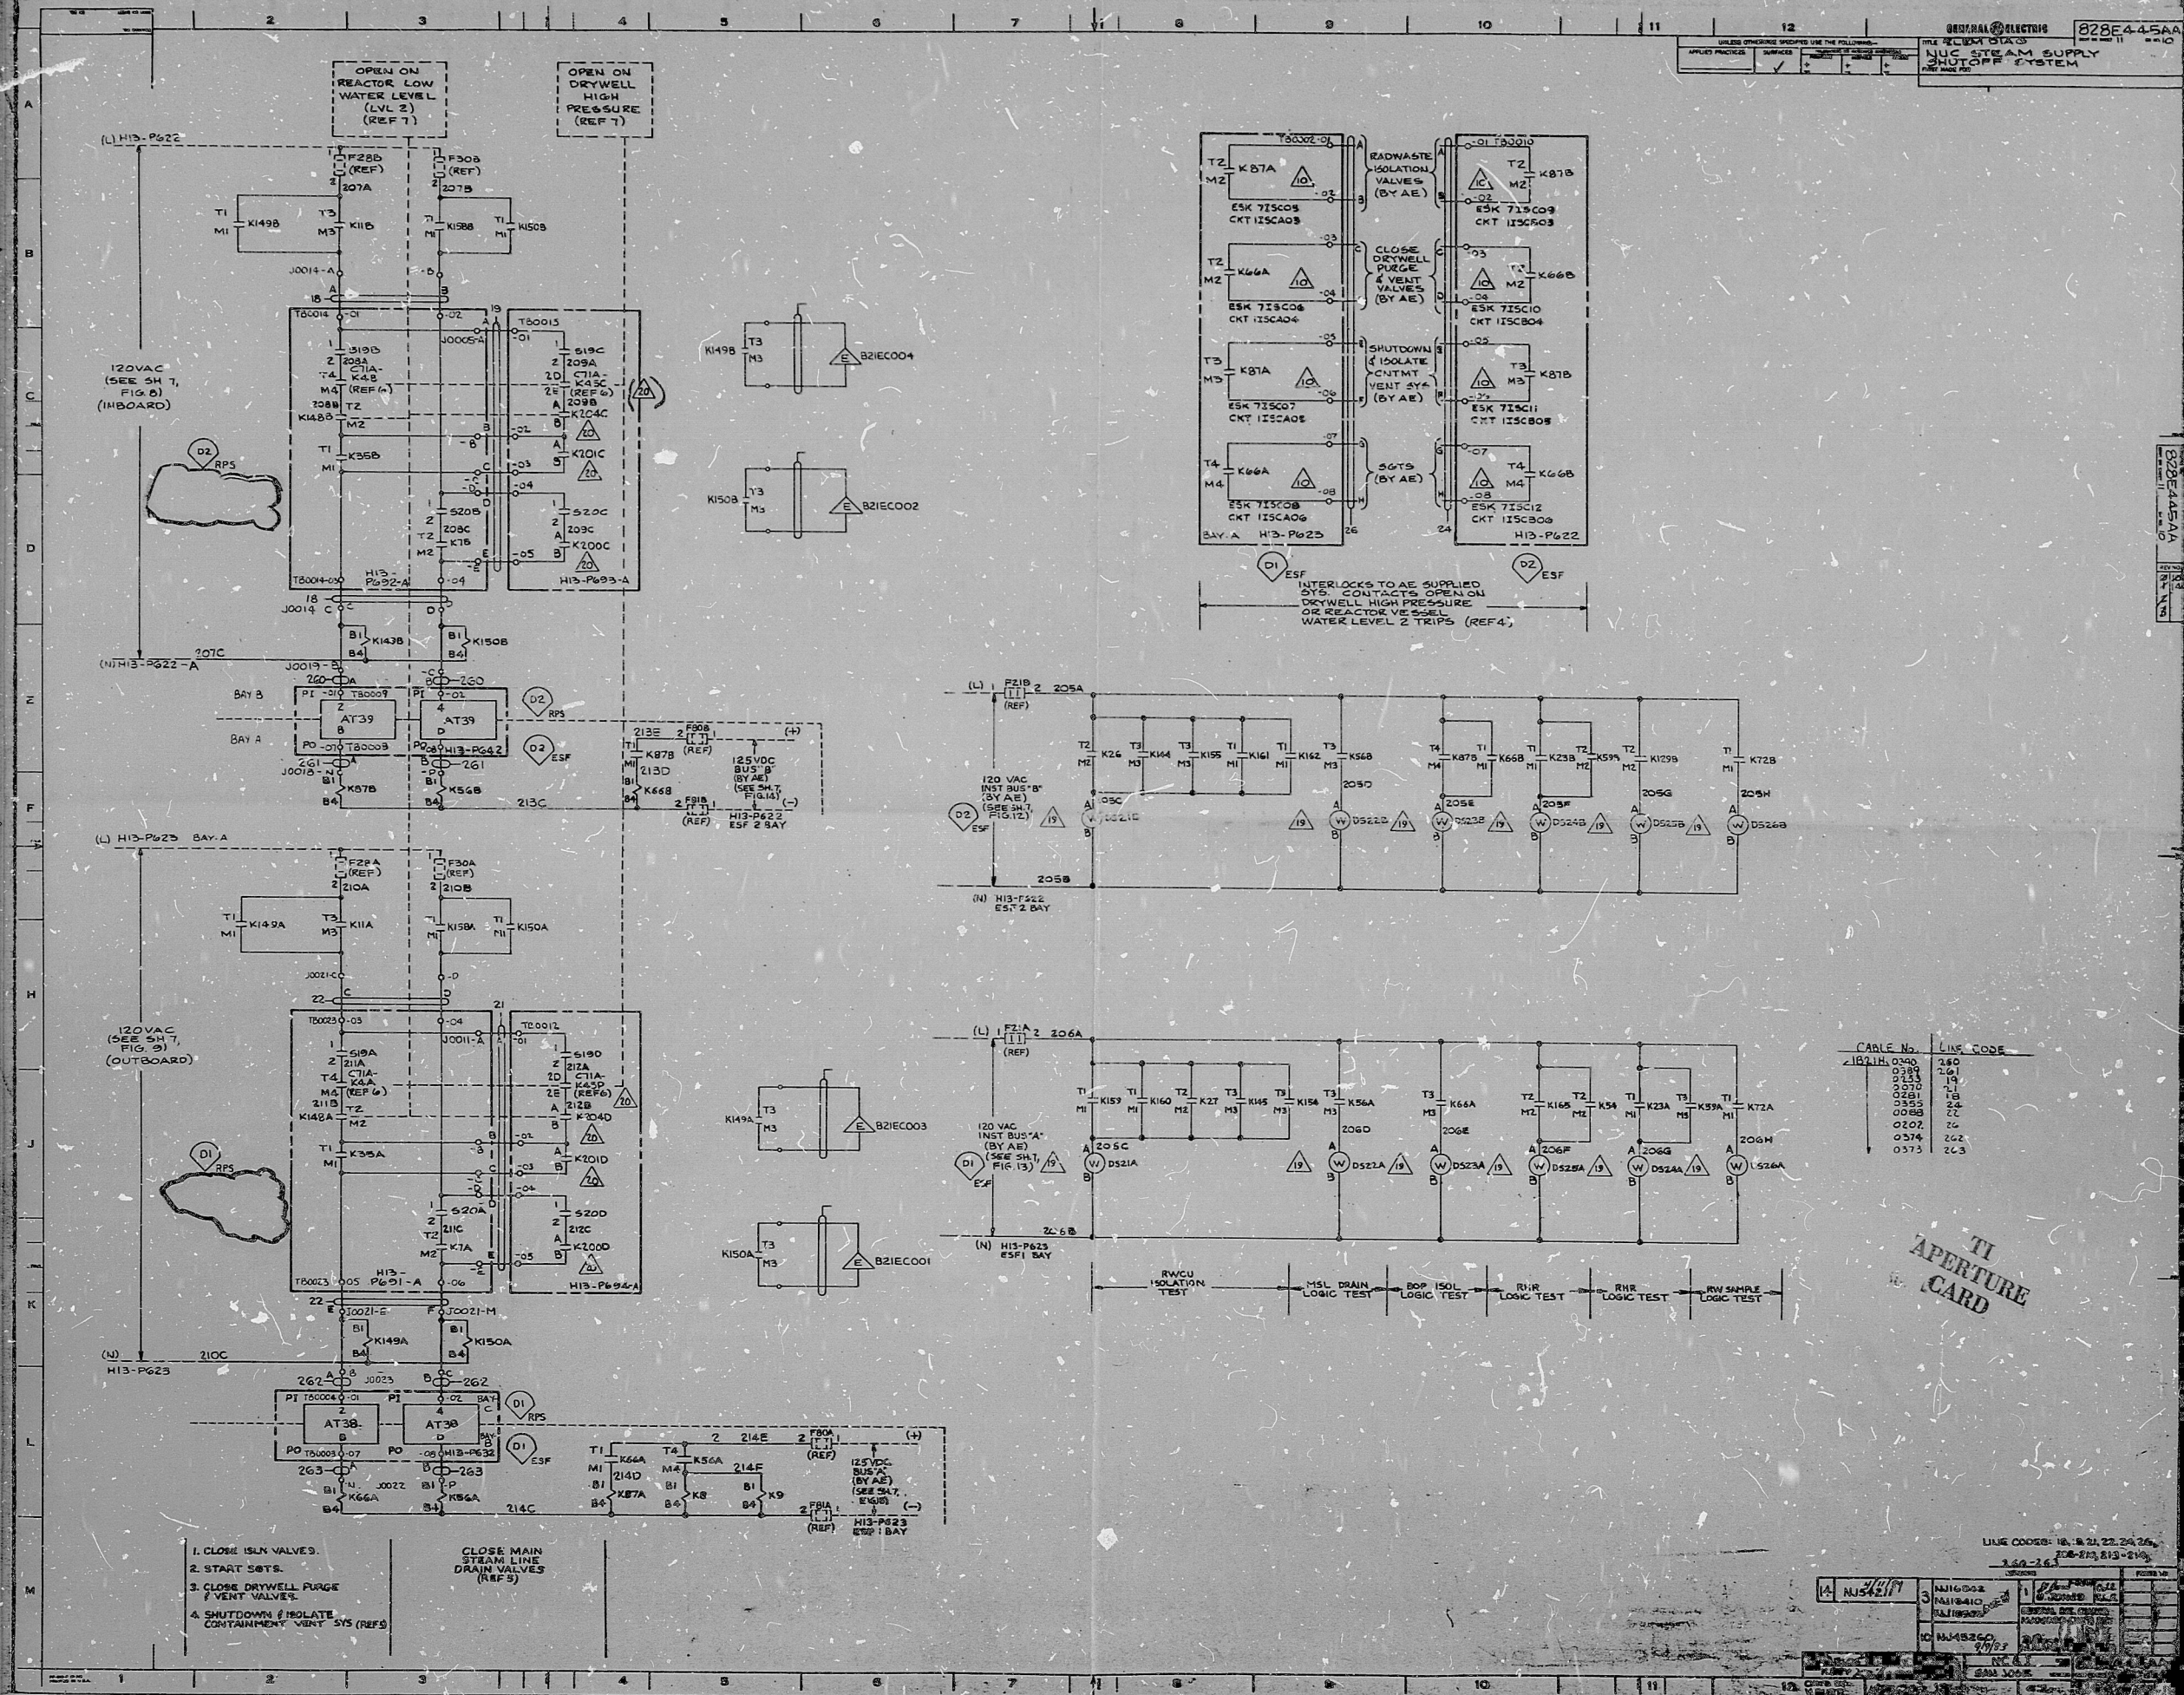

GENERAL ELECTRIC 828E445AA  
 FILE 7200010103  
 NUC STEAM SUPPLY  
 PART MADE IN U.S.A.

CABLE NO.	LINE CODE
0202	26
0374	262
0375	263

TI  
 APERTURE  
 CARD

LINE CODES: 18, 21, 22, 24, 26, 262, 263, 264,1000.



8412200183

PDR RIDS

