


This drawing and the design it covers are the property of BECHTEL. They are hereby loaned and on the borrower's express agreement that they will not be reproduced, copied, loaned, exhibited, or used in any way and printed and printed and printed by any person without the written consent given by the lender to the borrower.

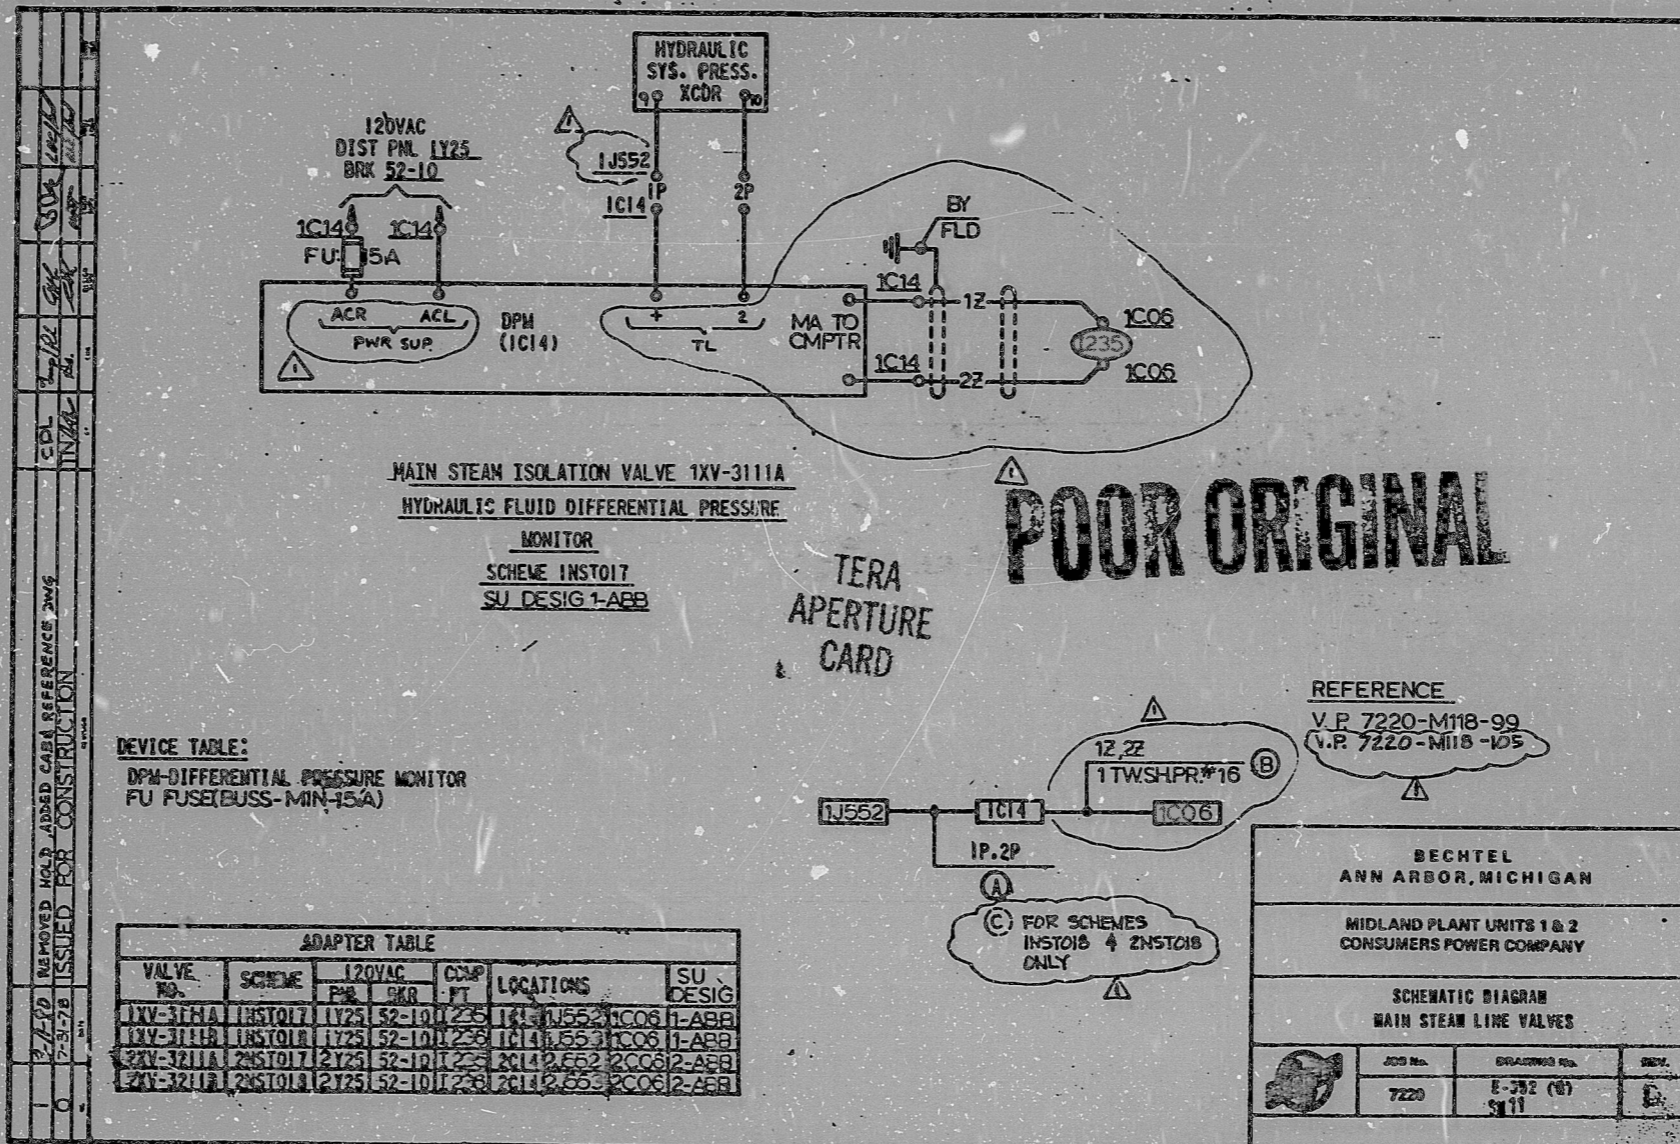


MAIN STEAM ISOLATION VALVE 1XV-3111A
 HYDRAULIC FLUID DIFFERENTIAL PRESSURE
 MONITOR
 SCHEME INST017
 SU DESIG 1-ABB

POOR ORIGINAL

DEVICE TABLE:
 DPM-DIFFERENTIAL PRESSURE MONITOR
 FU FUSE(BUSS-MIN-15A)

ADAPTER TABLE					
VALVE NO.	SCHEME	120VAC PWR	COMP BRK	LOCATIONS	SU DESIG

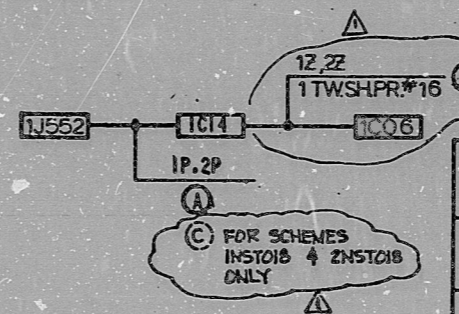

REFERENCE
 V.P. 7220-M118-99
 V.P. 7220-M118-105

BECHTEL ANN ARBOR, MICHIGAN		
MIDLAND PLANT UNITS 1 & 2 CONSUMERS POWER COMPANY		
SCHEMATIC DIAGRAM MAIN STEAM LINE VALVES		
JOB No.	DRAWING No.	REV.
7220	E-352 (01) 5/11	D

16X

I certify that the image contained on this frame was made in the normal and regular course of business, on the date stated below and that it is an accurate reproduction of the document submitted to the contractor for filming, by Bechtel Power Corporation.
 10-28-81 DATE
 R. Capelle CAMERA OPERATOR
 J. Adams CONTRACTOR'S SUPERVISOR OR MANAGER

RIDS

8112280115

