


22
17
11
8.5
8.5
11
17
22

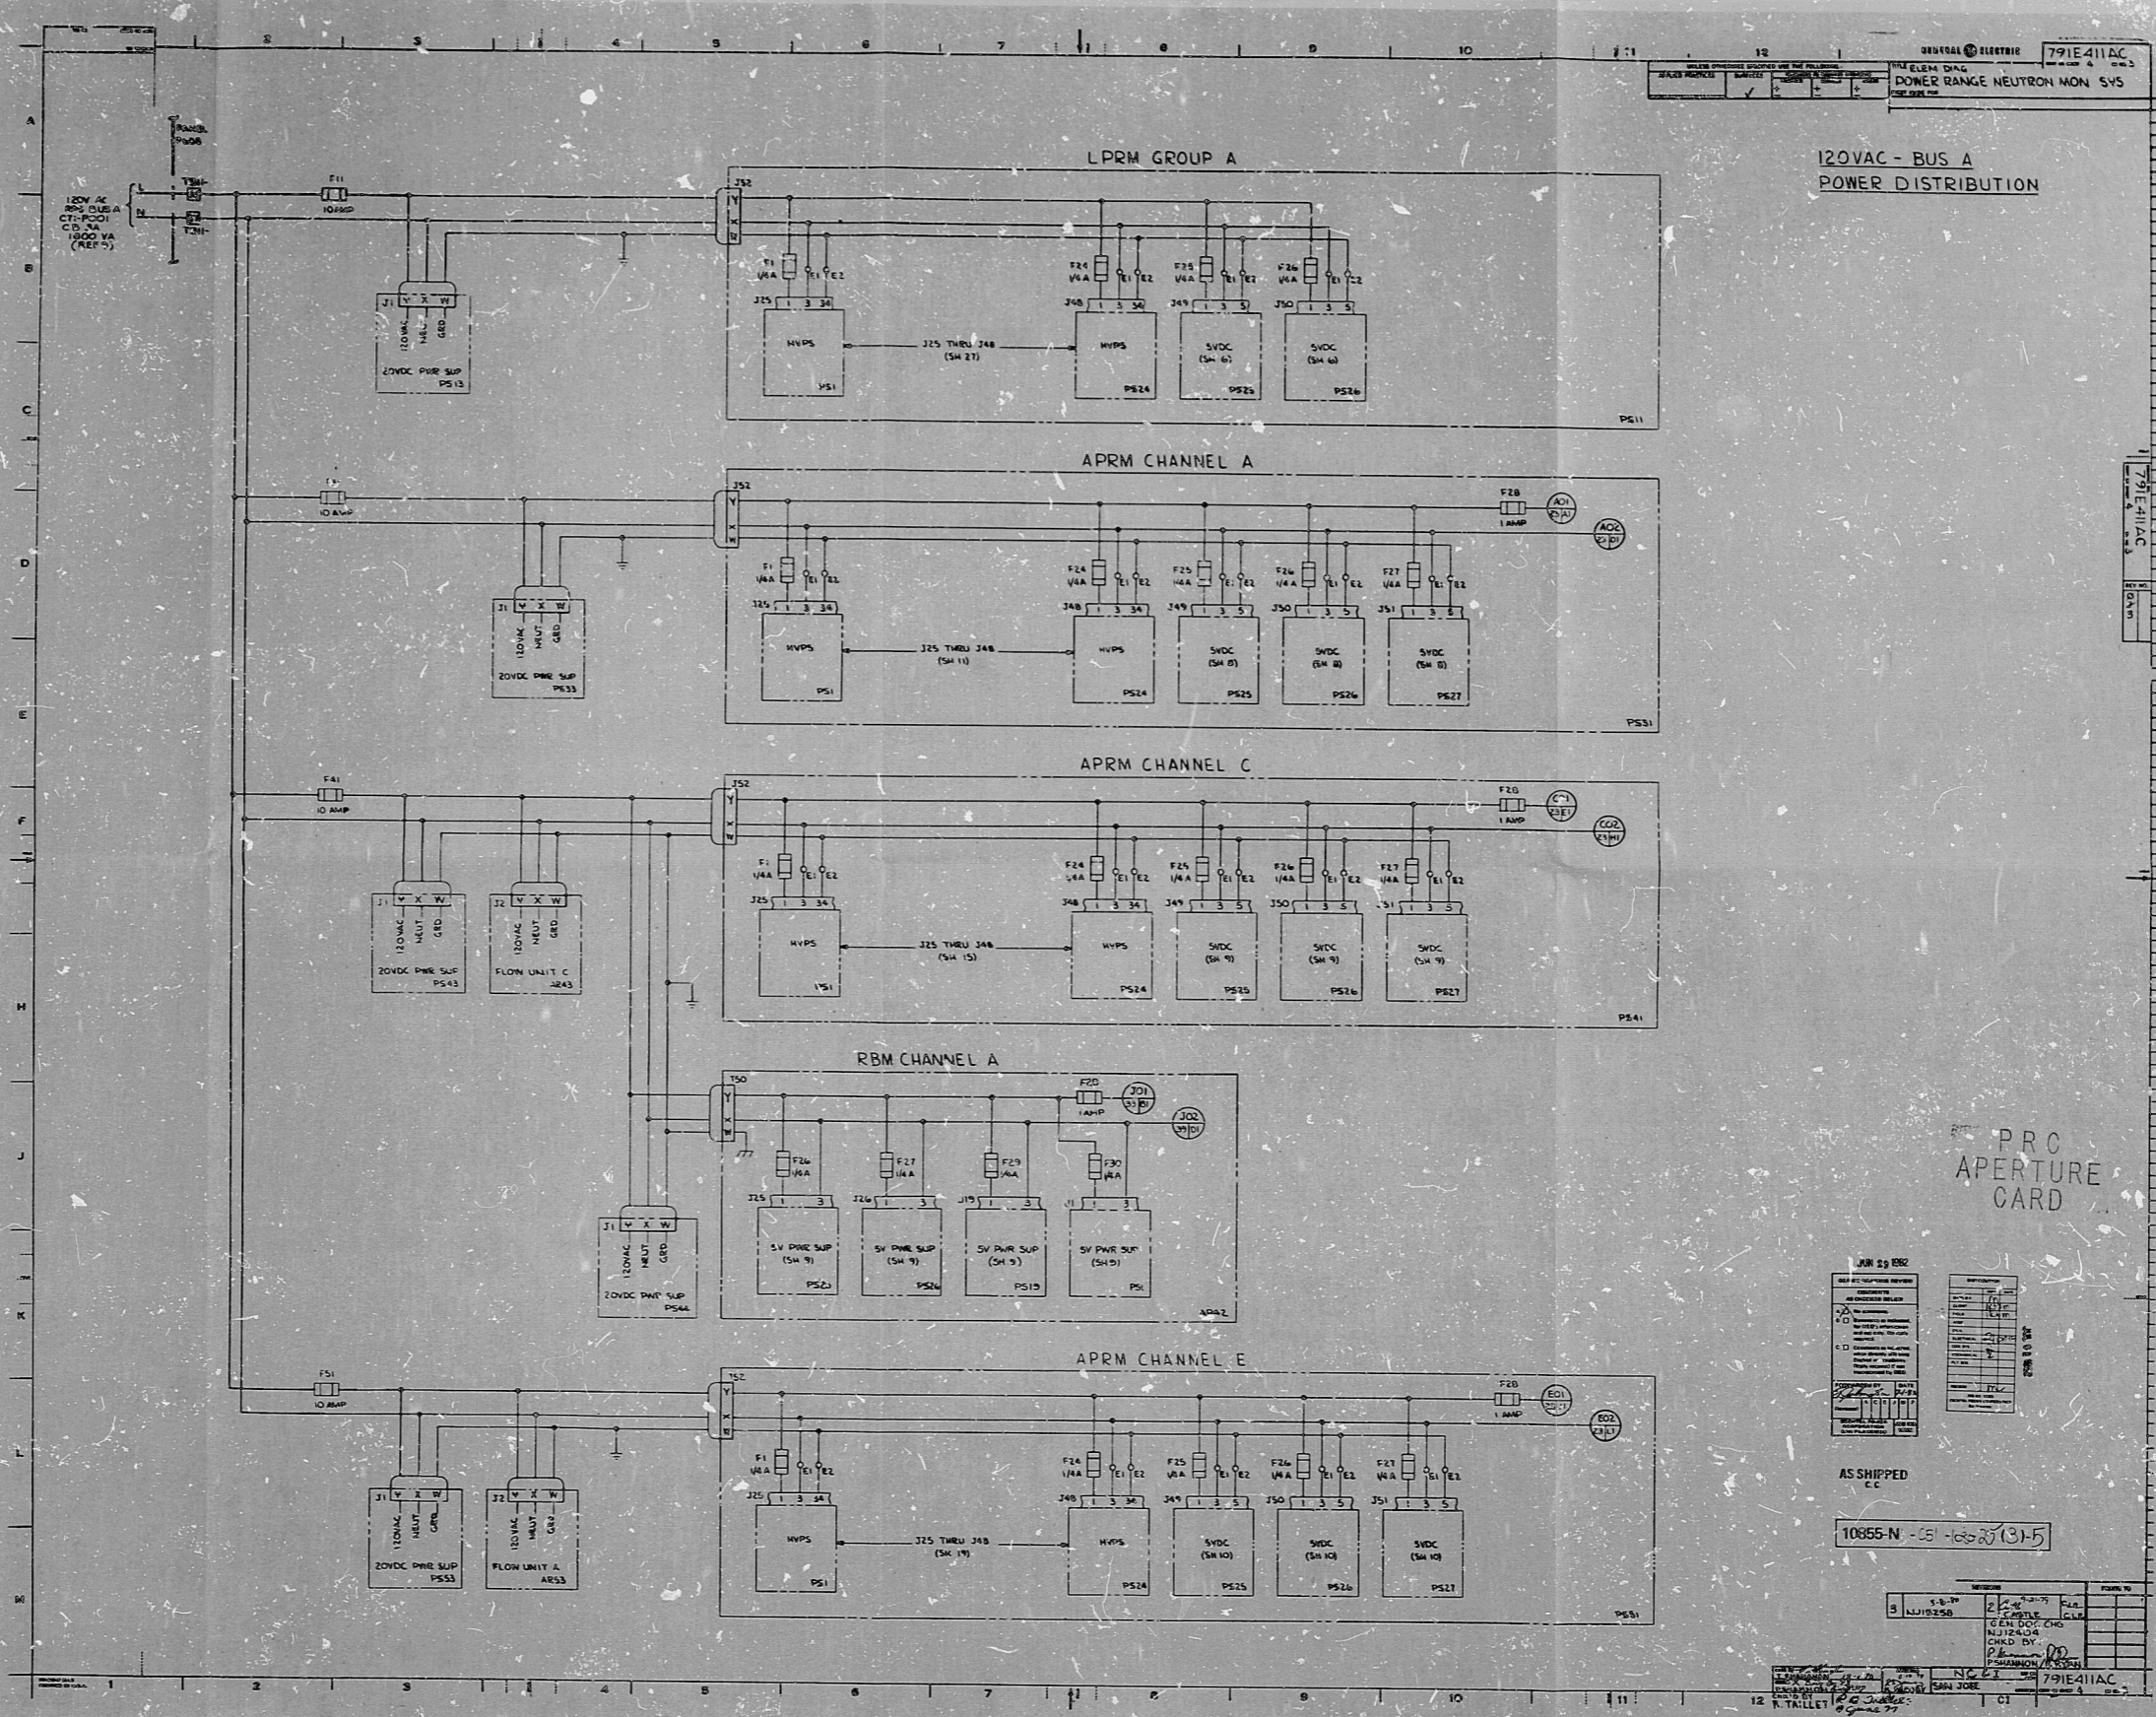

22
17
11
8.5
8.5
11
17
22

RIDS

8307290044

