
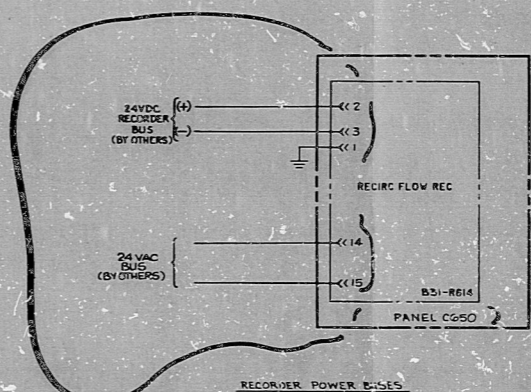


791E-411AC  
 POWER RANGE FLUTION MON SYS  
 PART NO. 10855-NI-10825 (5-75)

28VDC/24VDC/24VAC  
 POWER DISTRIBUTION

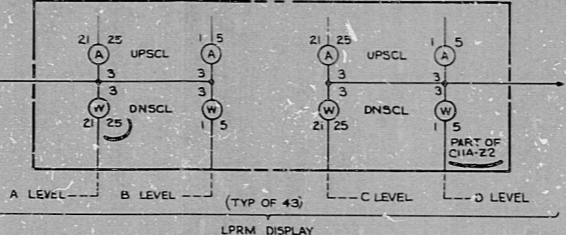

JAN 29 1982

REVISION	DATE	BY	CHKD

ASS SHIPPED 10855-NI-10825 (5-75)


10855-NI-10825 (5-75)  
 791E-411AC  
 SAN JOSE  
 108

22"  
 17"  
 11"  
 8.5"  
 8.5"  
 11"  
 17"  
 22"

22"  
 17"  
 11"  
 8.5"  
 8.5"  
 11"  
 17"  
 22"

RIDS

8307290048

