


22" 17" 11" 8.5" 11" 8.5" 17" 22"

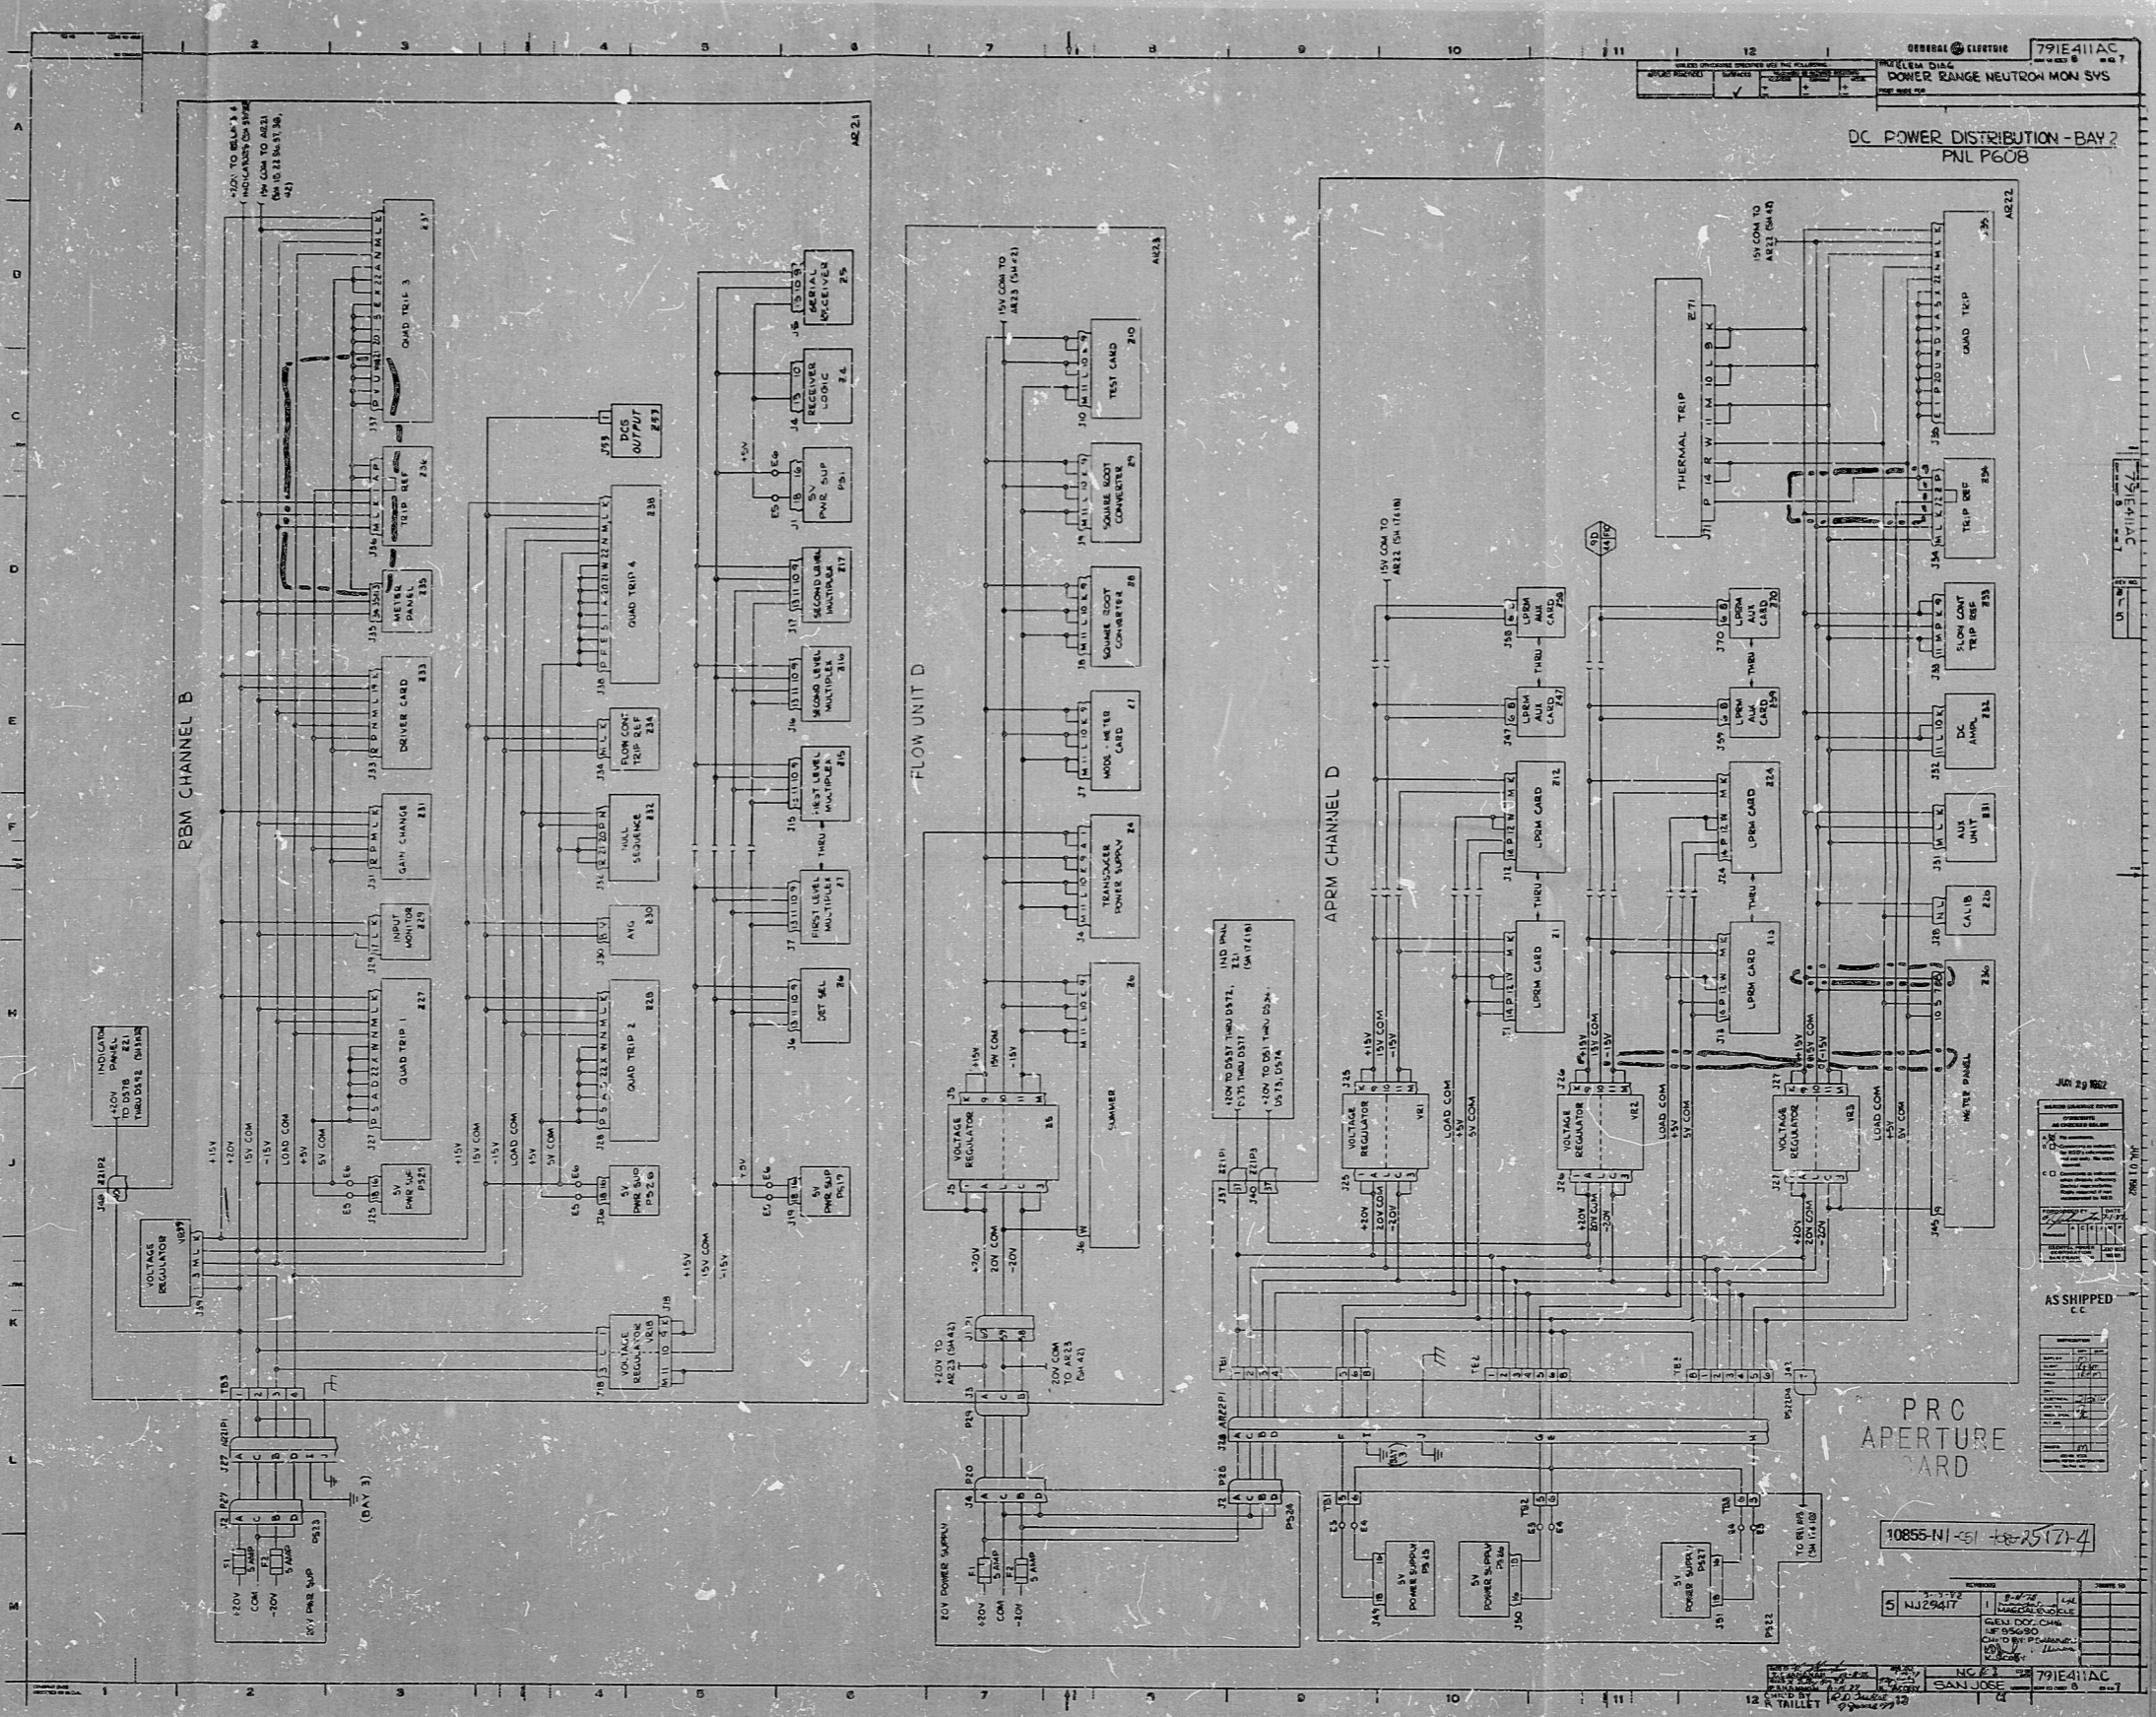

22" 17" 11" 8.5" 11" 8.5" 17" 22"

RIDS

8307290051

