


This drawing and the design it covers are the property of BECHTEL. They are hereby loaned and on the borrower's express agreement that they will not be reproduced, copied, loaned, arbitrated, or used except in the limited way and private use permitted by any written consent given by the lender to the borrower.

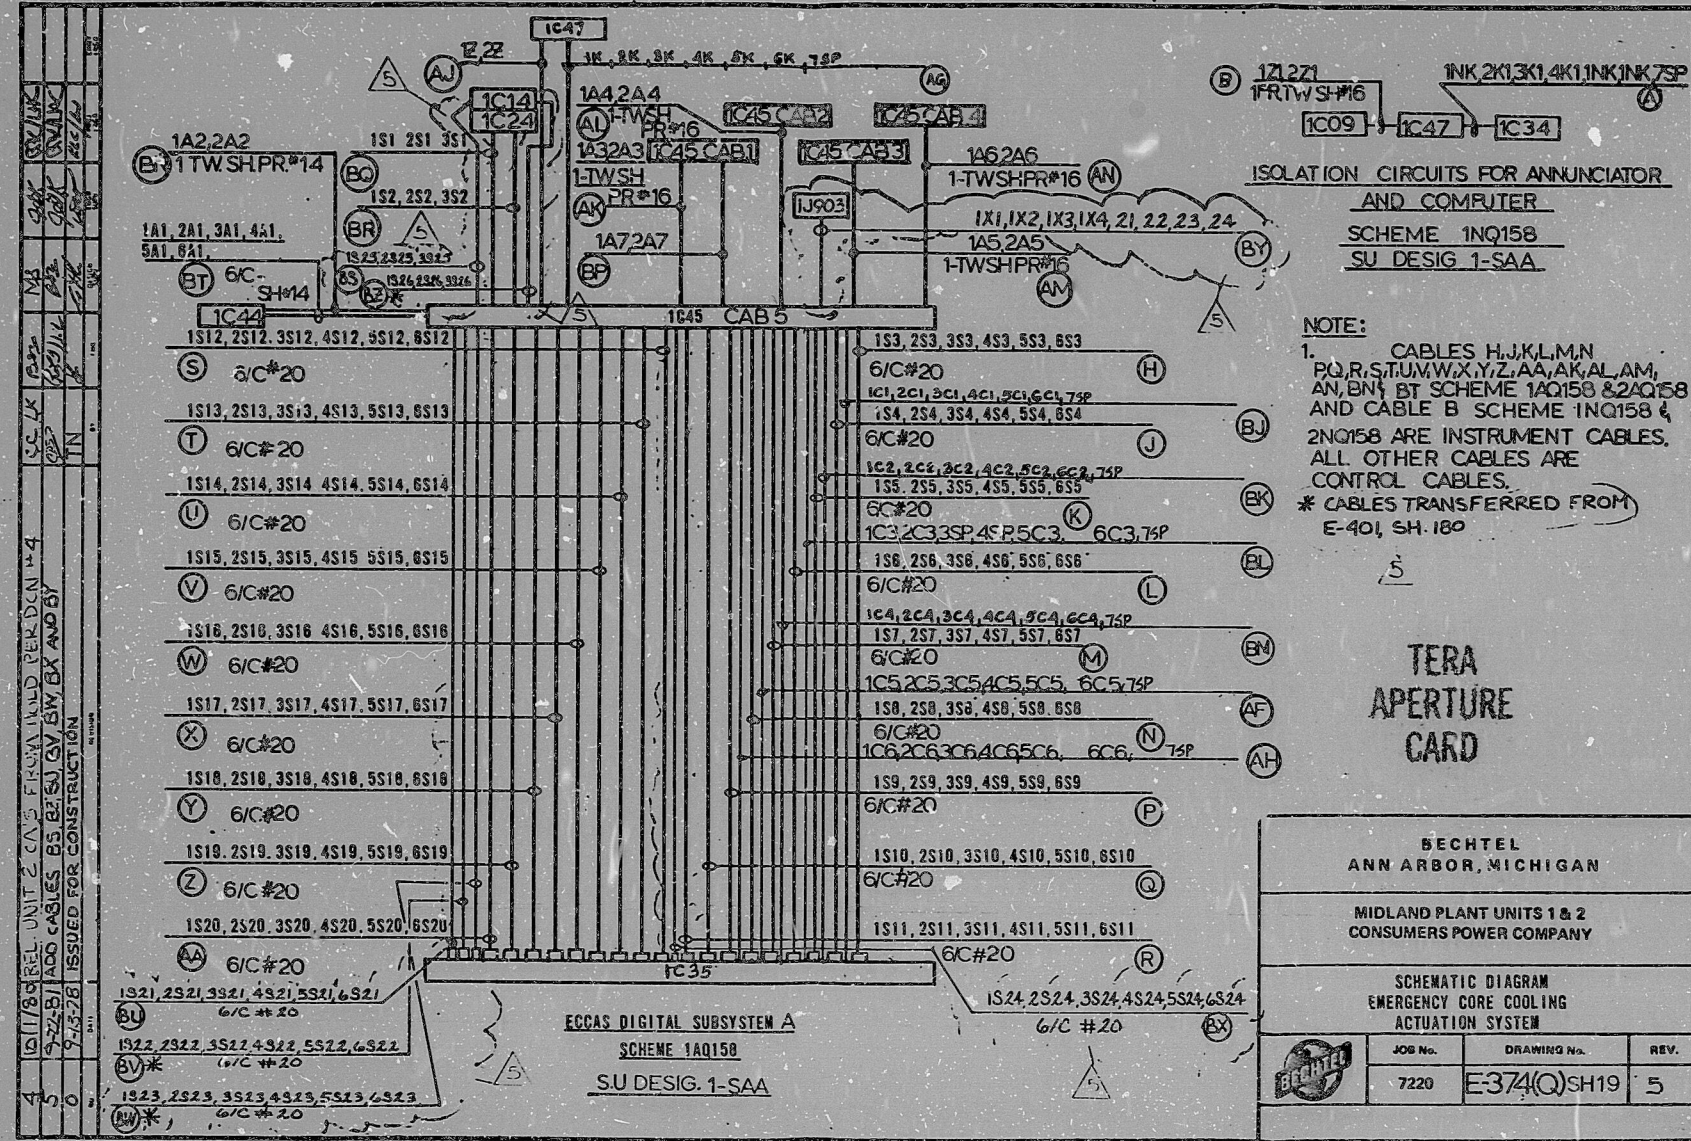

ISOLATION CIRCUITS FOR ANNUNCIATOR AND COMPUTER
SCHEME 1N0158
SU DESIG 1-SAA

NOTE:
1. CABLES H, J, K, L, M, N, P, Q, R, S, T, U, V, W, X, Y, Z, AA, AK, AL, AM, AN, BN, BT SCHEME 1A0158 & 2A0158 AND CABLE B SCHEME 1N0158 & 2N0158 ARE INSTRUMENT CABLES. ALL OTHER CABLES ARE CONTROL CABLES.
* CABLES TRANSFERRED FROM E-401, SH. 180

TERA APERTURE CARD

BECHTEL ANN ARBOR, MICHIGAN		
MIDLAND PLANT UNITS 1 & 2 CONSUMERS POWER COMPANY		
SCHEMATIC DIAGRAM EMERGENCY CORE COOLING ACTUATION SYSTEM		
JOB No.	DRAWING No.	REV.
7220	E-374(Q)SH19	5

16X

"I certify that the image contained on this frame was made in the normal and regular course of business, on the date stated below and that it is an accurate reproduction of the document submitted to the contractor for filming, by Bechtel Power Corporation."
DATE: 10-28-81
CAMERA OPERATOR: P. Capella
CONTRACTOR'S SUPERVISOR OR MANAGER: J. Alvarado

11

11

5'8"

8.5"

11"

17"

11

11

5'8"

8.5"

11"

17"

RIDS

811 2280167

