


22" 17" 11" 8.5" 11" 8.5" 17" 22"

22" 17" 11" 8.5" 11" 8.5" 17" 22"

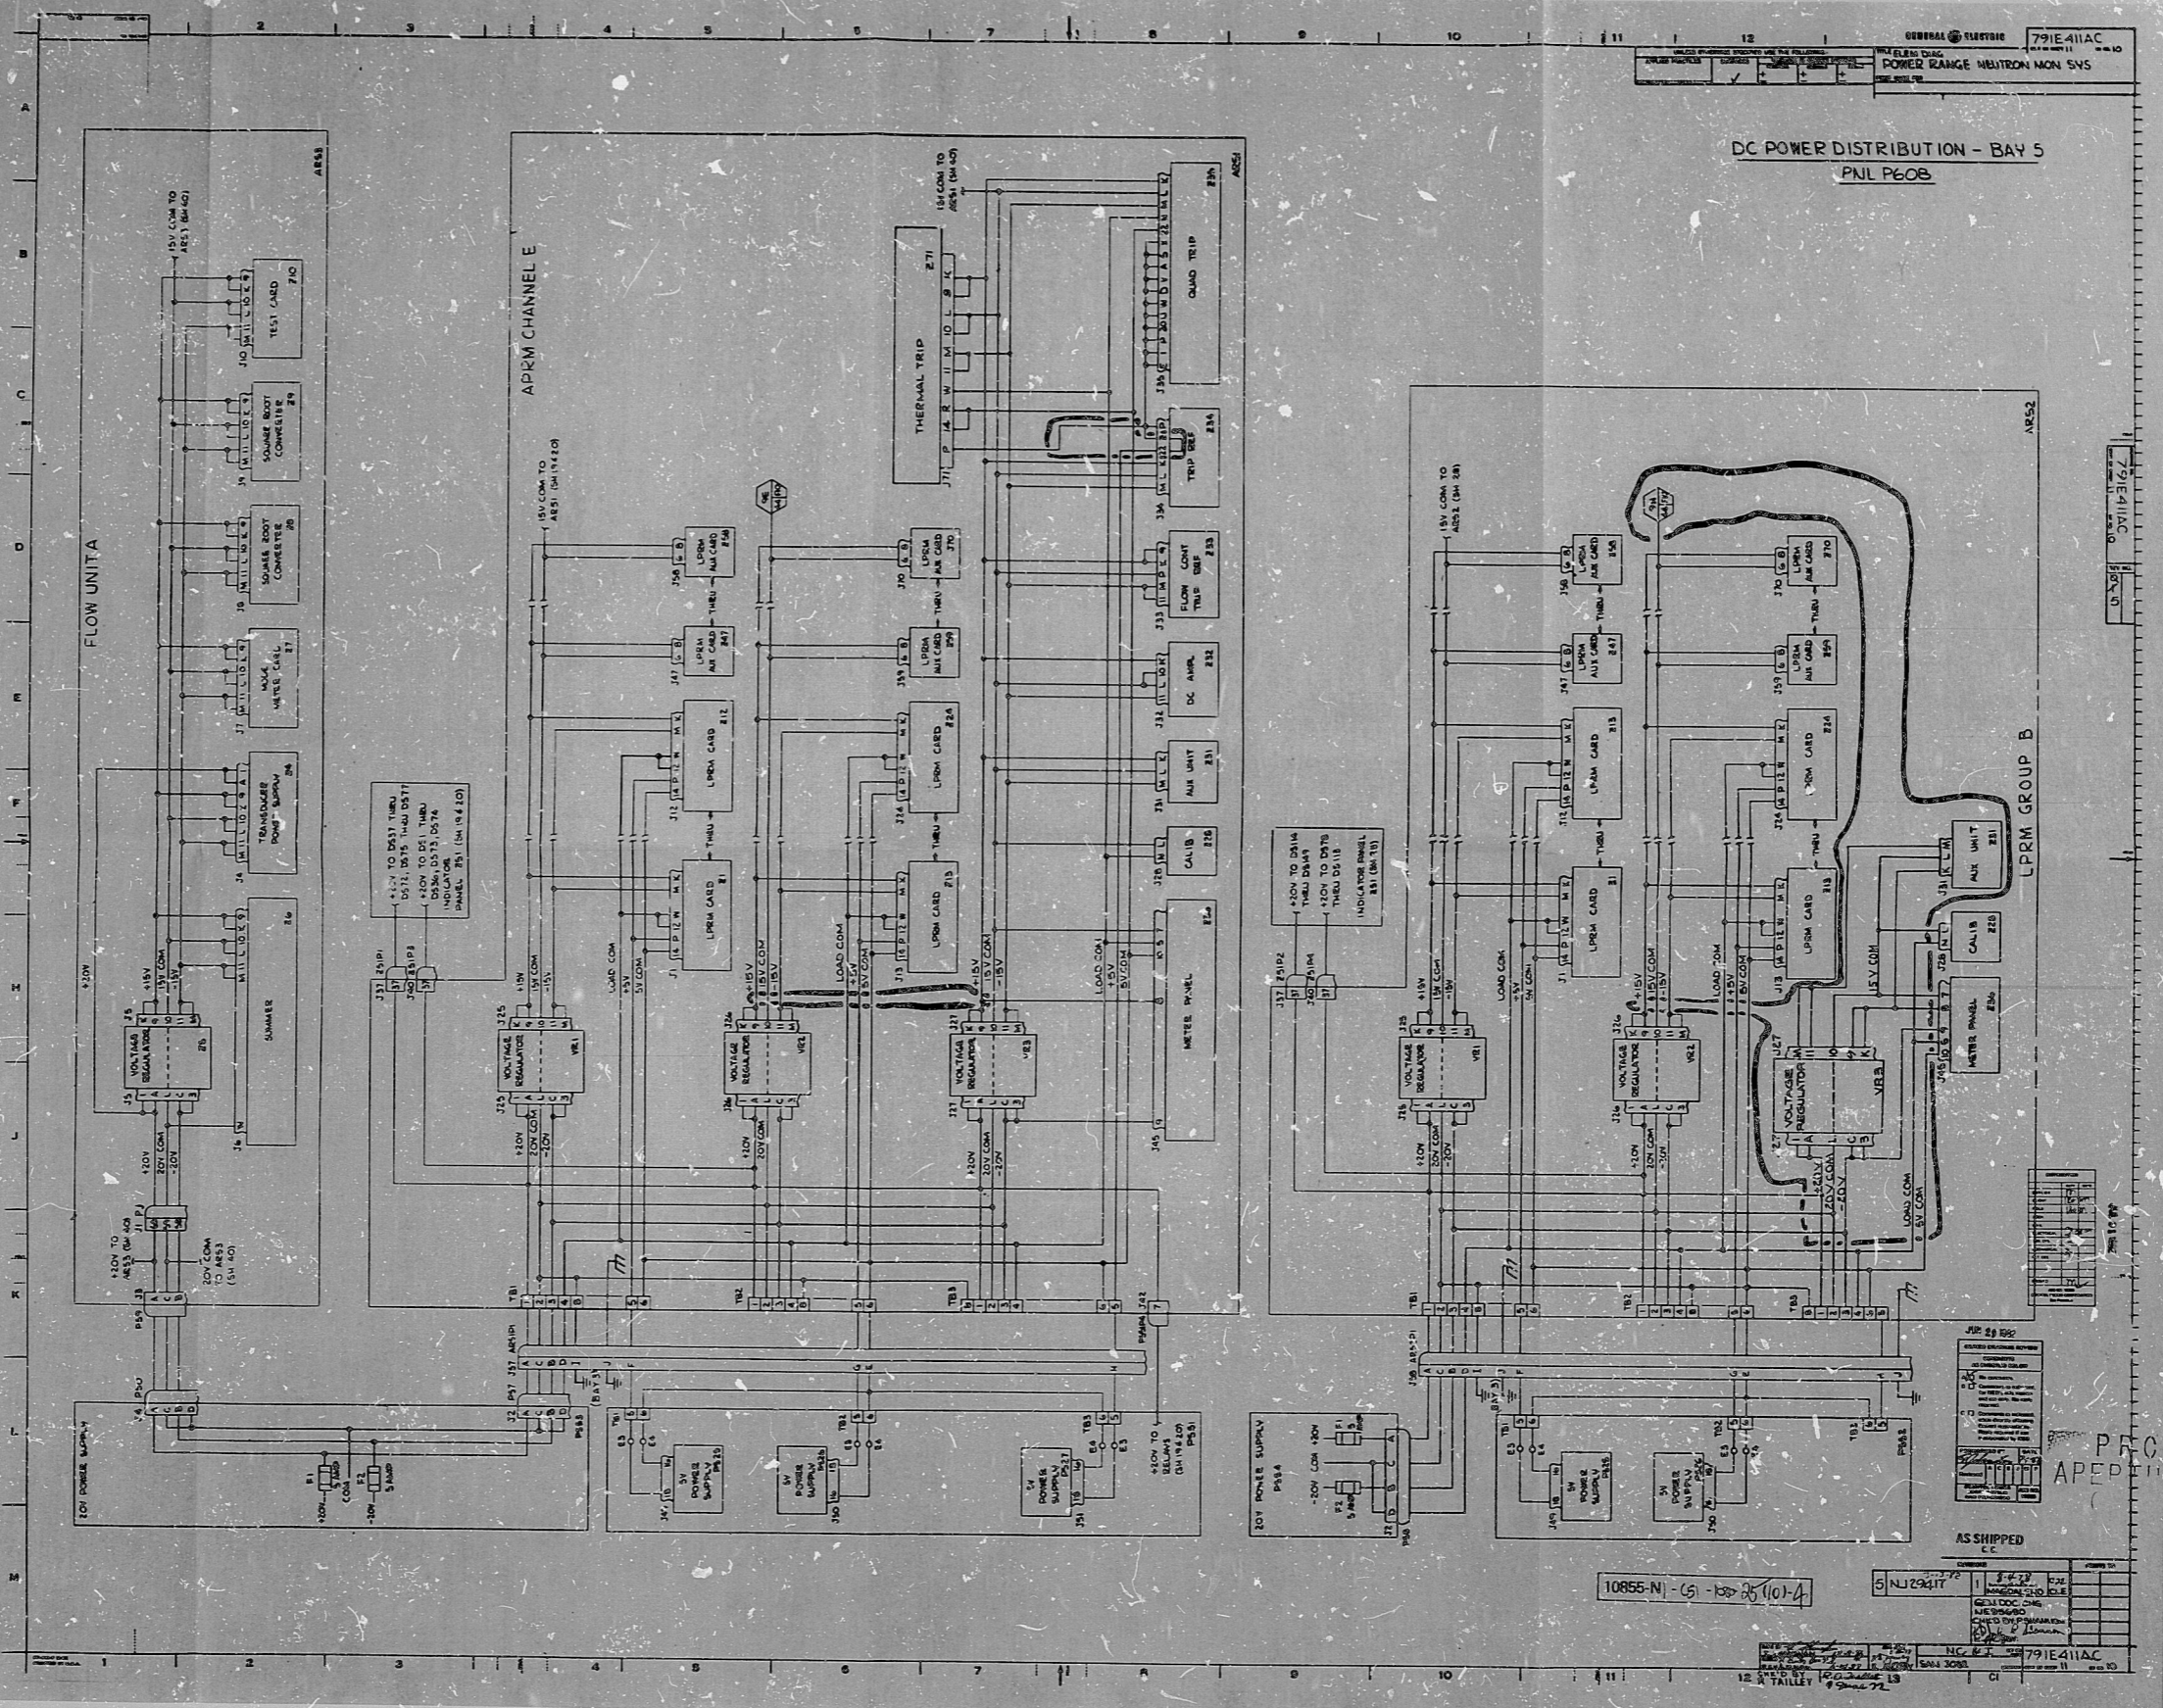

DC POWER DISTRIBUTION - BAY 5  
PNL P608

10855-NJ-(5)-130-25(10)-4

REV	DATE	BY	CHKD
1			
2			
AS SHIPPED  
C.C.

GENERAL ELECTRIC 791E411AC  
POWER RANGE NEUTRON MON SYS

RIDS

8397290057

