


44 11

44 11

44 58

8.5"

17"

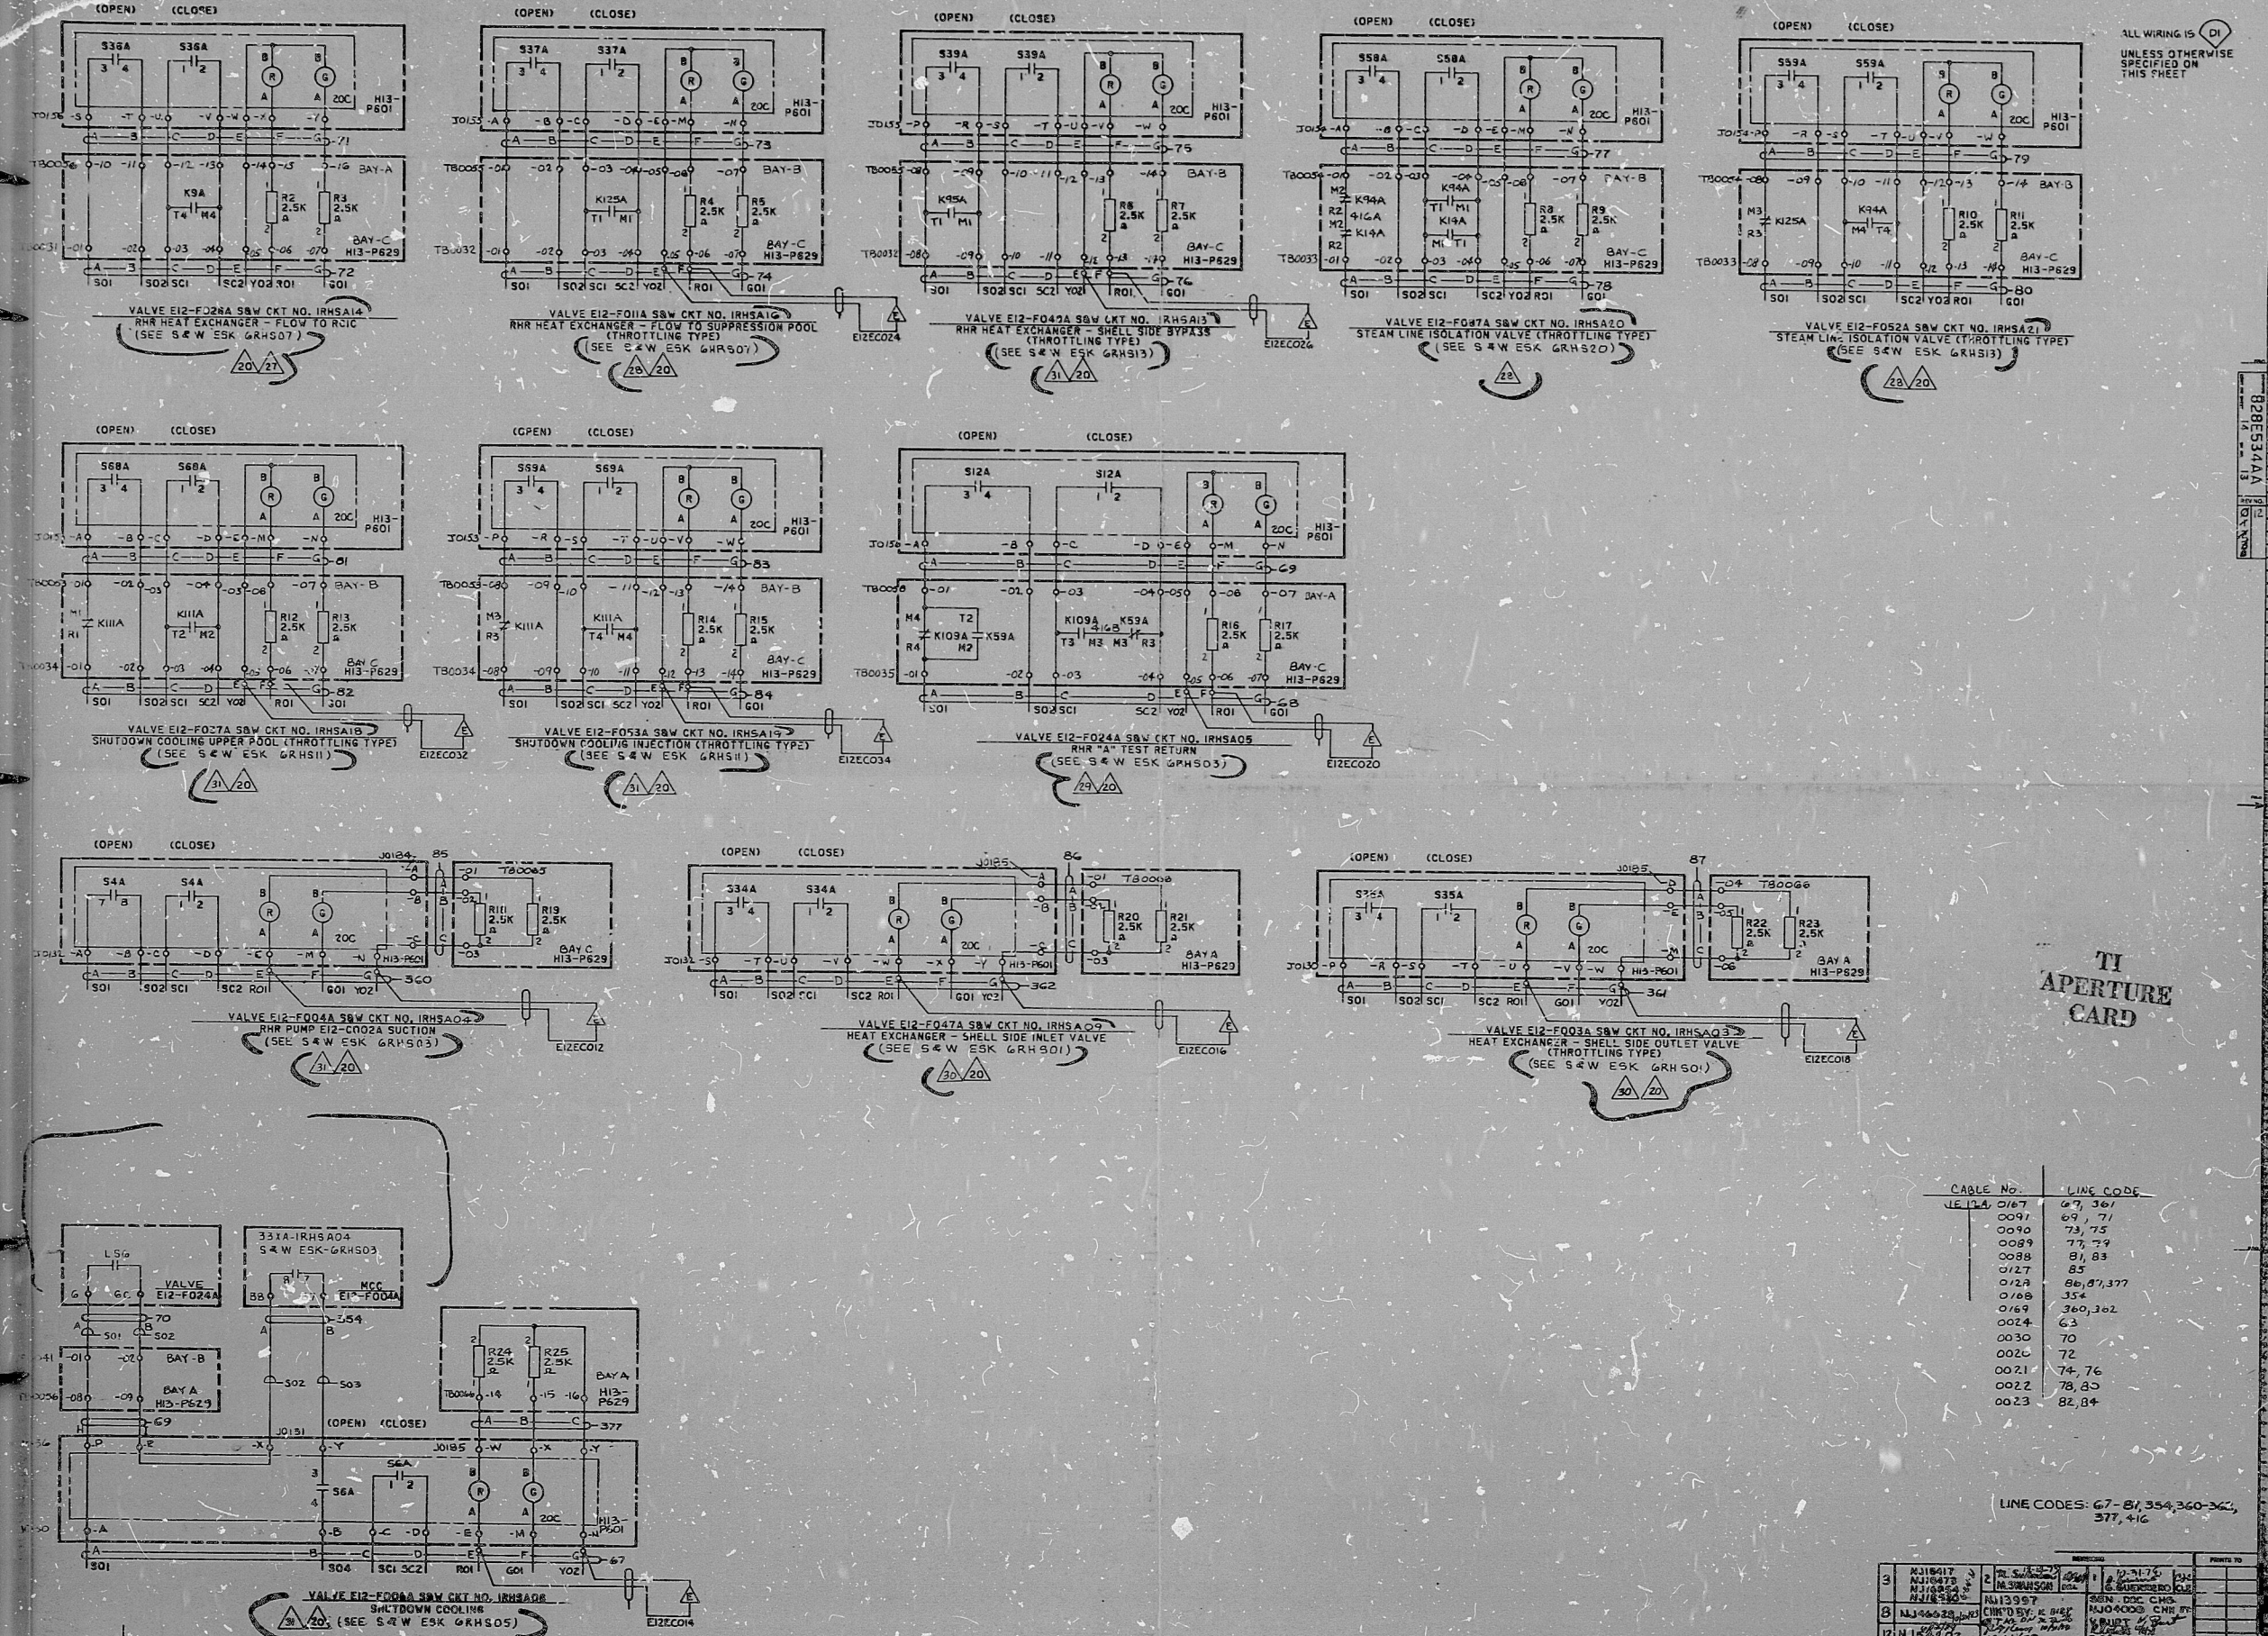

828534AA

44 11

44 11

44 58

0.5"

11"






GENERAL ELECTRIC 828534AA

SALES JOSE

CI

PDR RIDS

8412200227

