


This drawing and the design it covers are the property of BECHTEL. They are hereby loaned and on the borrower's express agreement that they will not be reproduced, copied, loaned, exhibited, or used except in the limited way and private use permitted by any written contract given by the lender to the borrower.

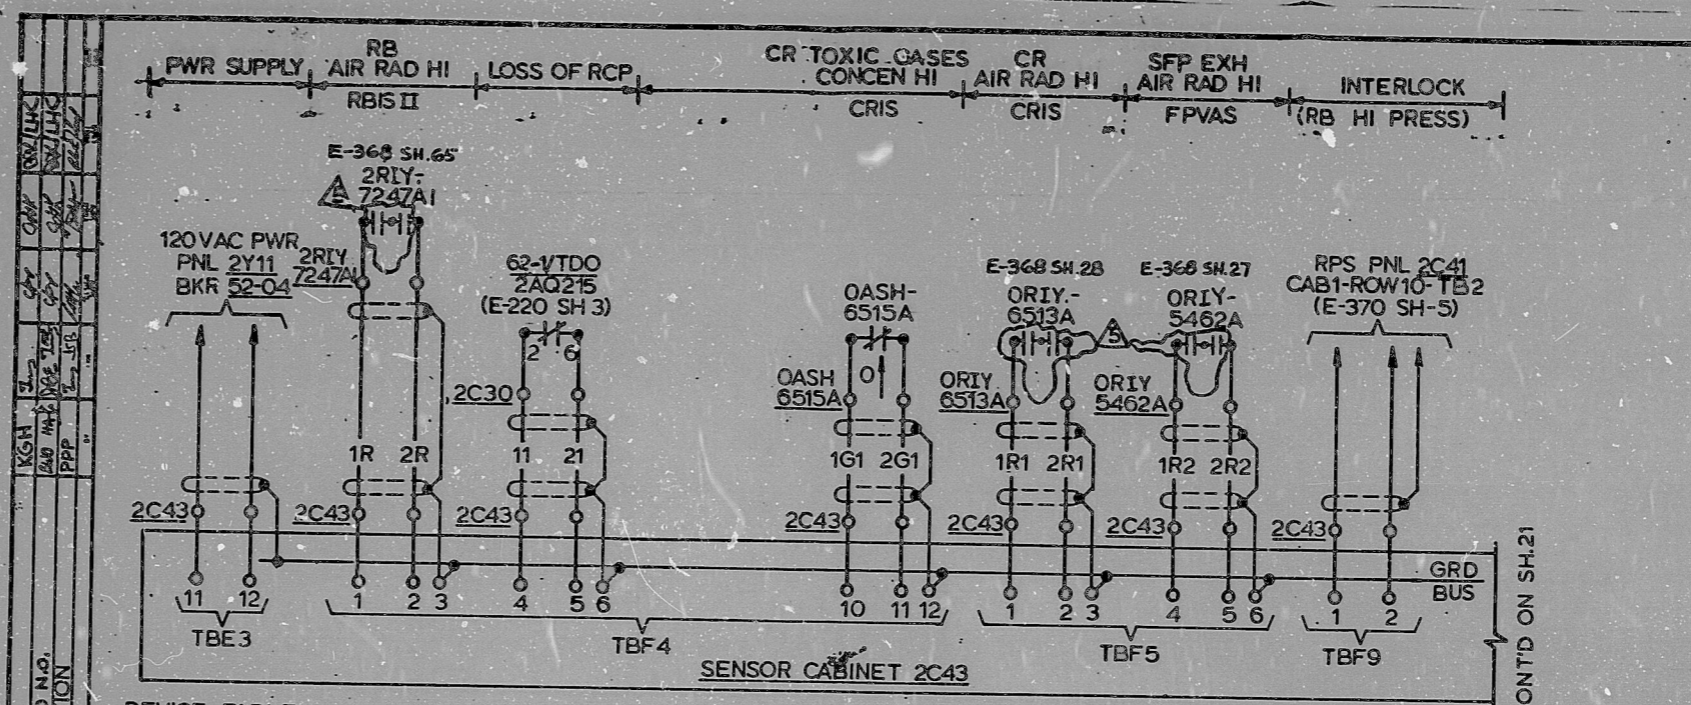

DEVICE TABLE:

2RY1-7247A: RB AIR RAD DETECTION CONTROL STATION.
 OASH-6515A: CR TOXIC GAS DETECTION HI SW.
 ORYI-6513A: CR AIR RAD DETECTION CONTROL STATION.
 ORYI-5462A: SPENT FUEL POOL EXH AIR RAD DETECTION CONTROL STATION.

TERA APERTURE CARD

REFERENCE:
 LOGIC DIAGRAM: J-299
 V.P.: 7220-J-207-25 THRU 28

SENSOR CABINET 'A' DIGITAL INPUT SCHEME 2A0396

NOTE
 FOR S.U. DESIG SEE SH.22

BECHTEL ANN ARBOR, MICHIGAN		
MIDLAND PLANT UNITS 1 & 2 CONSUMERS POWER COMPANY		
SCHEMATIC DIAGRAM BOP-ENGINEERED SAFETY FEATURES ACTUATION SYSTEM		
JOB No.	DRAWING No.	REV.
7220	E-375(O) SH20	5

16X

"I certify that the image contained on this frame was made in the normal and regular course of business, on the date stated below and that it is an accurate reproduction of the document submitted to the contractor for filming, by Bechtel Power Corporation.
 10-28-81 DATE
 R. Casella CAMERA OPERATOR
 J. Alvarado CONTRACTOR'S SUPERVISOR OR MANAGER

RIDS

8112280180

