
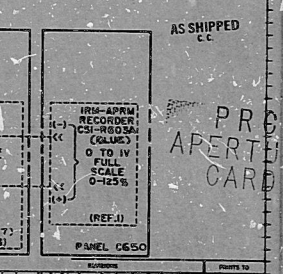
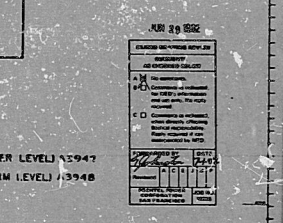
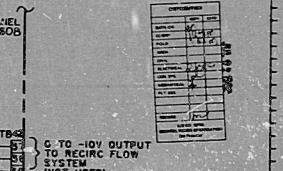


791E414C
POWER RANGE NEUTRON MON SYS.

APRM CHANNEL C TRIP SECTION

RELAY TABULATION FOR P641


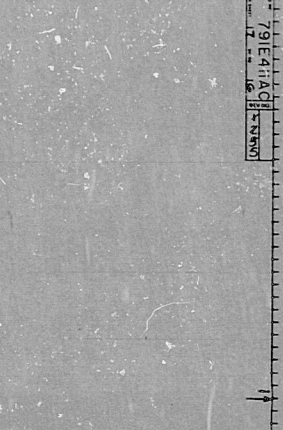

AS SHIPPED
PRO APERTURE CARD

10855-N1-C5-100-25 (10/61)

NO.	DESCRIPTION	DATE	BY
1	DESIGNED	10/61	JACOBSON
2	RETRACED WITH		
3	GEN DOC CHG		

RIDS

BAT290068

