


This drawing and the design it covers are the property of BECHTEL. They are hereby loaned and on the licensee's express agreement that they will not be reproduced, copied, loaned, assigned, or used except in the limited way and under the conditions permitted by any written consent given by the licensor to the licensee.

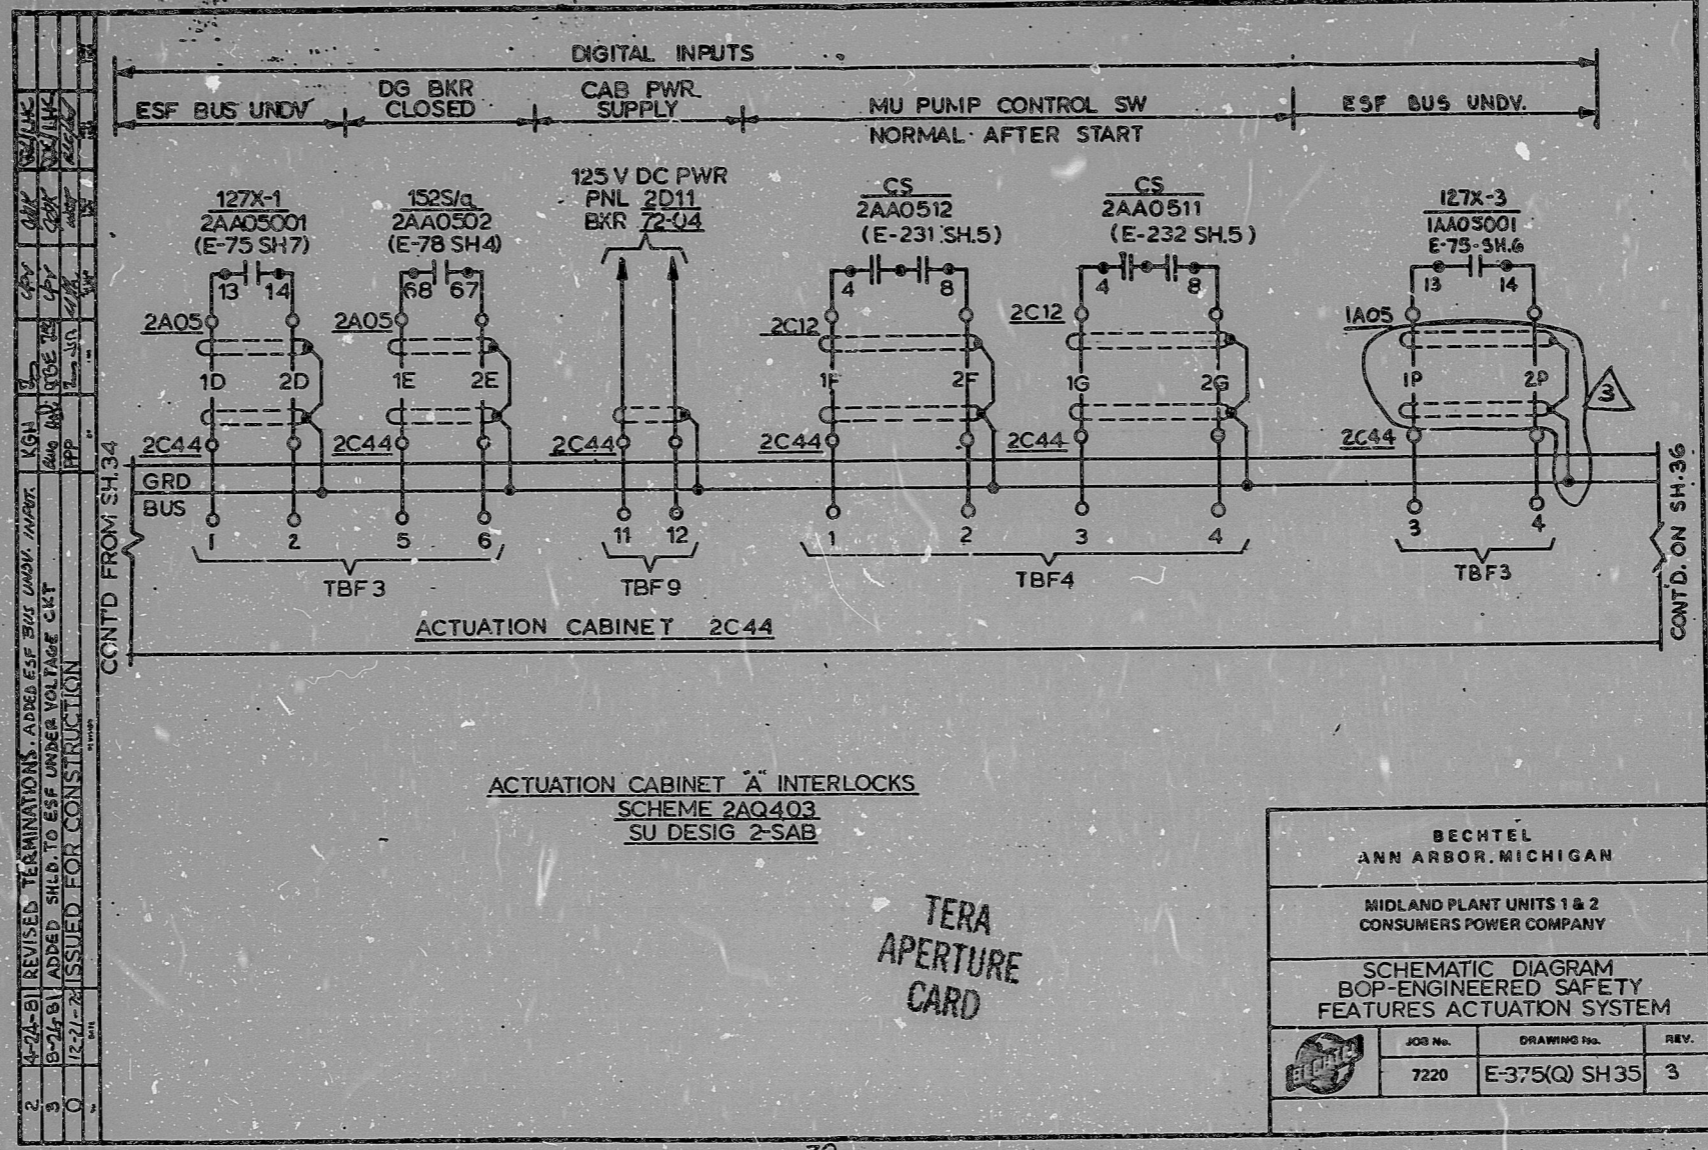

REV.	DATE	DESCRIPTION	BY	CHKD.
1	12-21-74	ISSUED FOR CONSTRUCTION	KGH	KGH
2	4-24-81	REVISED TERMINATIONS. ADDED ESF BUS UNDV. INPRT.	KGH	KGH
3	8-24-81	ADDED SHLD. TO ESF UNDER VOLTAGE CKT	KGH	KGH

ACTUATION CABINET "A" INTERLOCKS
SCHEME 2AQ403
SU DESIG 2-SAB

TERA
APERTURE
CARD

BECHTEL ANN ARBOR, MICHIGAN		
MIDLAND PLANT UNITS 1 & 2 CONSUMERS POWER COMPANY		
SCHEMATIC DIAGRAM BOP-ENGINEERED SAFETY FEATURES ACTUATION SYSTEM		
JOB No.	DRAWING No.	REV.
7220	E-375(Q) SH35	3

I certify that the image contained on this frame was made in the normal and regular course of business, on the date stated below and that it is an accurate reproduction of the document submitted to the contractor for filing, by Bechtel Power Corporation.

16X

10-28-81 DATE
P. Capelle CAMERA OPERATOR
CONTRACTOR'S SUPERVISOR OR MANAGER

11
9.8

8.5"

11"

17"

11
9.8

8.5"

11"

17"

RIDS

8112280187

