


This drawing and the design it covers are the property of BECHTEL. They are hereby loaned and on the borrower's express agreement that they will not be reproduced, copied, loaned, exhibited, or used except in the limited way and under the conditions set forth in the loan agreement.

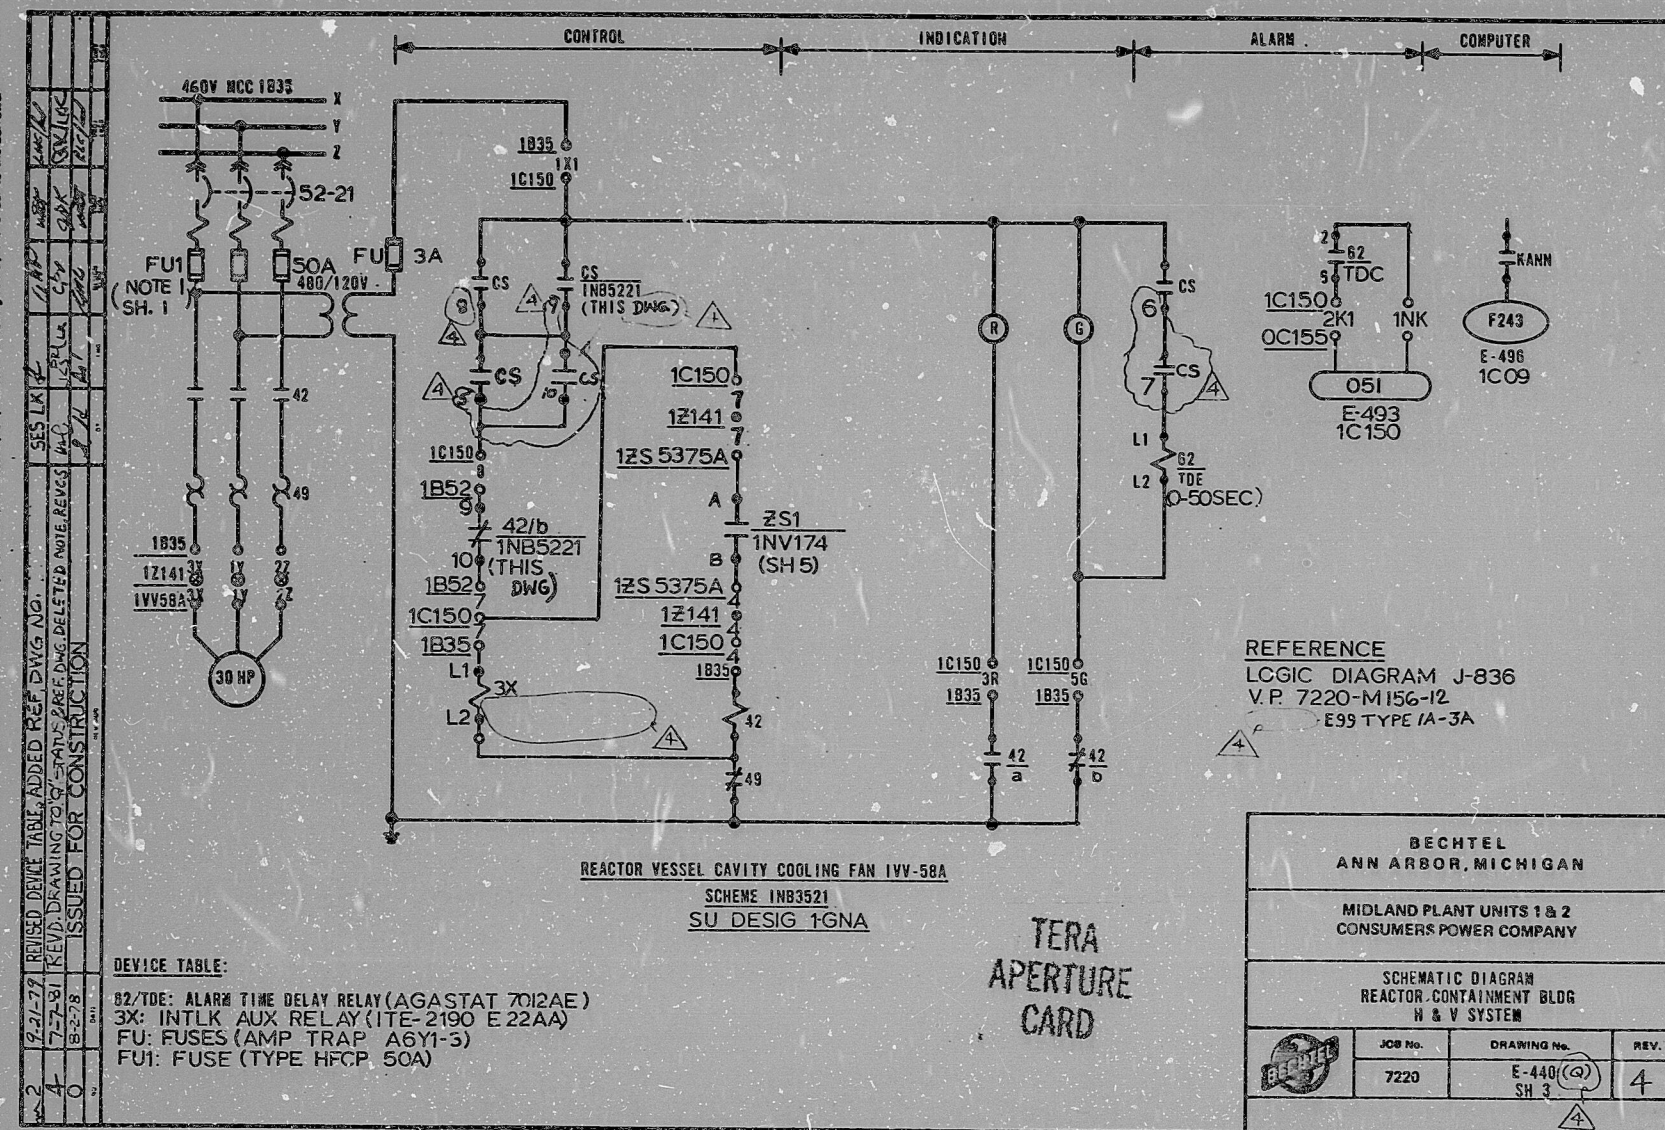

DEVICE TABLE:

- B2/TDE: ALARM TIME DELAY RELAY (AGASTAT 7012AE)
- 3X: INTLK AUX RELAY (ITE-2190 E 22AA)
- FU: FUSES (AMP TRAP A6Y1-5)
- FU1: FUSE (TYPE HFCP, 50A)

"I certify that the image contained on this frame was made in the normal and regular course of business, on the date stated below and that it is an accurate reproduction of the document submitted to the contractor for filming, by Bechtel Power Corporation."

16X

DATE 11-2-81
CAMERA OPERATOR R. Capelle
CONTRACTOR'S SUPERVISOR J. Thomas
OR MANAGER

RIDS

81/2280226

