


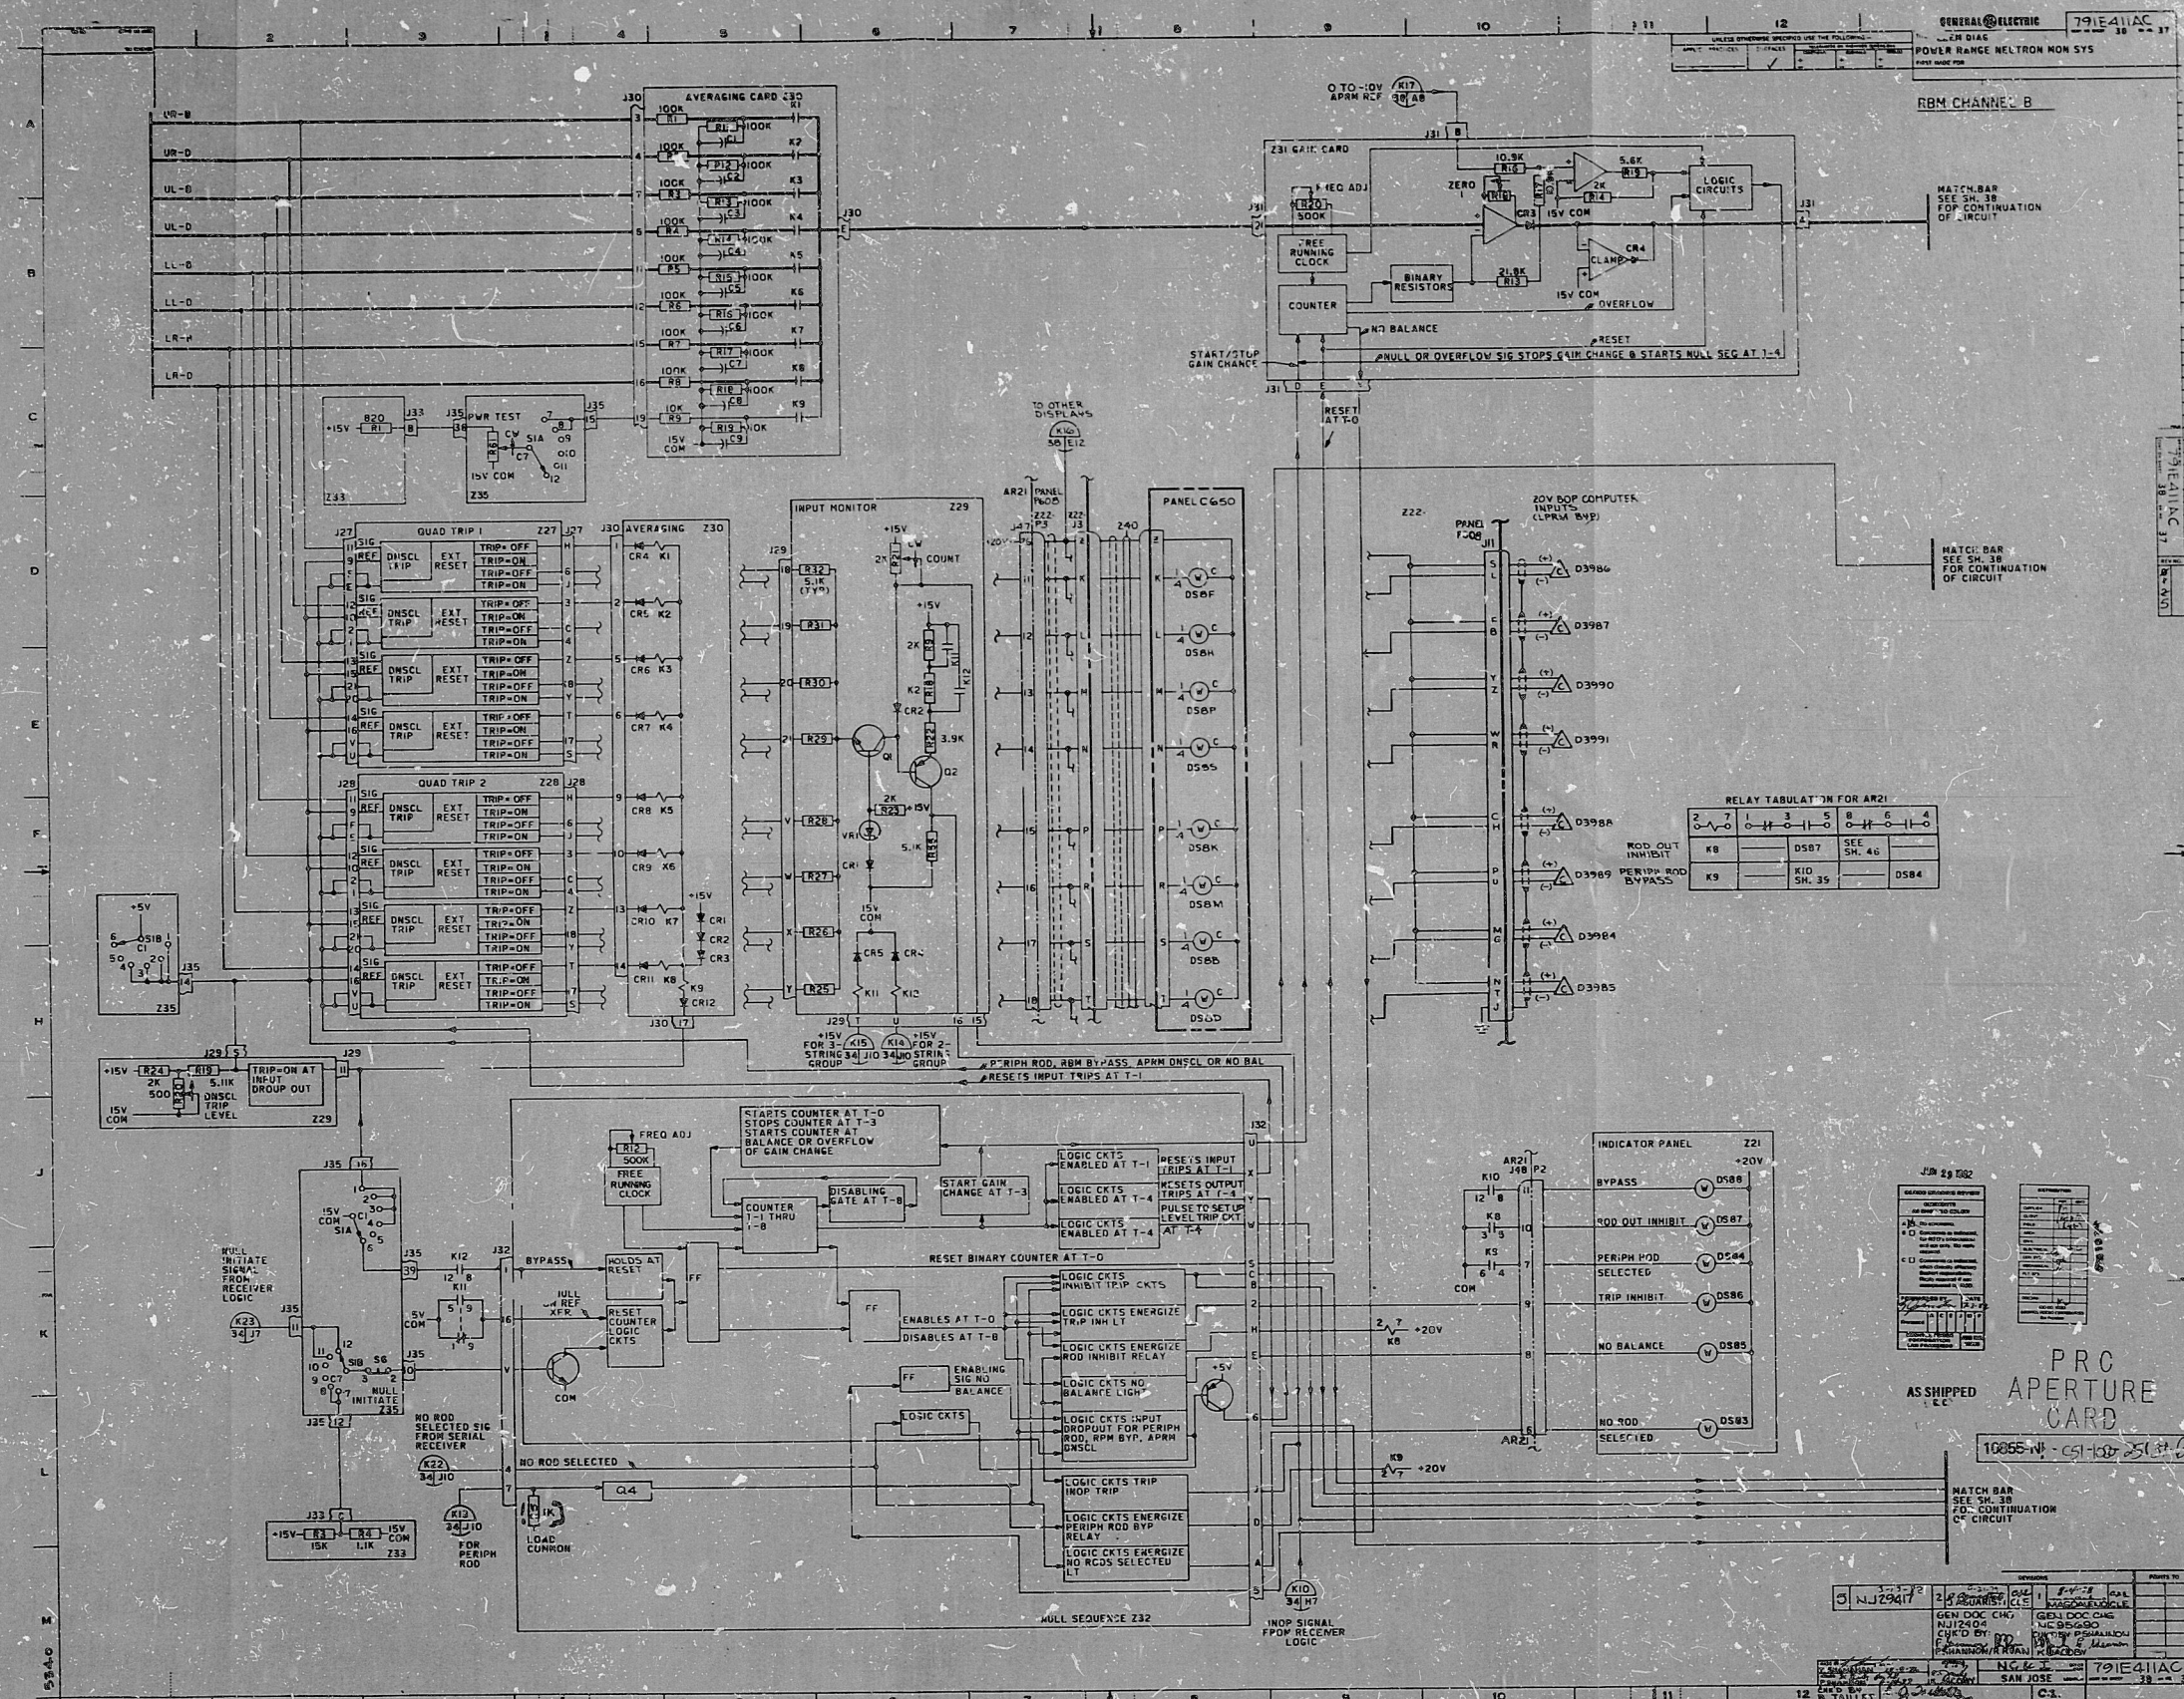



RIDS

8307290201

