


1. Fittings, Tubings, Piping, & Valves (Not part of a Safety Related Piping System, Etc.)

- a) 2FDLS5041
b). 2FDLS5051

NOTES:

1. Waive slope requirement.
2. Fittings, tubings, and valves designated on this Detail by classification 6s of the Fittings Classification List are safety class. Substitutes from other classifications are not permitted.
3. 2FDLS5040, 2FDLS5041, 2FDLS5050, 62FDLS5051 Are to be located near as possible to the floor.

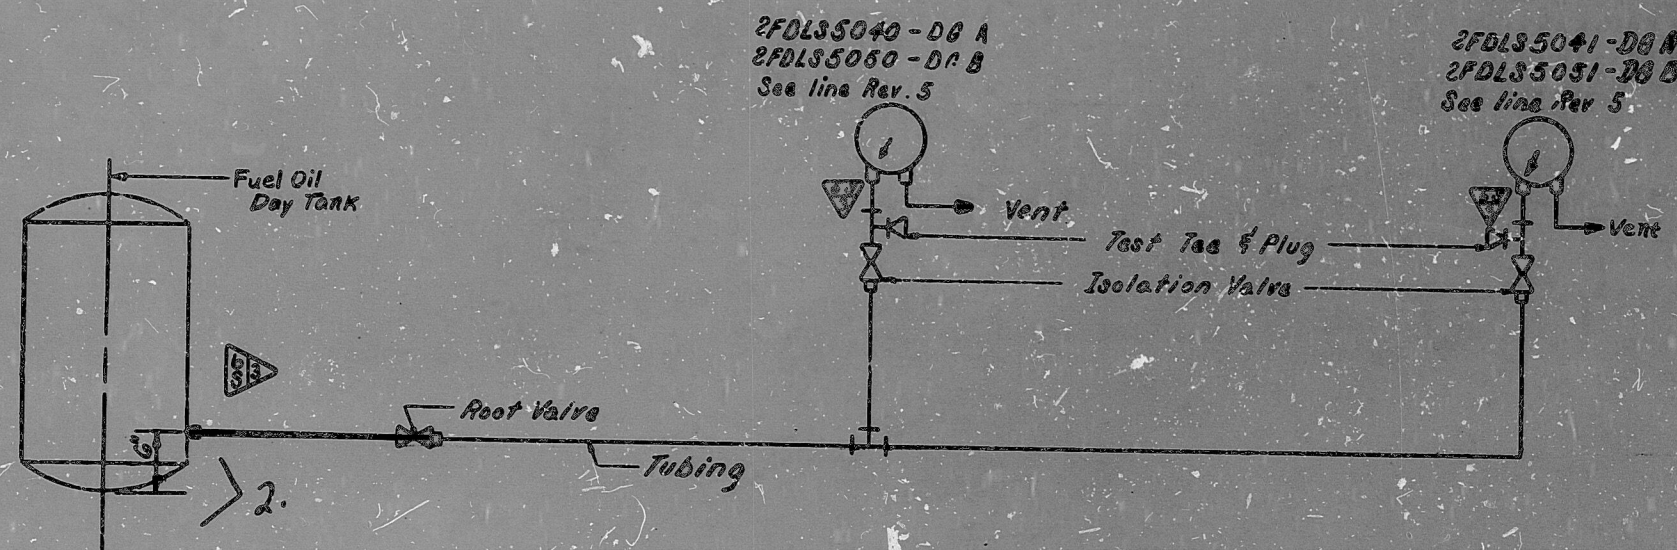

AS - BUILT
DATE 4-9-81

3/ QA CONDITION I
NUCLEAR SAFETY RELATED

(Except As Excluded Above)

FUNCTIONAL DESCRIPTION: (For "A" applies to "B")
2 FDL5040 and 2 FDL5041 monitor level in the D. G. Fuel Oil Day Tank and provide necessary controls and alarms. 2 FDL5040 starts fuel oil transfer pump on low tank level and stops pump on high level. 2 FDL5041 provides alarms on emergency high and low levels in the tank.

Rev. 2 as per AB-MIC-007

[illegible]

SI APERTURE CARD

FOR INFORMATION
ONLY

SHT 2
CL.3 HYDRO

8905190270

PDR RIDS

