


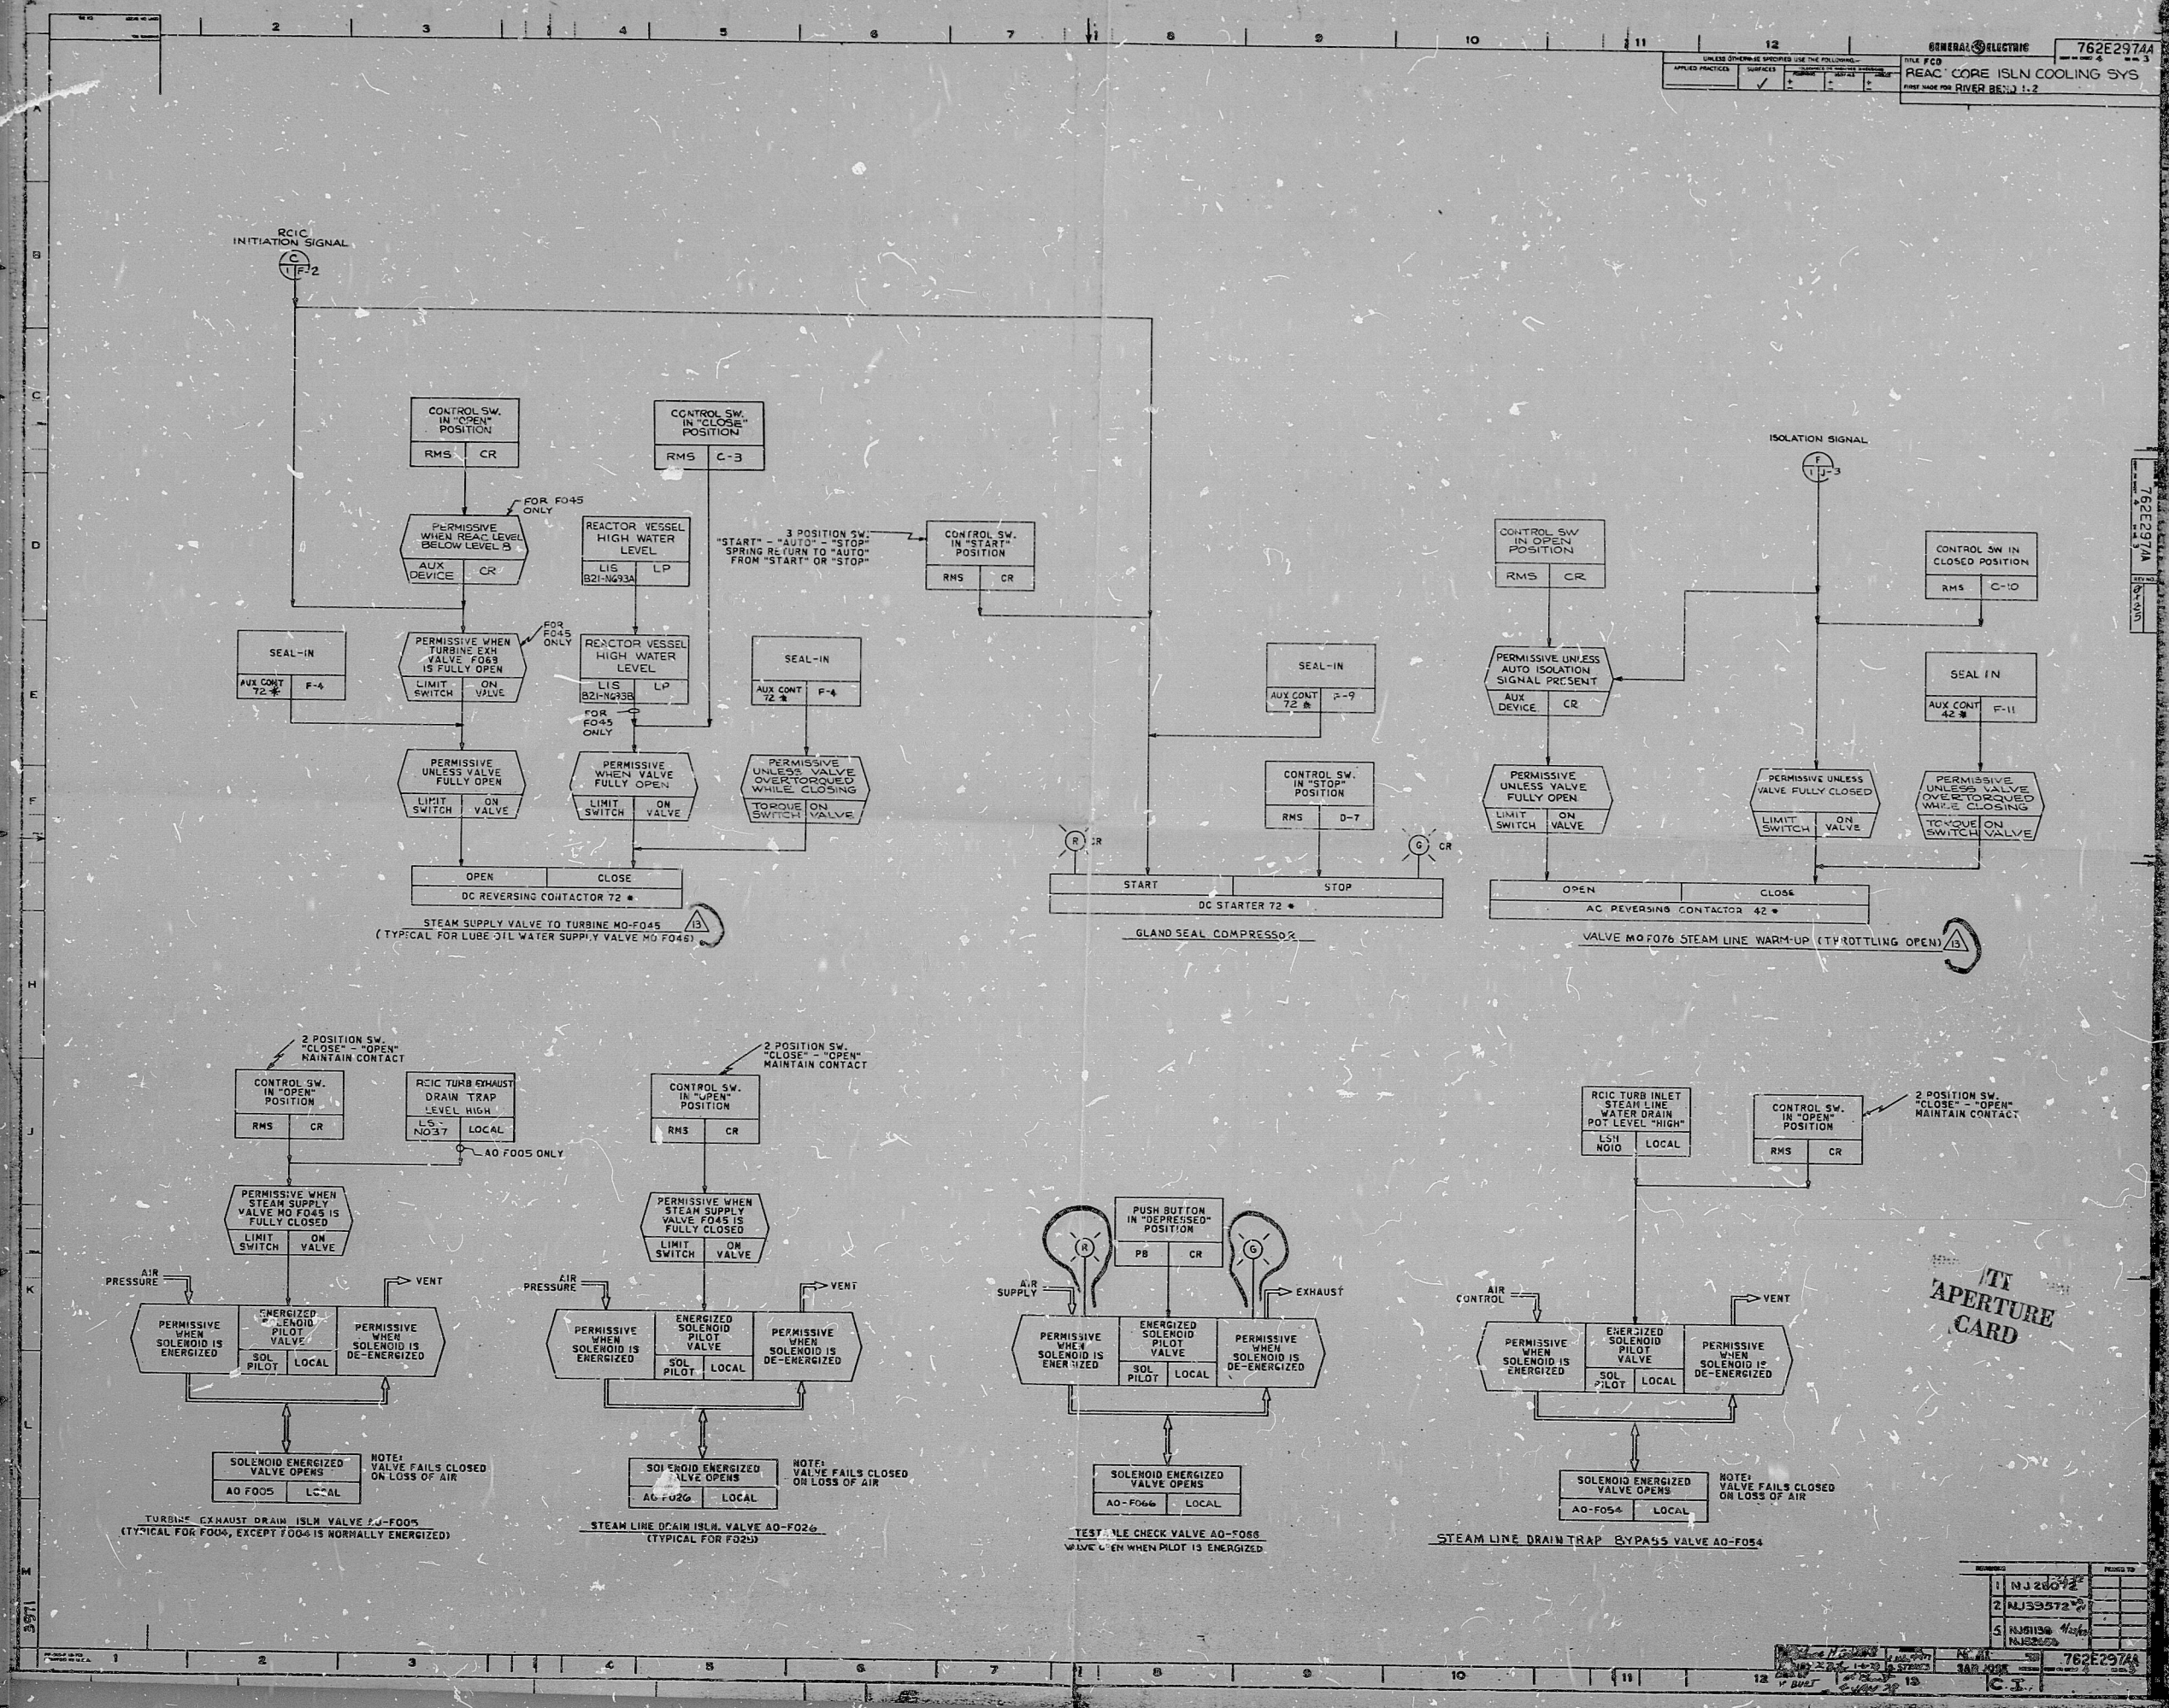

IT
 APERTURE
 CARD

8412200410

PDR RIDS

