


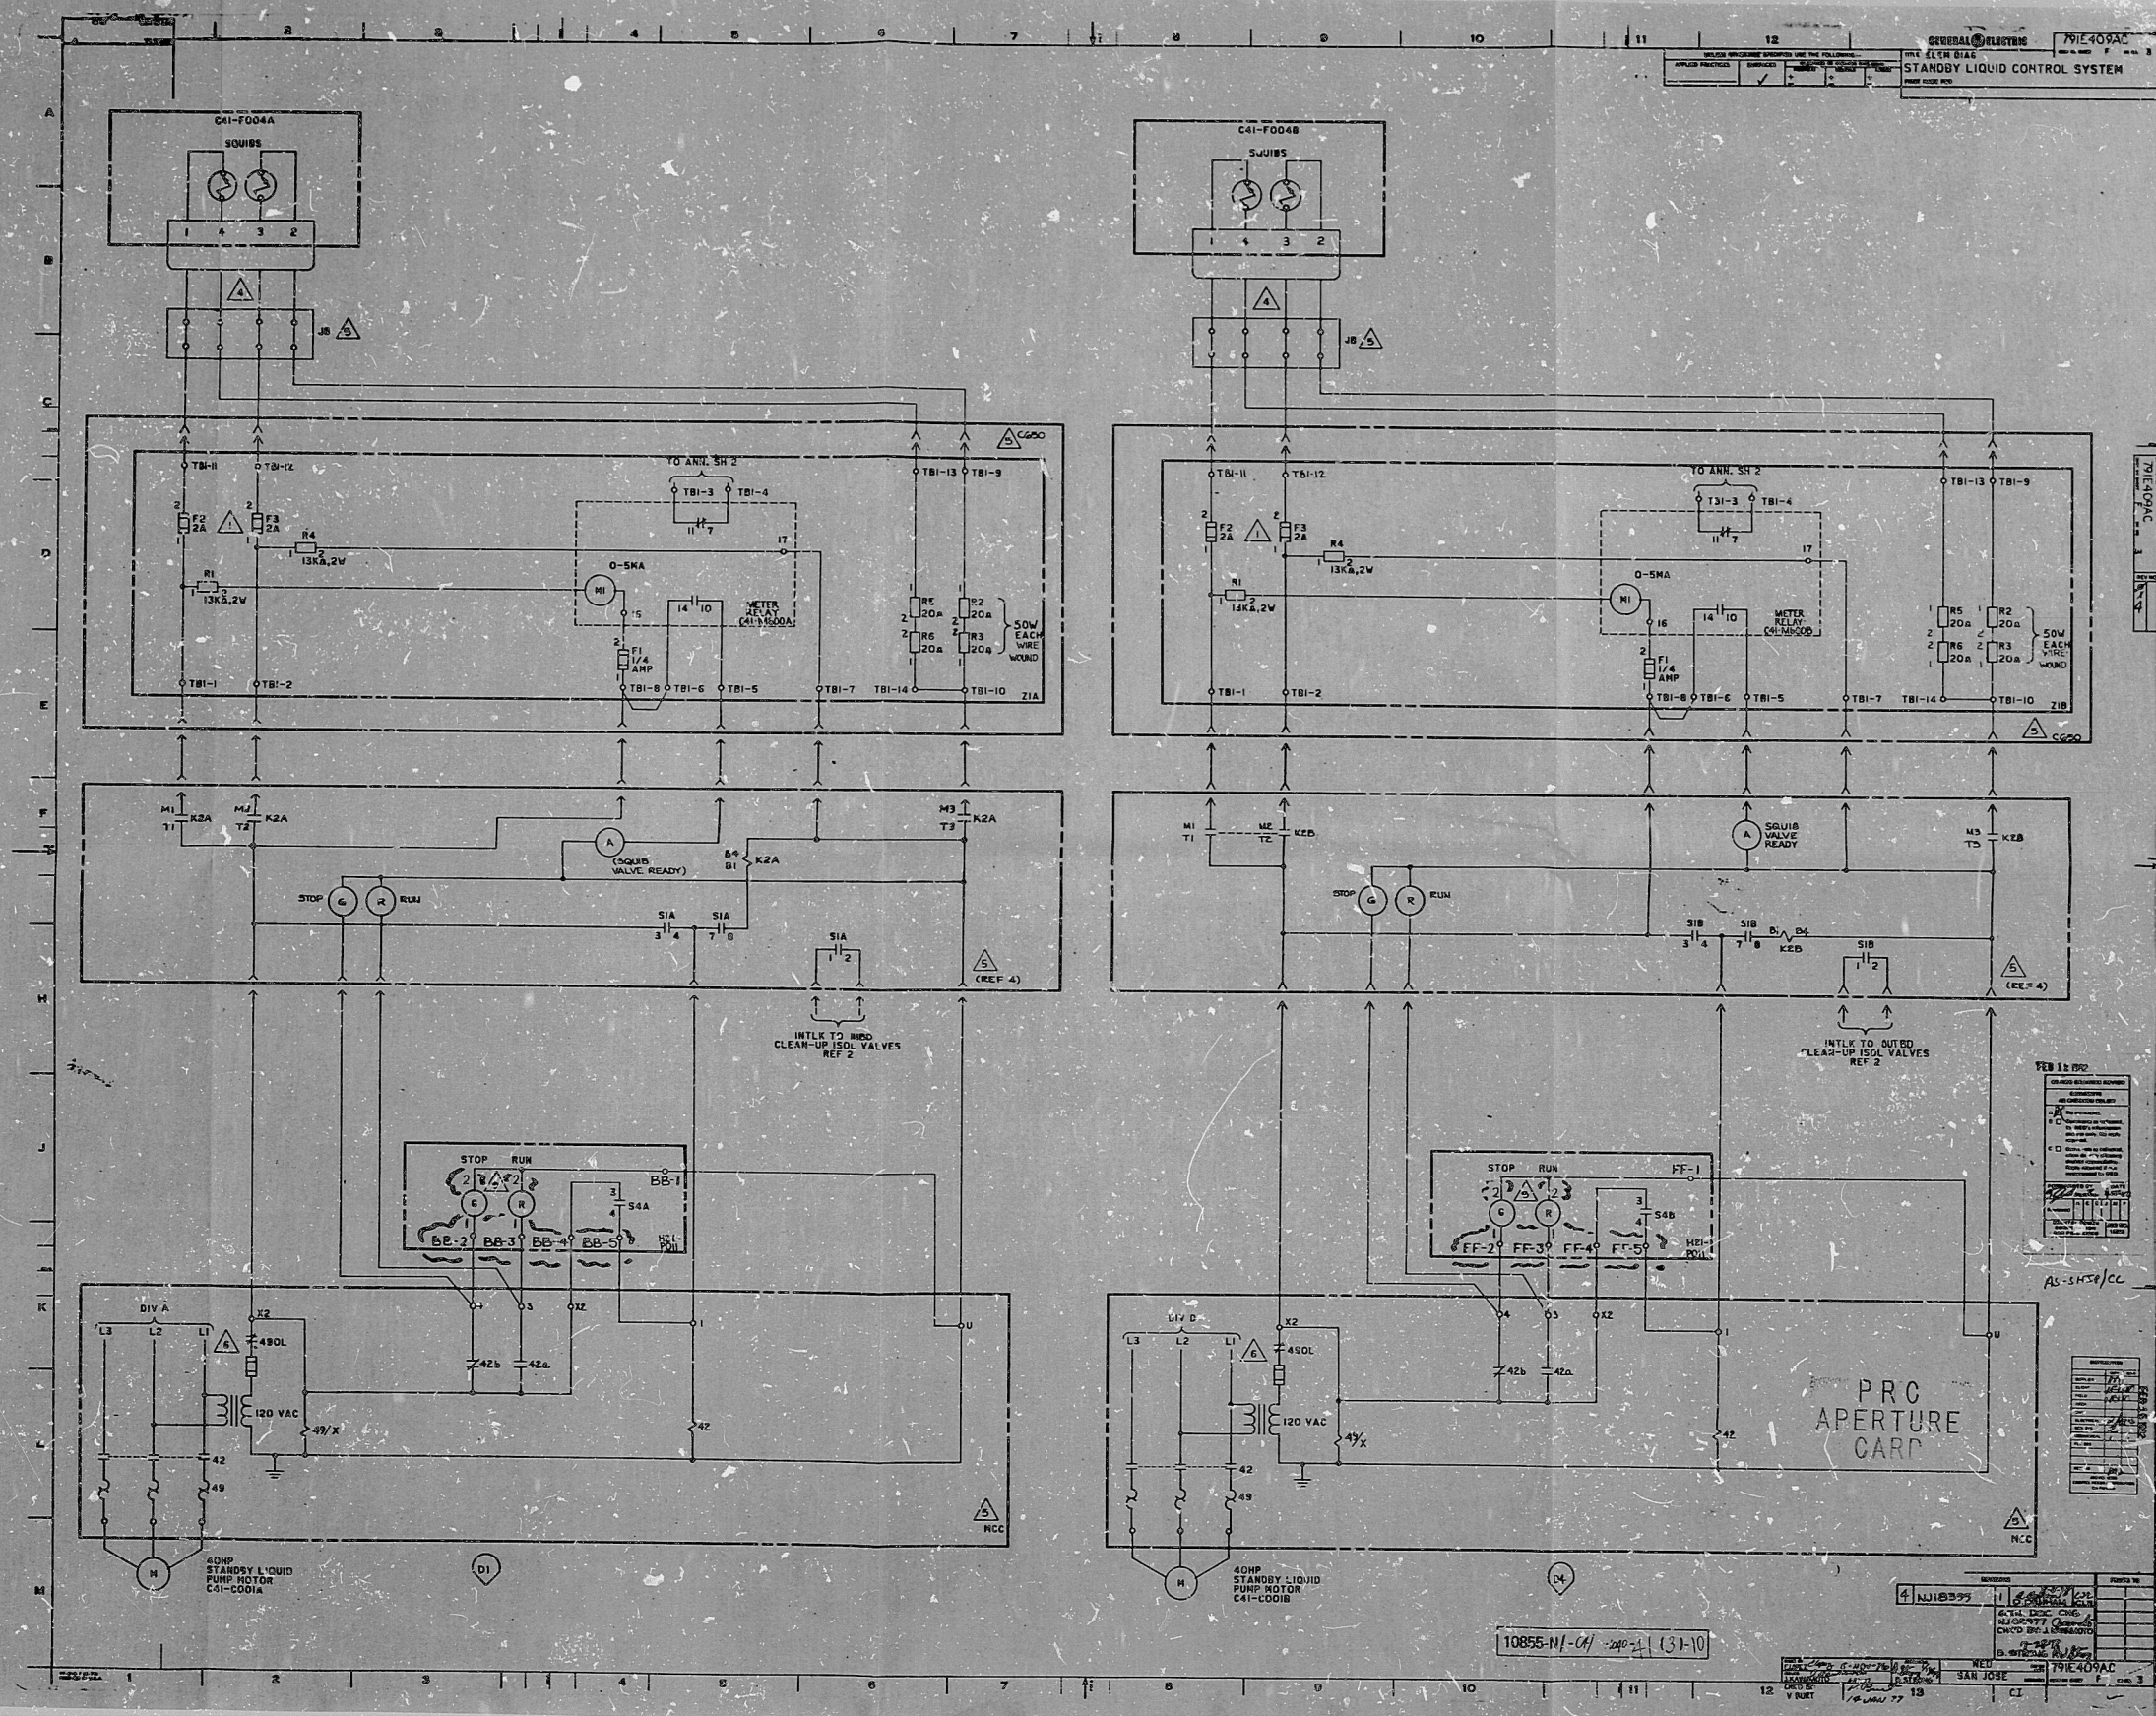

RIDS

8307290253

