


2	7-30-81	INC'DOM 12 (DEL CAB, ICTWINS 8, 2, 6, 11, 15, 18) DEL CAB, (CERTIFICATION OF COMPTON, 13, 15, 16, 17,
---	---------	---

ADAPTER TABLE						
SCHEME NO.	OTSG LEVEL HI-HI			LOCATIONS		S.U. DESIG.
	RELAY	SCHEME	DWG. NO.			
1CFW115	1LYHH-3875ACI	1CI066	J-338(S)SH-40	1C166	1C47	1-ALA
2CFW115	2LYHH-3975ACI	2CI069	J-337(S)SH-40	2C166	2C47	2-ALA

DEVICE TABLE
 ILYHH,3875ACI : OTSG HI-HI LEVEL INTL'K RELAY (FOXBORO)

ANNUNCIATOR & COMP. AUX. CIRCUIT
SCHEME 1CFW 115
S.U. DESIG. 1-ALA

TERA
APERTURE
CARD

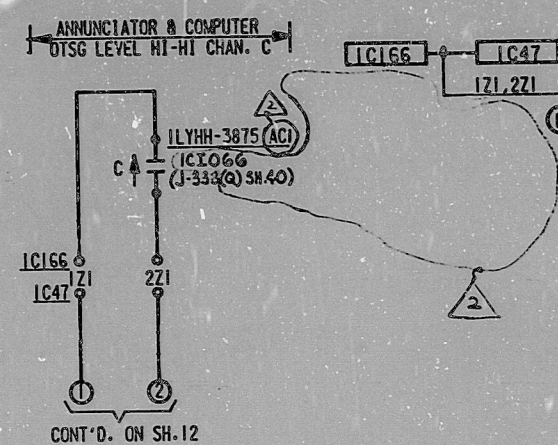

REFERENCE
LOGIC DIAGRAM J-133

BECHTEL ANN ARBOR, MICHIGAN			
MIDLAND PLANT UNITS 1 & 2 CONSUMERS POWER COMPANY			
SCHEMATIC DIAGRAM MOTOR DRIVEN AUX. FW PUMP			
	JOB No.	DRAWING No.	REV.
	7220	E-151(1) SH.9	2

I certify that the image contained on this frame was made in the normal and regular course of business, on the date stated below and that it is an accurate reproduction of the document submitted to reprographes.

8-14-81 DATE
Fred S. Roberts
CAMERA OPERATOR
Superior of
Superior of

0000

RIDS

811280517

