


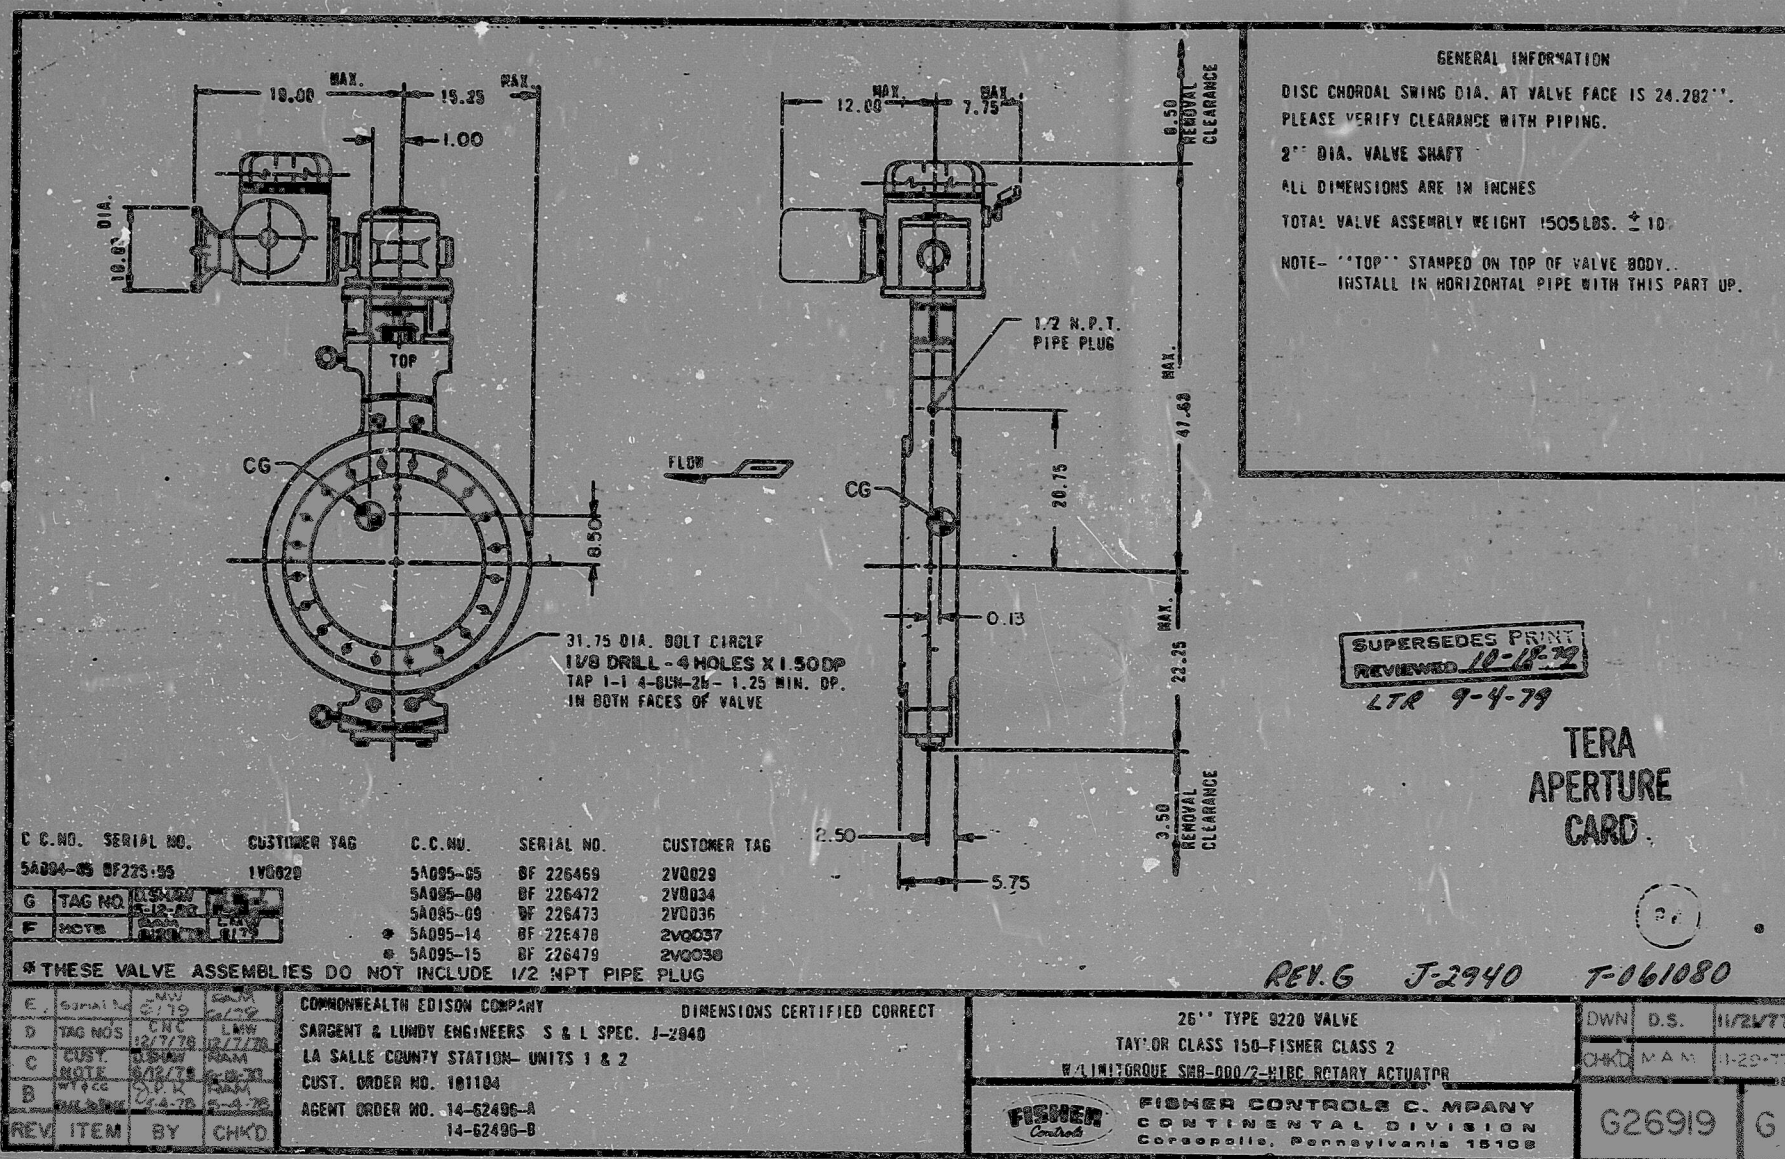

REVIEWED FOR
LA SALLE COUNTY STATION
UNITS 1 & 2
COMMONWEALTH EDISON CO.
SARGENT & LUNDY
ENGINEERS

1. ☒ NO EXCEPTION TAKEN. CONTRACTOR
MAY PROCEED WITH FABRICATION OR
CONSTRUCTION IN ACCORDANCE
WITH SPECIFICATION.

2. ☐ CONTRACTOR MAY PROCEED IN
ACCORDANCE WITH SPECIFICATION
BASED UPON REVISING DRAWINGS
AND RESUBMITAL.

3. ☐ REVISE AS NOTED AND RESUBMIT.
HOLD FABRICATION.

ANY ACTION SHOWN ABOVE IS
SUBJECT TO THE TERMS OF THE
CONTRACT, AND DOES NOT RELIEVE
CONTRACTOR FROM HIS OBLIGA-
TIONS UNDER THE CONTRACT,
INCLUDING DESIGN AND DETAILING.

FOR EQUIPMENT NO. **SEE DWG**
BY J. Z. WIGGINS DATE **7-17-80**
SPEC NO. **J-2940** PROJ. NO. **4256**

8201050317

RIDS

8201050317

