


This drawing and the design it covers are the property of BECHTEL. They are loaned to the borrower's use only and are not to be reproduced, copied, loaned, exhibited, or used in any way except in the limited way and under the conditions permitted by the license to the borrower.

REV.	DATE	REVISION
1	11-5-80	REVISED AS INDICATED
2	1-15-74	REVISED AS INDICATED
3	8-29-75	ISSUED FOR CONSTRUCTION

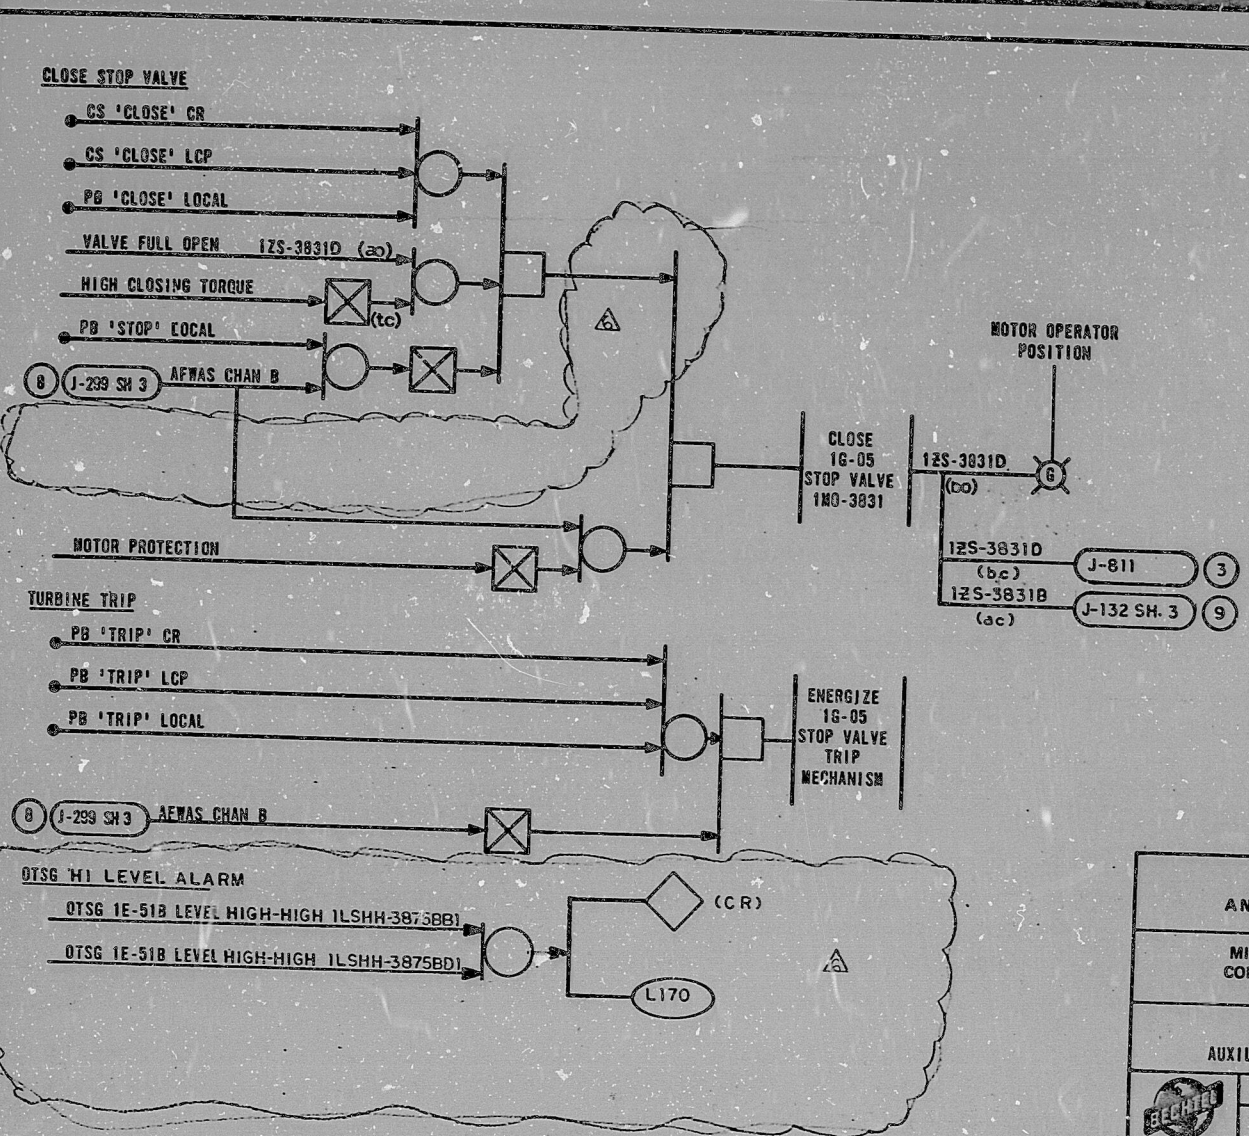

TERA
APERTURE
CARD

BECHTEL ANN ARBOR, MICHIGAN		
MIDLAND PLANT UNITS 1 & 2 CONSUMERS POWER COMPANY		
LOGIC DIAGRAM AUXILIARY FEEDWATER PUMP-TURBINE		
JOB No.	DRAWING No.	REV.
7220	J-132(1) SH. 2	6

I certify that the image contained on this frame was made in the normal and regular course of business, on the date stated below and that it is an accurate reproduction of the document submitted to reprographics.

11-5-80
DATE
C-1348

Diandra
CAMERA OPERATOR

[Signature]
SUPERVISOR OF
REPROGRAPHICS

16X

RIDS

820110225

