


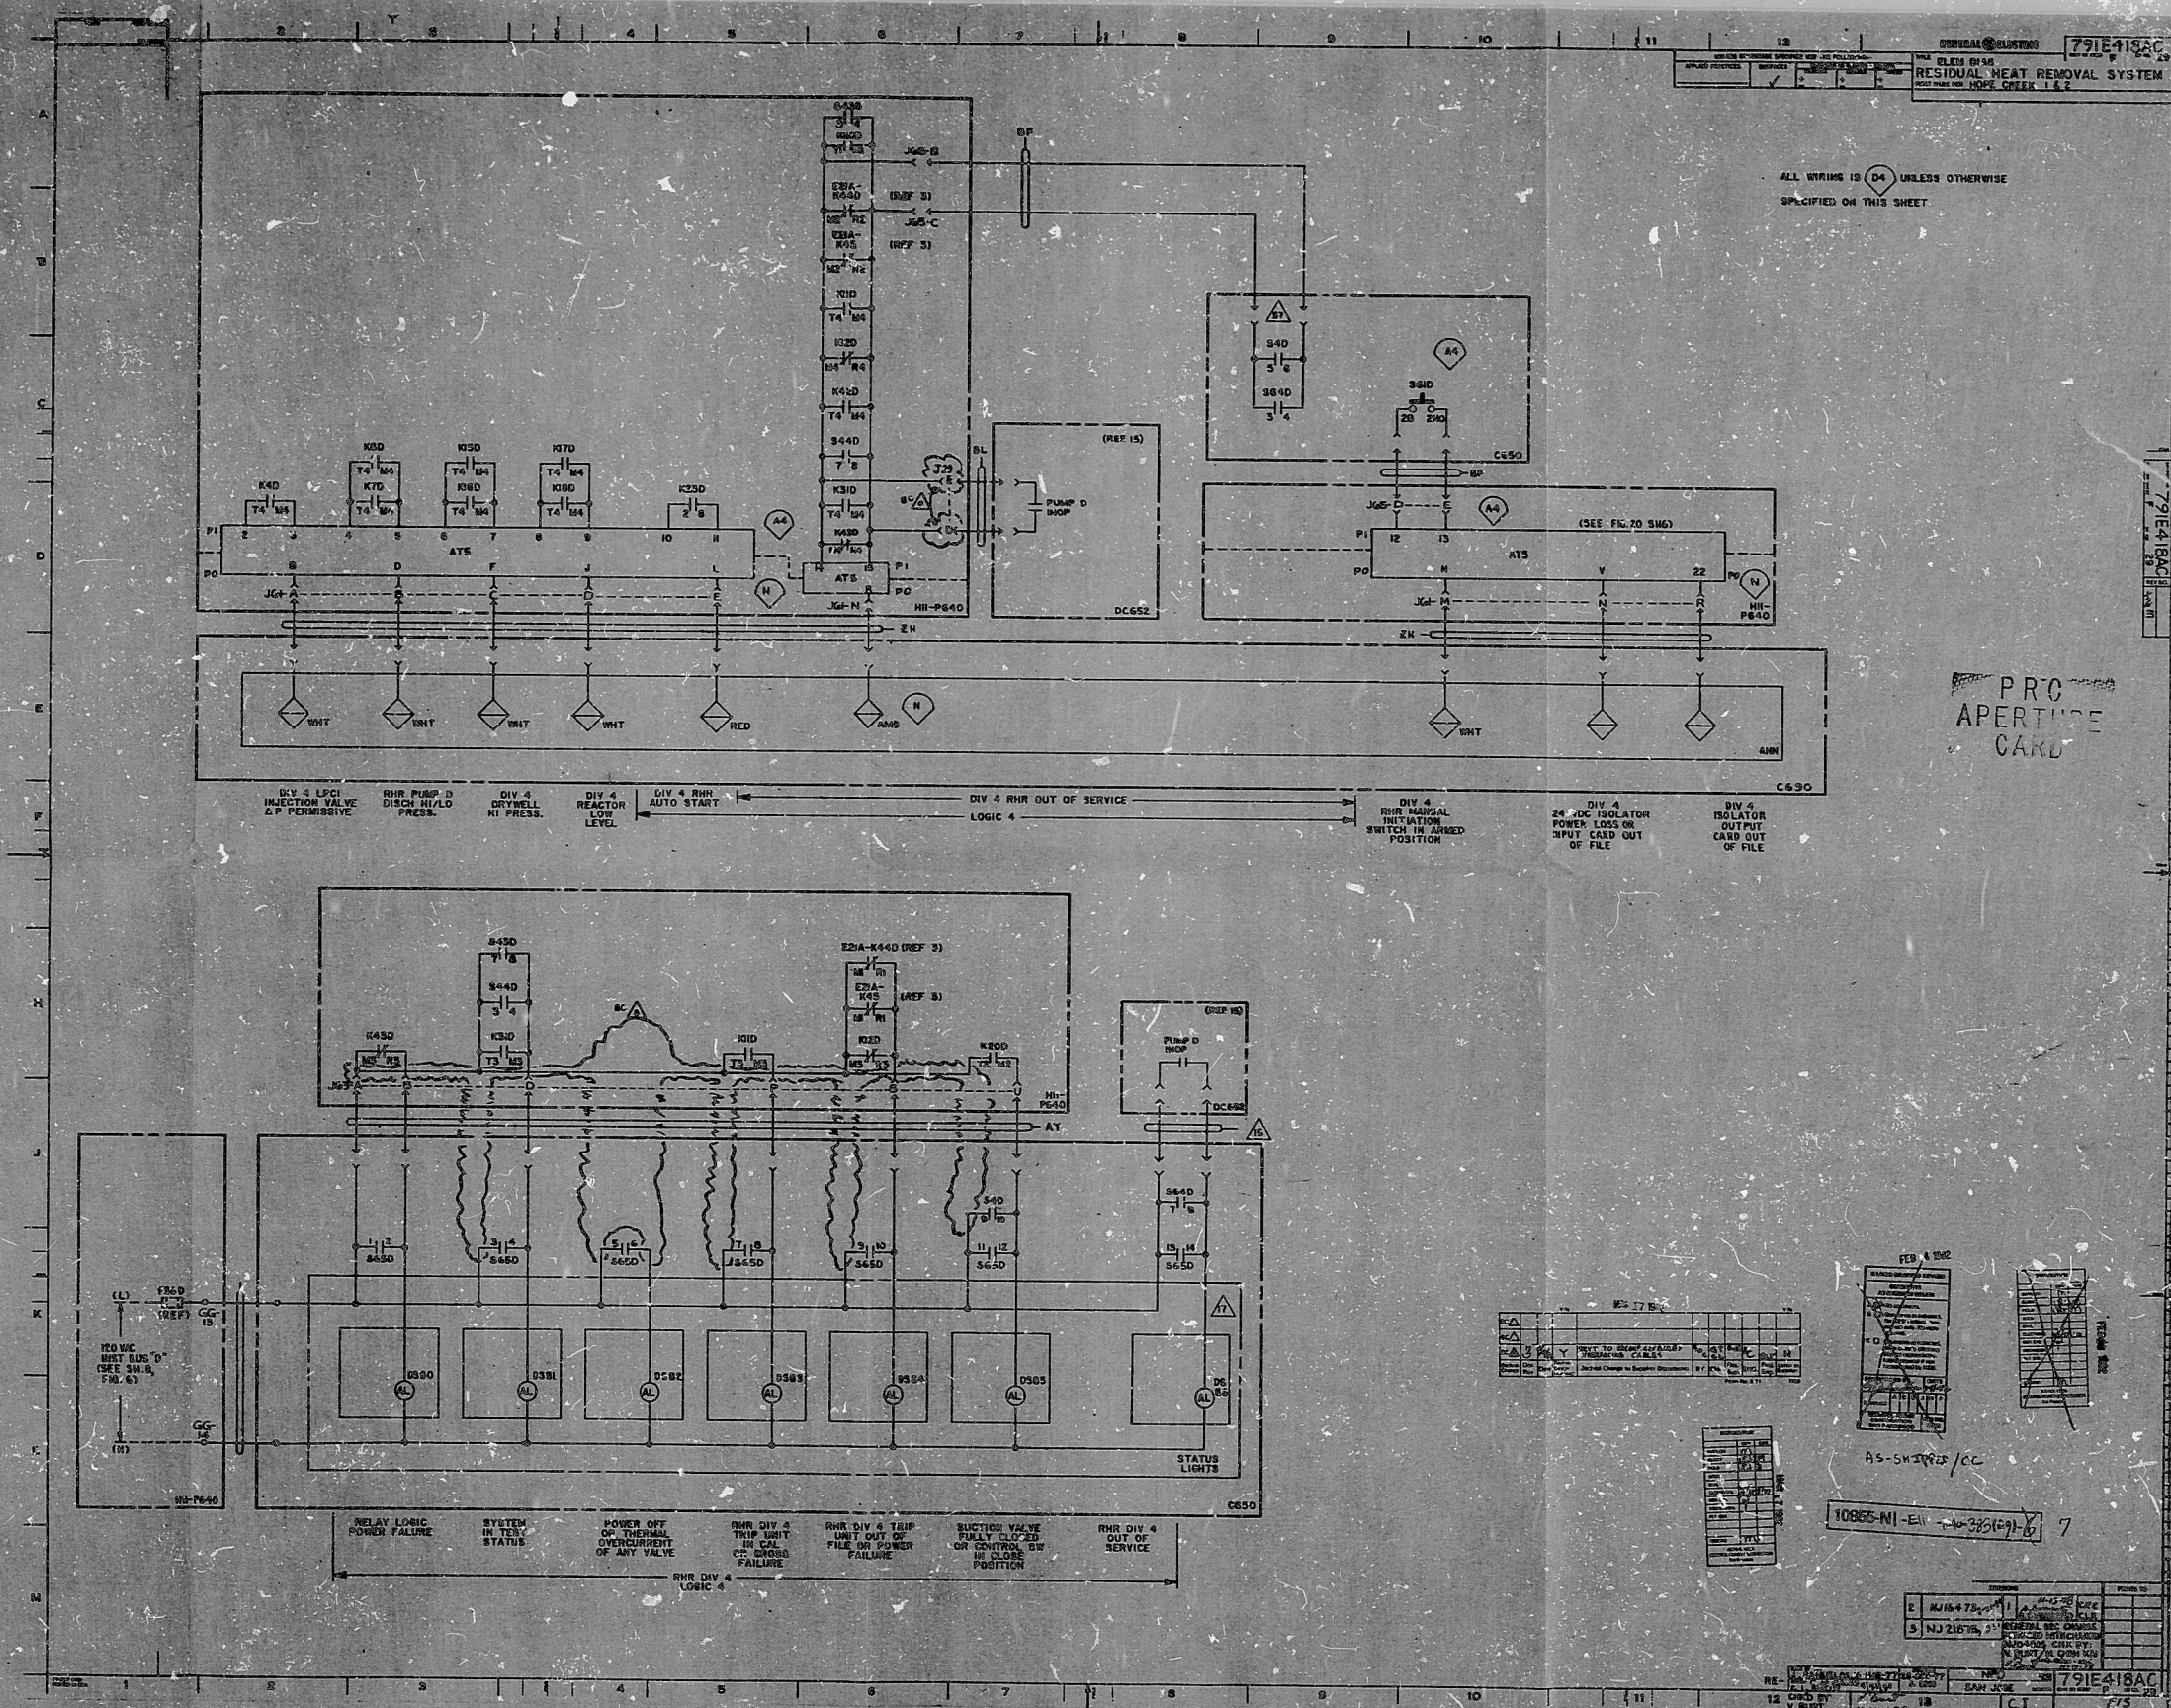

PRC
APERTURE
CARD

RIDS

8308010170

