


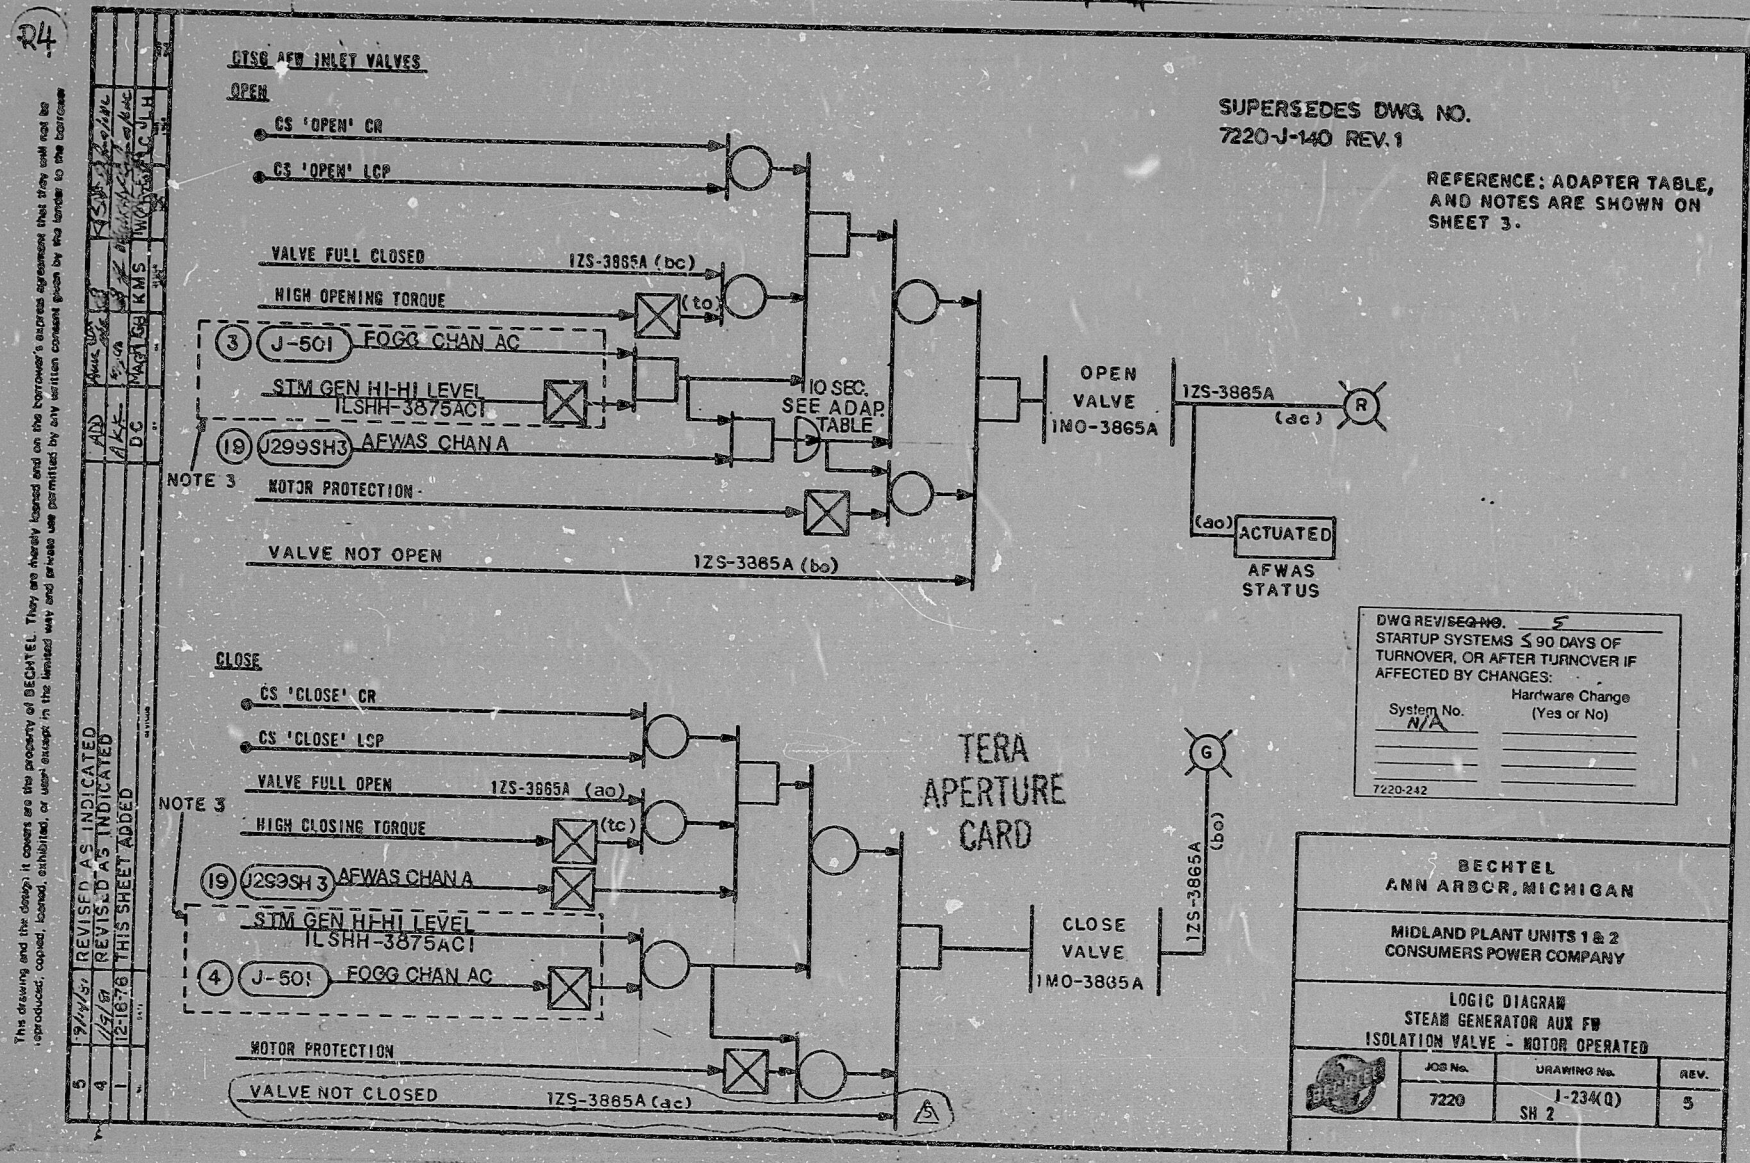

I certify that the image contained on this frame was made in the normal and regular course of business, on the date stated below and that it is an accurate reproduction of the document submitted to reprographics.

16X

9-1781
DATE
R. Campbell
CAMERA OPERATOR
SUPERVISOR OF REPROGRAPHICS

G-1348

RIDS

822110248

