


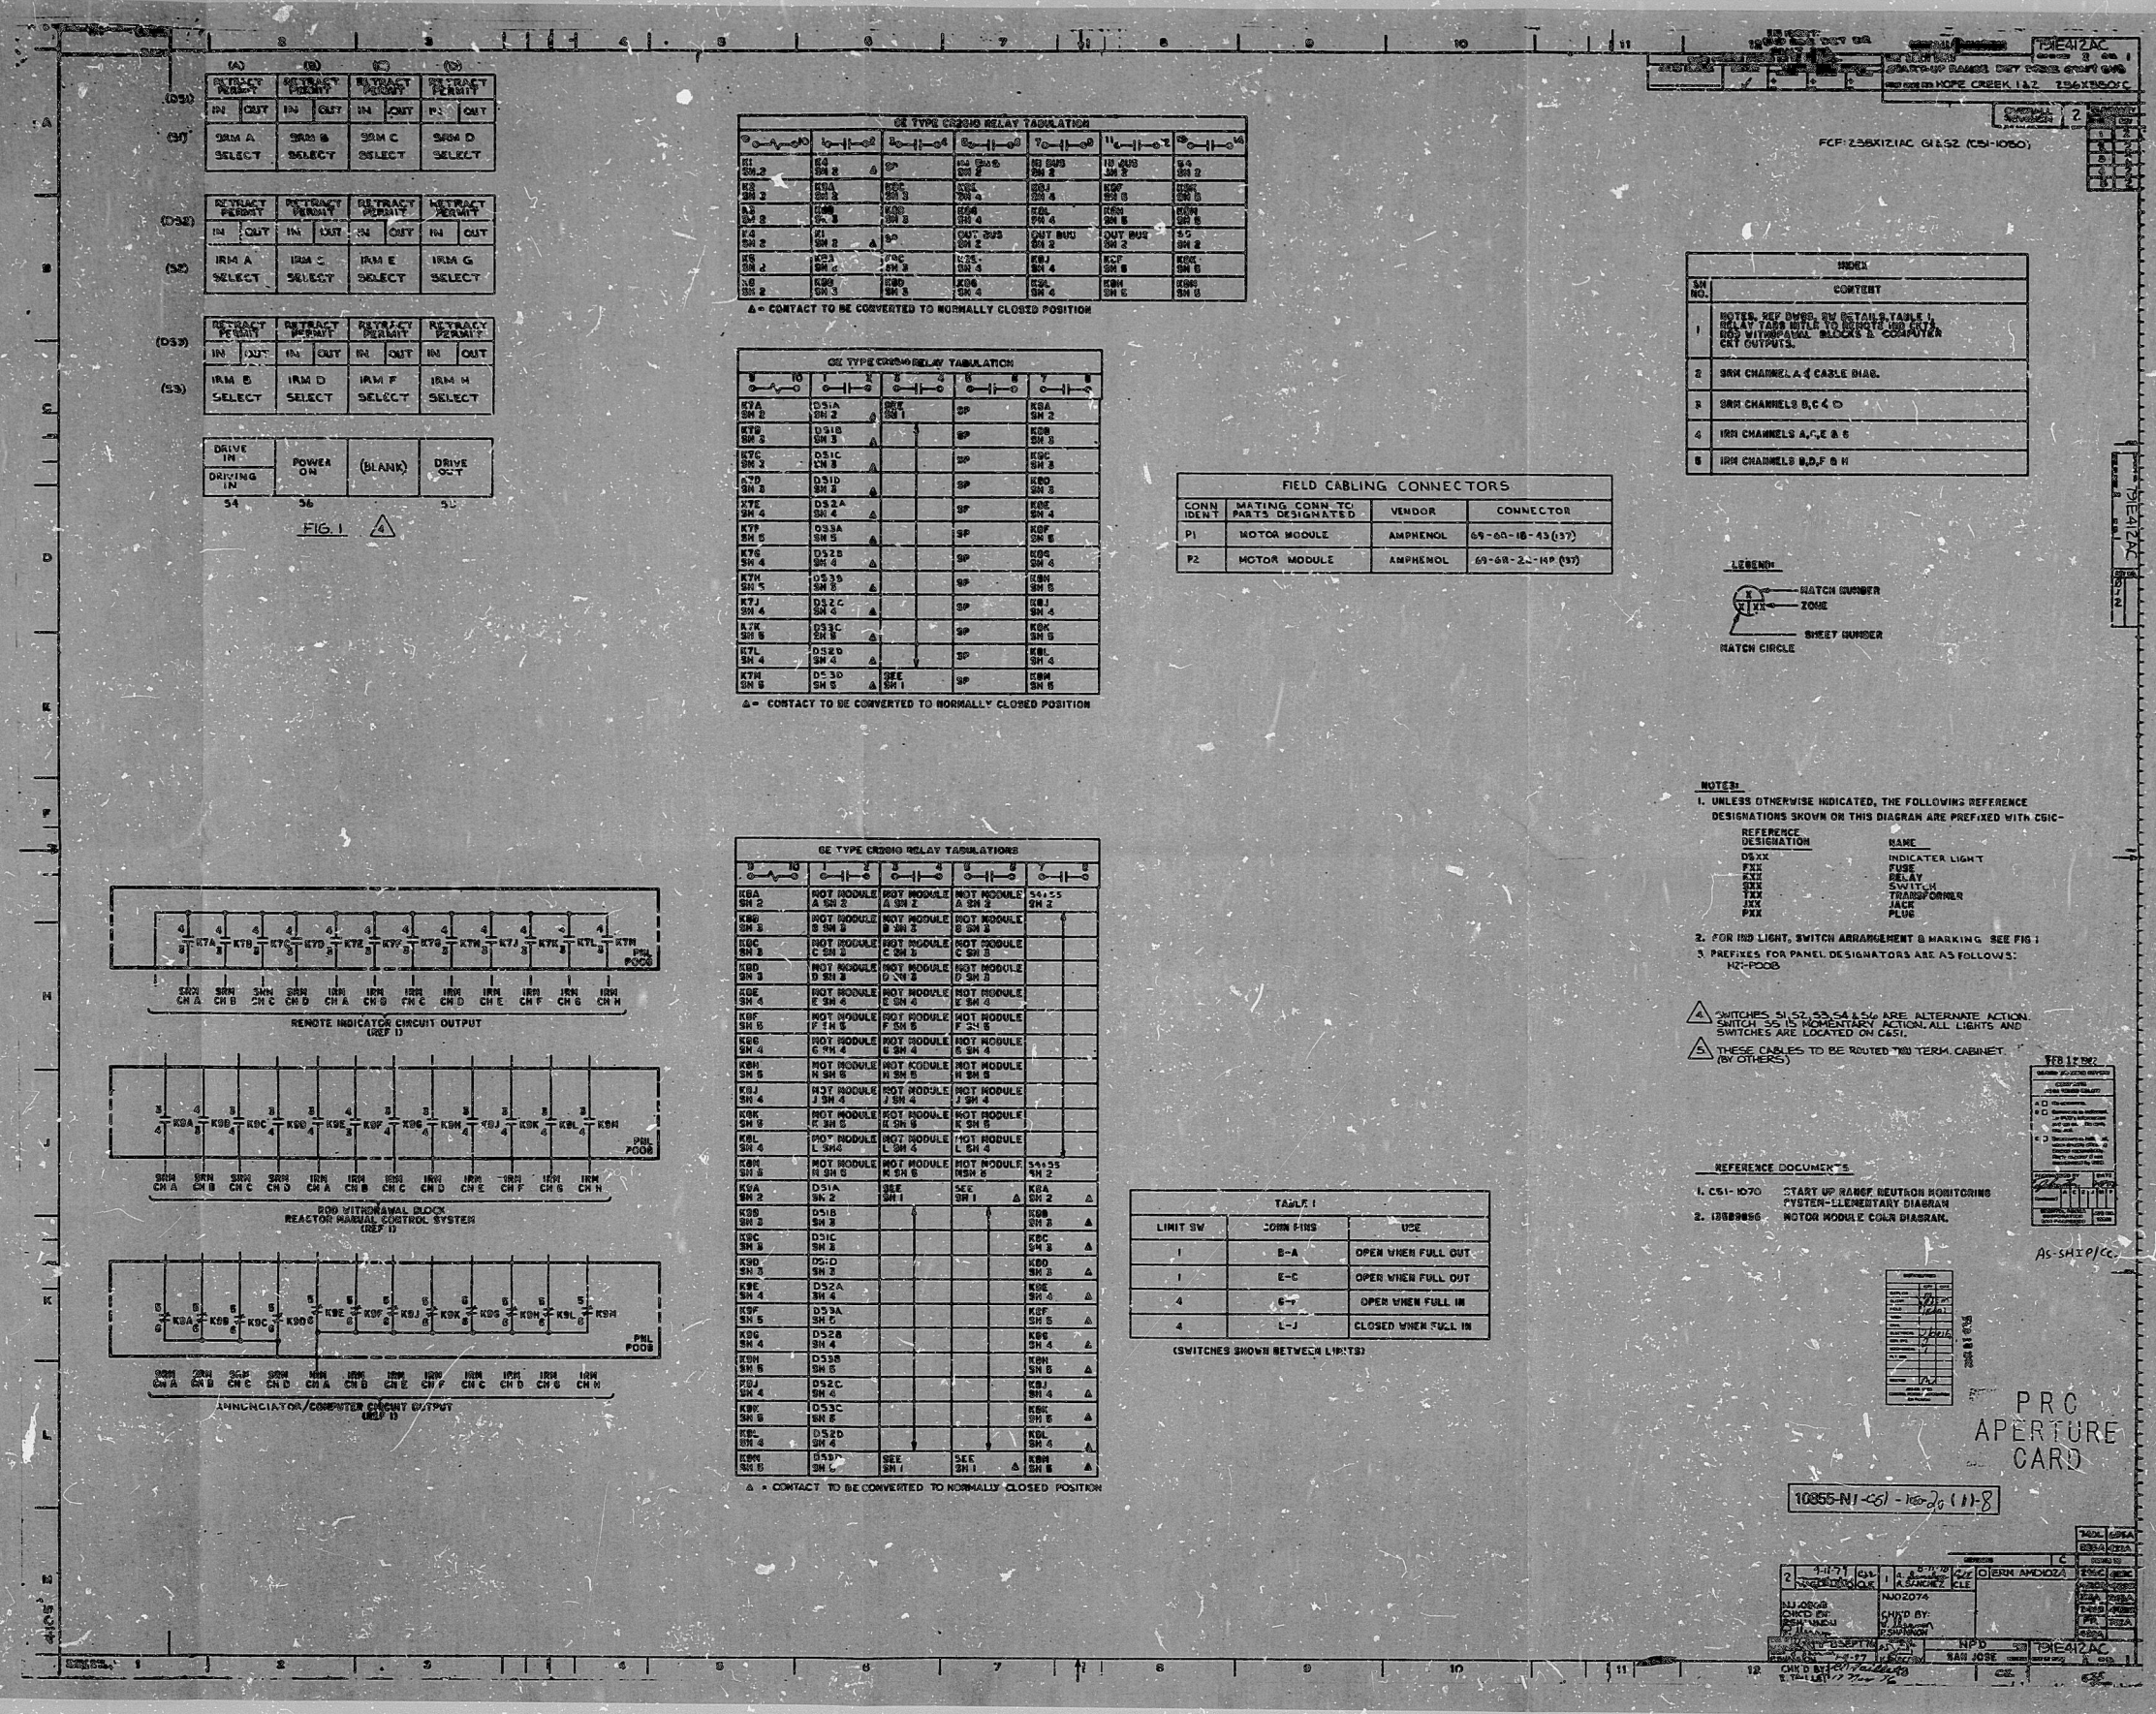

(A)		(B)		(C)		(D)	
RETRACT PERMIT	IN	RETRACT PERMIT	IN	RETRACT PERMIT	IN	RETRACT PERMIT	IN
SELECT	OUT	SELECT	OUT	SELECT	OUT	SELECT	OUT
IRM A		IRM B		IRM C		IRM D	
SELECT		SELECT		SELECT		SELECT	

GE TYPE CR200 RELAY TABULATION											

GE TYPE CR200 RELAY TABULATION											

FIELD CABLEING CONNECTORS			
CONN IDENT	MATING CONN TO PARTS DESIGNATED	VENDOR	CONNECTOR
P1	MOTOR MODULE	AMPHENOL	69-68-1B-43 (37)
P2	MOTOR MODULE	AMPHENOL	69-68-2A-14P (37)

INDEX	
NO.	CONTENT
1	NOTES, SEE DMS, CH 15, TABLE 1, RELAY TAPING TO REACTOR AND MOTOR CMT OUTPUTS.
4	IRM CHANNELS A, C, E & G
5	IRM CHANNELS B, C, F & H


LEGEND:
HATCH NUMBER
ZONE
SHEET NUMBER
HATCH CIRCLE

NOTES:
1. UNLESS OTHERWISE INDICATED, THE FOLLOWING REFERENCE DESIGNATIONS SHOWN ON THIS DIAGRAM ARE PREFIXED WITH CHIC-
REFERENCE DESIGNATION NAME
DSXX INDICATOR LIGHT
FXX FUSE
SXX SWITCH
TXX TRANSFORMER
PXX PLATE
2. FOR IND LIGHT, SWITCH ARRANGEMENT & MARKING, SEE FIG. 1
3. PREFIXES FOR PANEL DESIGNATORS ARE AS FOLLOWS:
H2-PODS

REFERENCE DOCUMENTS:
1. C61-1070 START UP RAMP, NEUTRON MONITORING SYSTEM-ELEMENTARY DIAGRAM
2. 10089866 MOTOR MODULE CABLE DIAGRAM

TABLE 1		
LIMIT SW	COIN FINS	USE
1	B-A	OPEN WHEN FULL OUT
1	E-C	OPEN WHEN FULL IN
4	L-J	CLOSED WHEN FULL IN

(SWITCHES SHOWN BETWEEN LIMITS)

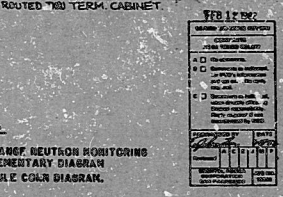

PRC APERTURE CARD

10855-N1-451-10-20 (1)-8

RIDS

8308010196

