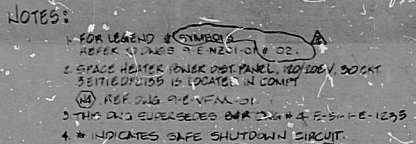


[illegible]

TI
APERTURE
CARD

BECHTEL ENERGY CORPORATION
HOUSTON, TEXAS

USTON LIGHTING & POWER CO.
SOUTH TEXAS PROJECT

NUCLEAR SAFETY RELATED		10
SINGLE LINE DIAGRAM		
480V CLASS-IE MOTOR CONTROL CENTER		
EICI		(EAB)
DATE	REV.	DATE
NONE	14926	9-E-PMAG-01

8501160089

PDR RIDS

