


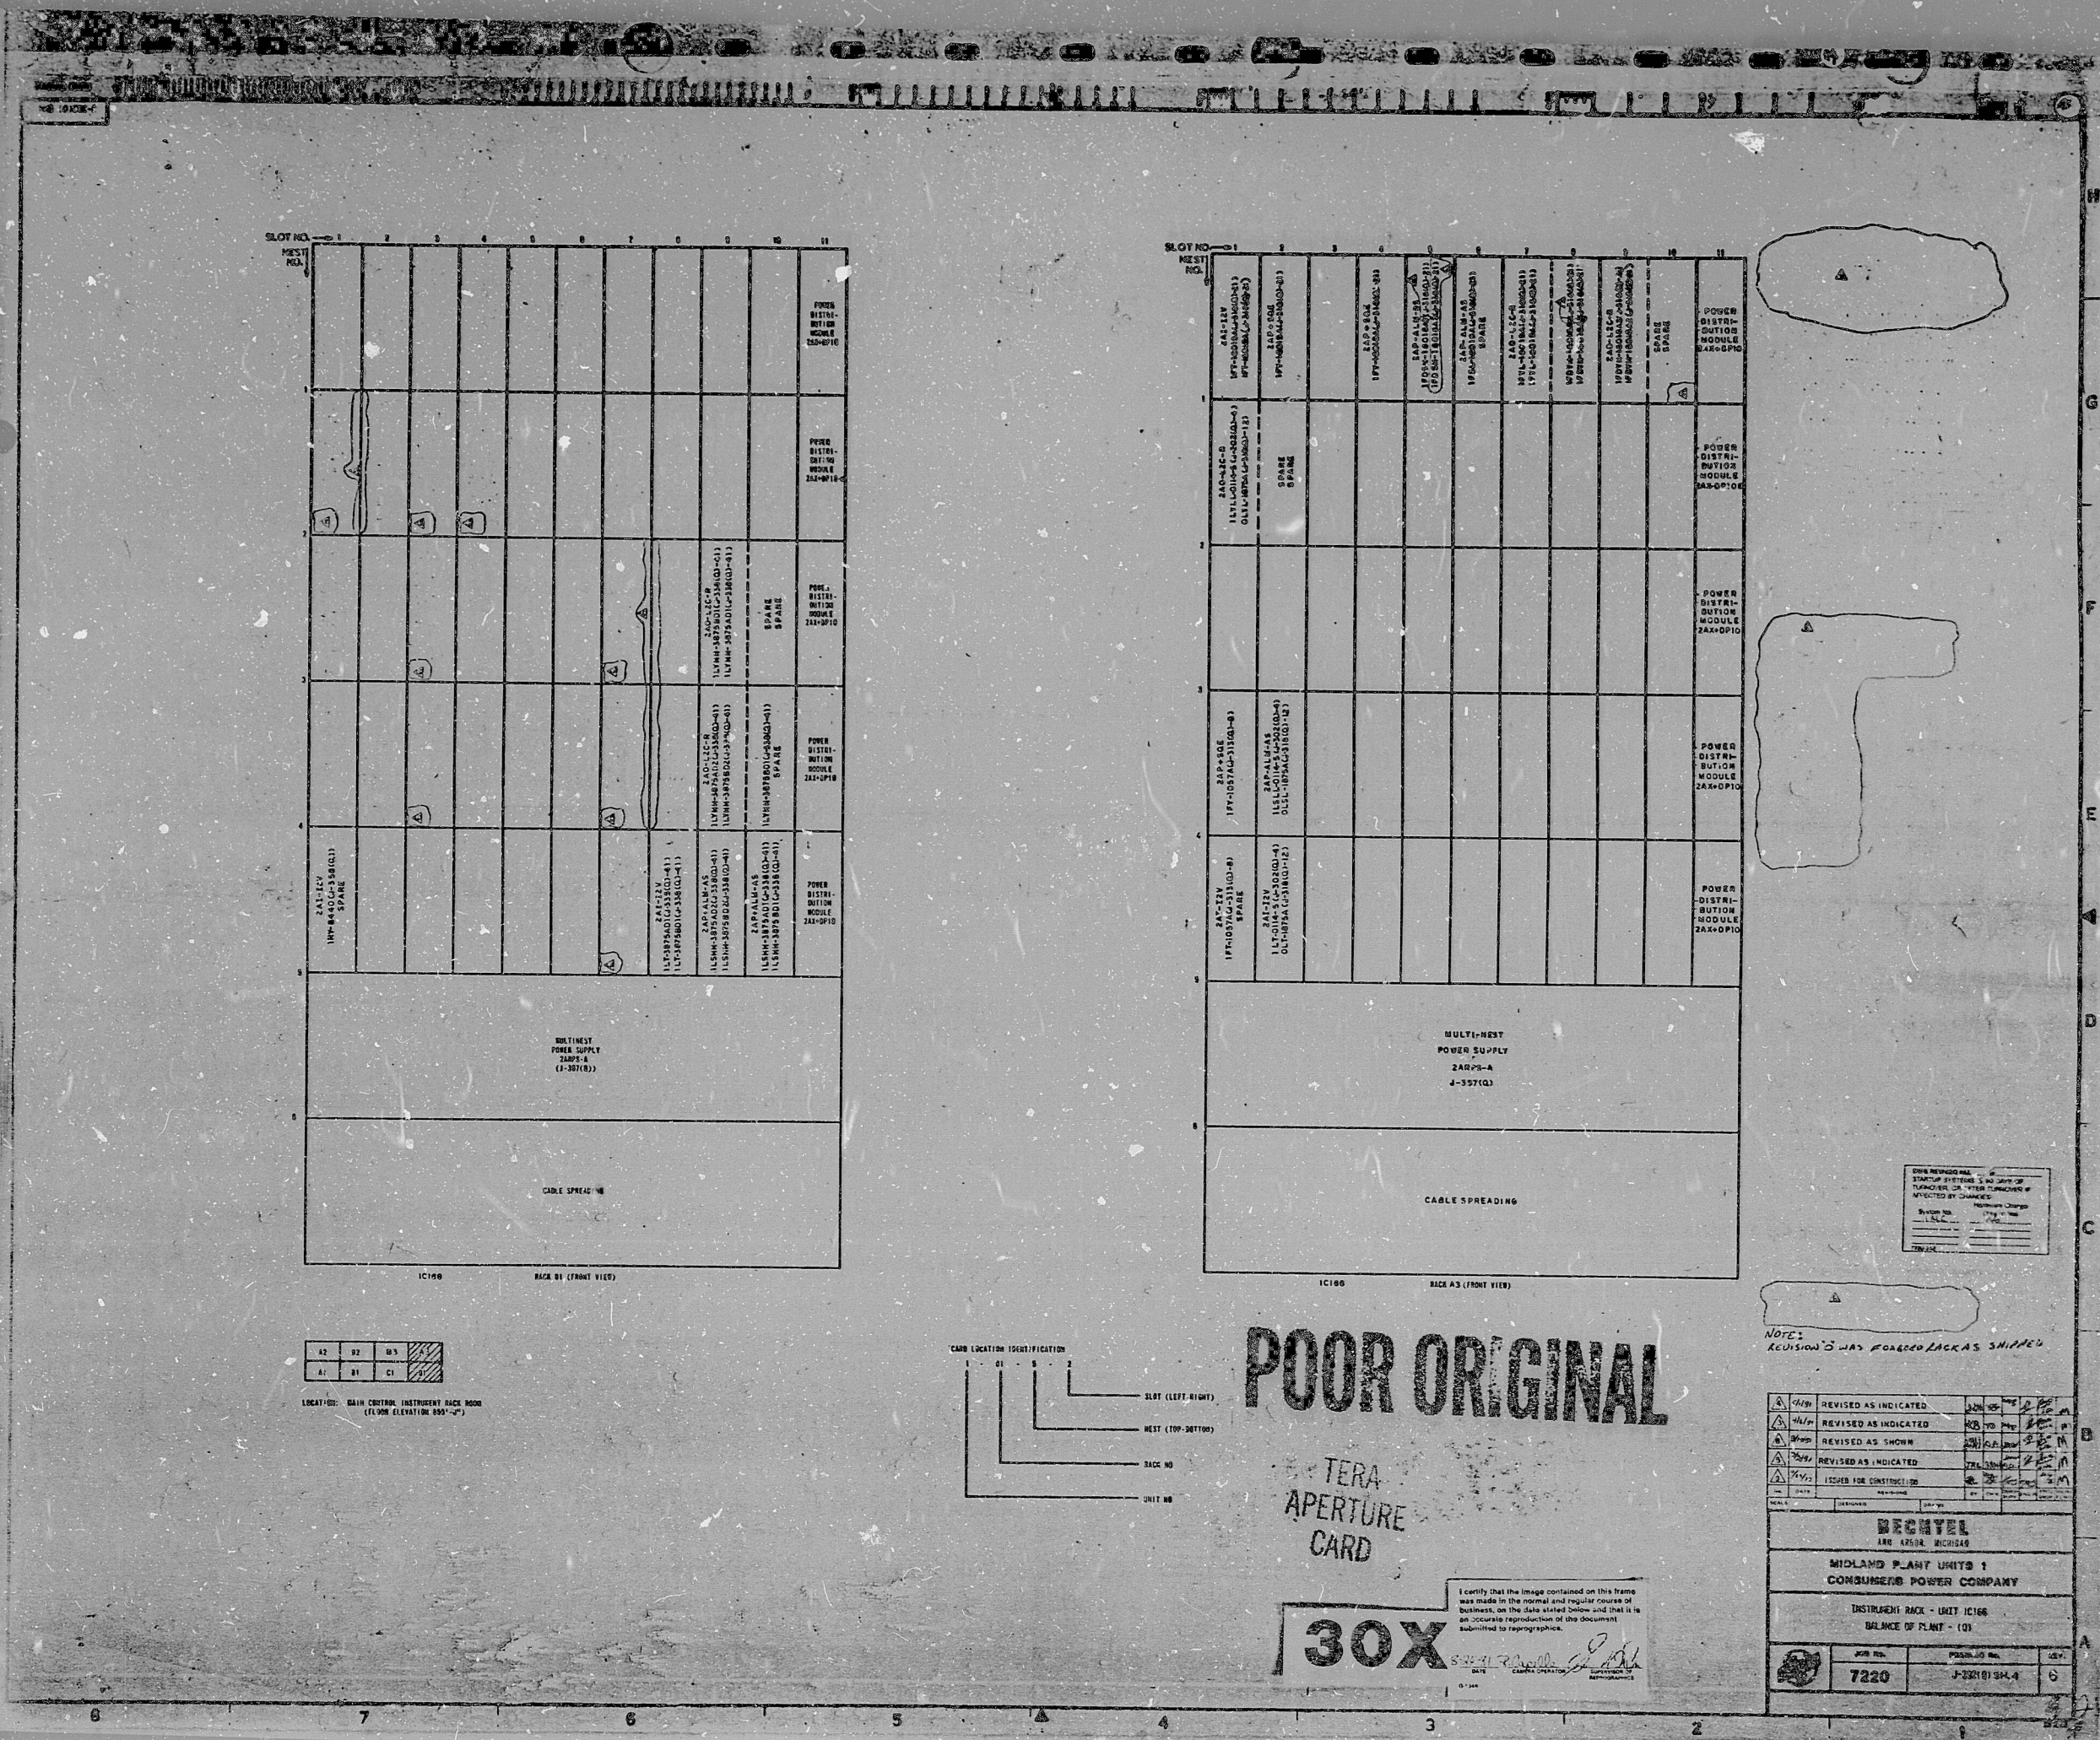

POOR ORIGINAL

TERA APERTURE CARD

30X


RECHTEL

MIDLAND PLANT UNIT 1
CONSUMER POWER COMPANY

INSTRUMENT RACK - UNIT 106
BALANCE OF PLANT - (C)

7220
J-2201(1) 34-4
6

RIDS

820110356

