




17" 8.5" 11" 8.5" 17"

17" 8.5" 11" 8.5" 17"

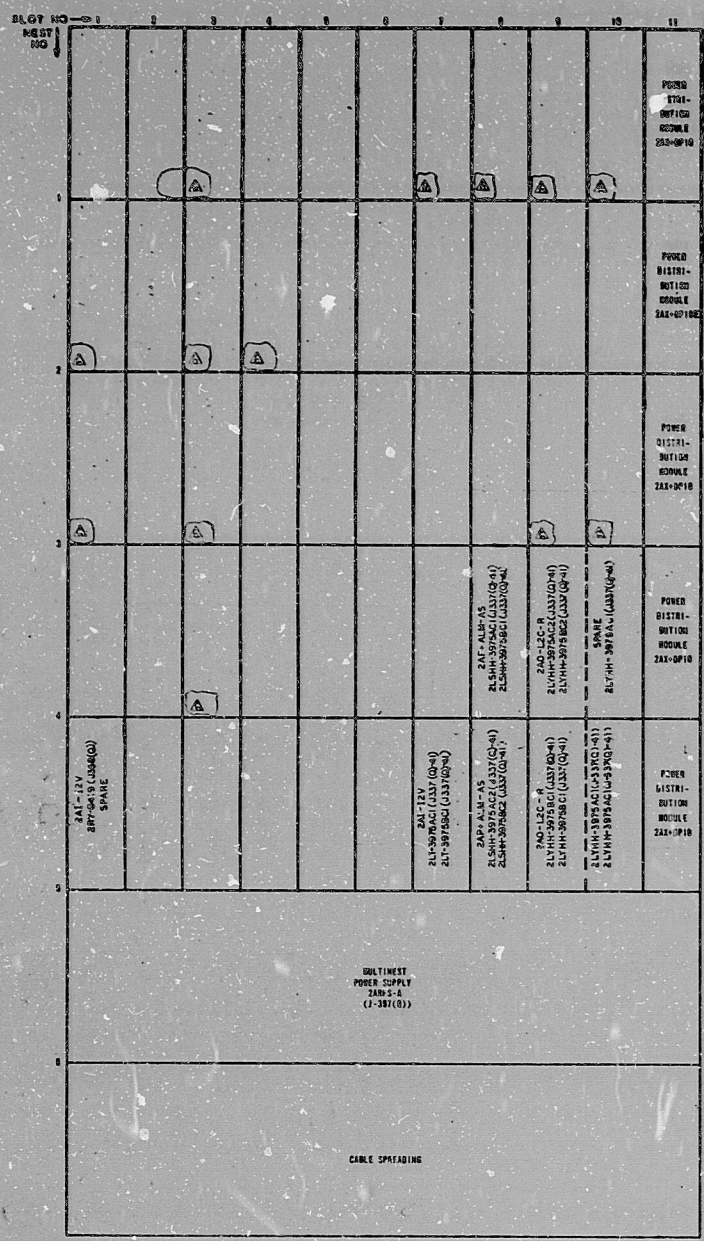

A2	A3
A1	B1

LOCATION: BATH CONTROL INSTRUMENT RACK ROOM
(FLOOR ELEVATION 658'-0")

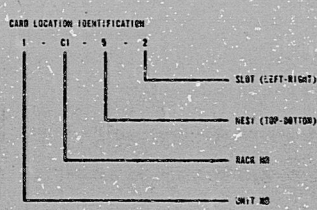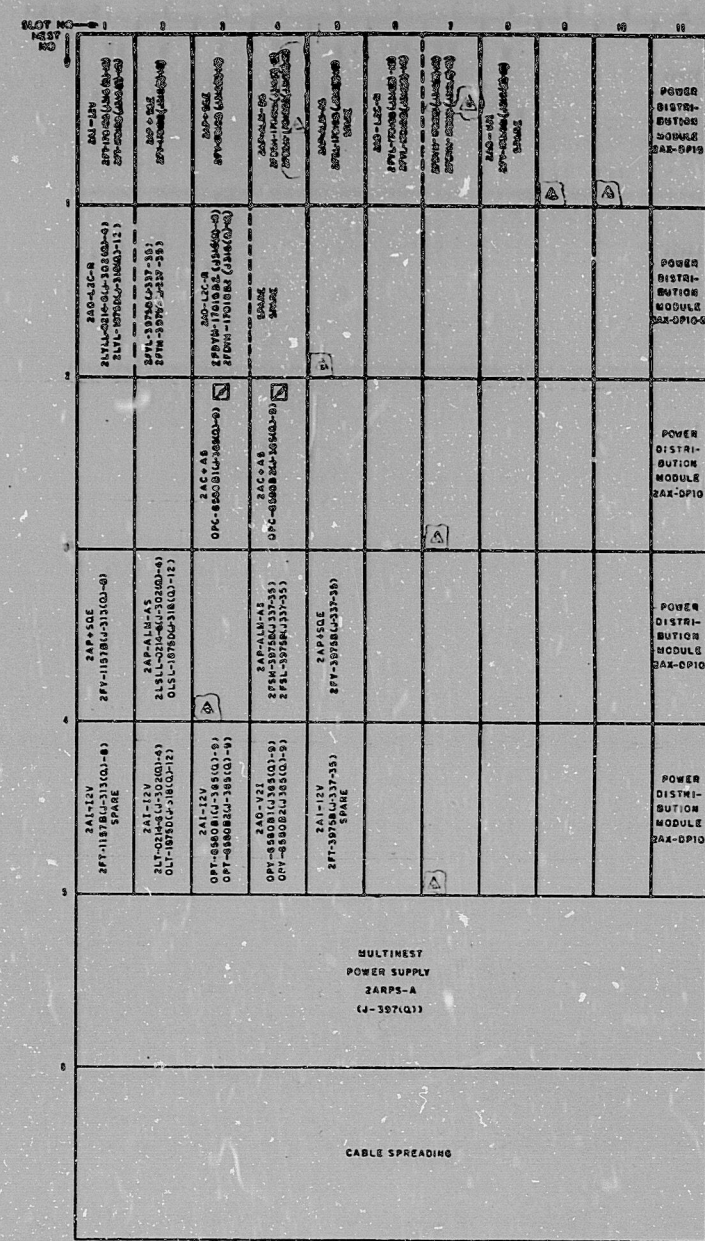

TERA
APERTURE
CARD
POOR ORIGINAL

30X

I certify that the image contained on this frame was made in the normal and regular course of business, on the date stated below and that it is an accurate reproduction of the document submitted to reprographics.

NOTE:
2. Original D was forced back
as shipped

REVISED AS SHOWN	REVISED AS SHOWN	REVISED AS SHOWN	REVISED AS SHOWN
1	2	3	4

BECHTEL
180 1820, MICHAEL
MIDLAND PLANT UNIT 2
CONSUMERS POWER COMPANY
INSTRUMENT RACK - UNIT 2C166
BALANCE OF PLANT - (D)

DATE	REVISION	BY	CHKD
7/22/66	J-392(Q) S.M.3	6	

RIDS

8291110361

