9-E-PMAA-02

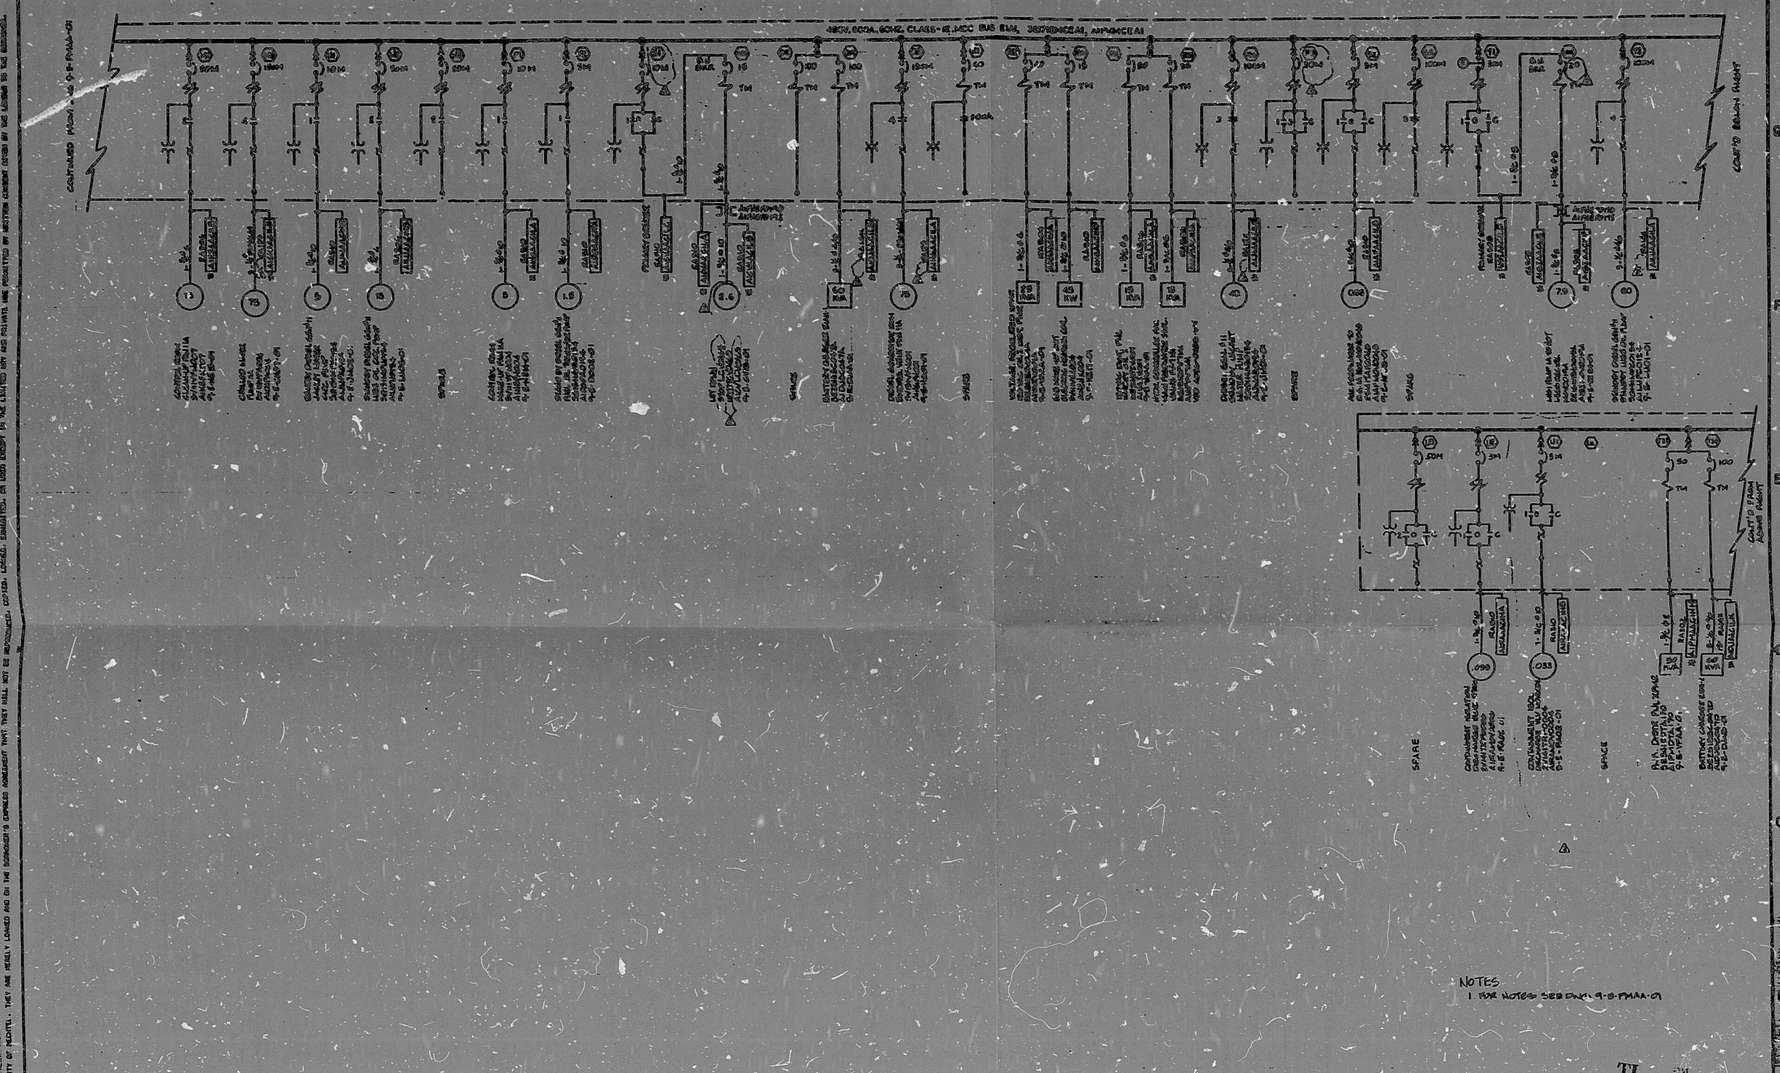

NOTES
1 FOR NOTES SEE DWG. 9-E-PMAA-01

TI APERTURE CARD

INFORMATION ONLY

THIS DRAWING MUST BE WORKED WITH THE FOLLOWING DOCUMENTS

DCN'S	FCR'S

REV	REV	DWG NO	REFERENCE	DWG NO	REFERENCE	NO	DATE	REVISION
CHIEF ENGR	2					2		ISSUED WITH REVISIONS
						1		RE-ISSUED AS NOTED
						0		ISSUED FOR CONSTRUCTION

BECHTEL ENERGY CORPORATION
HOUSTON TEXAS

HOUSTON LIGHTING & POWER CO
SOUTH TEXAS PROJECT

NUCLEAR SAFETY RELATED Q

SINGLE LINE DIAGRAM
480V CLASS-1E MOTOR CONTROL CENTER
E1A1 (EAB)

JOB NO.	DWG NO.	REV
14928	9-E-PMAA-02	2

8501160109

PDR RIDS

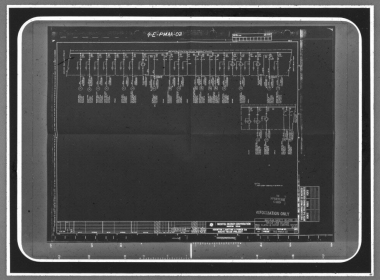

MMM 5824 — FILMSORT® Brand Aperture & Camera Cards and DUPLICARD® Brand Copy Cards — Product of 3M Company, St. Paul, Minn.