


9E-DJAD-01

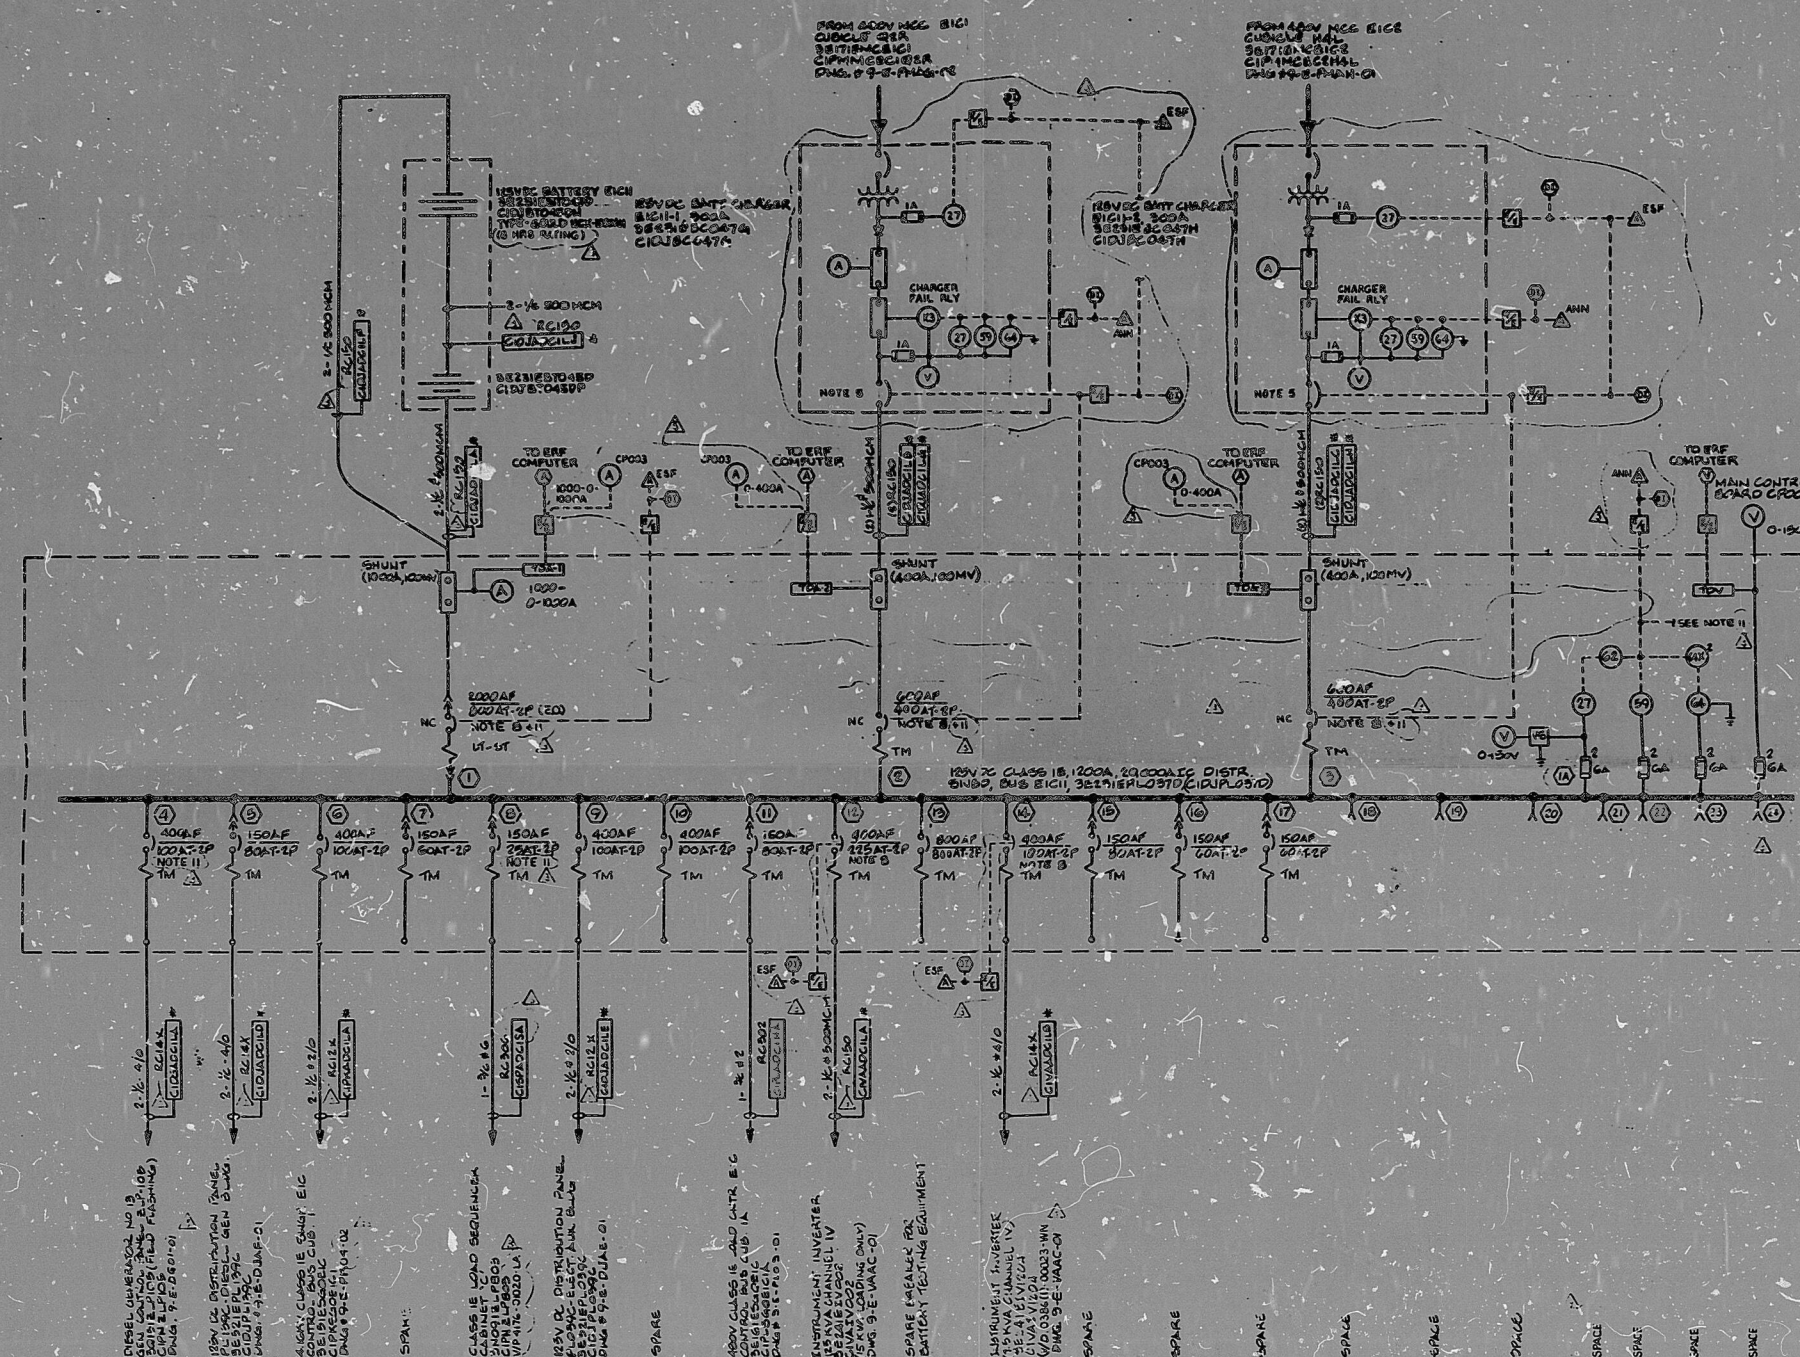

- 1. FOR LEGEND AND SYMBOLS REFER TO DWGS 0-1-N201-01 AND 0-1-N201-02.
- 2. THE DRAWING CHARGES 240V AND 250V ROOT DMS. P. 4-0-01-1-1-1-14-15.
- 3. EACH BREAKER HAS AN OVER-CURD BELL ALARM.
- 4. ALL BREAKERS SHALL HAVE AT LEAST 25000A INTERRUPTING CAPACITY AT 250V DC.
- 5. CHARGER TO OUTPUT BREAKER SHALL PROVIDE AIRLOCK OPENING.
- 6. WIRE NUMBERS FOR 250V FEEDS ARE P/N.
- 7. INTERLOCK (A) DESIGNS ARE SHOWN ON CAT.
- 8. THESE BREAKERS HAVE AUXILIARY CONTACT TO INDICATE BREAKER POSITION, WHICH ARE WIRED TO THE CHARGER TO INDICATE CHARGE DISCHARGE/NOT STATUS. (INCLUDING CHARGE UNDER VOLT FOR BAR 250V & SEE Dwg. 1-0-MAC-01).
- 9. ALL ALARM AND DIGITAL CHARGE INPUTS ARE WIRED TO THE COMPUTER. SEE Dwg. 1-0-DIG-01 FOR CABLE INFORMATION.
- 10. OUTPUT OF TRANSCHARGERS ARE 420MA EXCEPT FOR 250V CHM HAS 4-200MA OUTPUT.
- 11. 3WSD TRUABLE ALARM INPUT CONSISTS OF SERIES CONNECTED N.C. CONTACTS OF DEV. 596-C-600N-02, 596-C-600N-03, 596-C-600N-04, NUCLEAR SAFETY RELAT

[illegible]

BECHTEL ENERGY CORPORATION
HOUSTON, TEXAS

HOUSTON LIGHTING & POWER CO.
SOUTH TEXAS PROJECT

SINGLE LINE DIAGRAM		
125V DC CLASS IE DISTRIBUTION SWB		
EICII (CHANNEL IV)		
FIGURE	14928	9-5-DJAD-01

THIS DRAWING MUST BE WORKED WITH THE FOLLOWING DOCUMENTS

DCU'S	FCU'S	FCU'
-------	-------	------

850160117

PDR RIDS

