


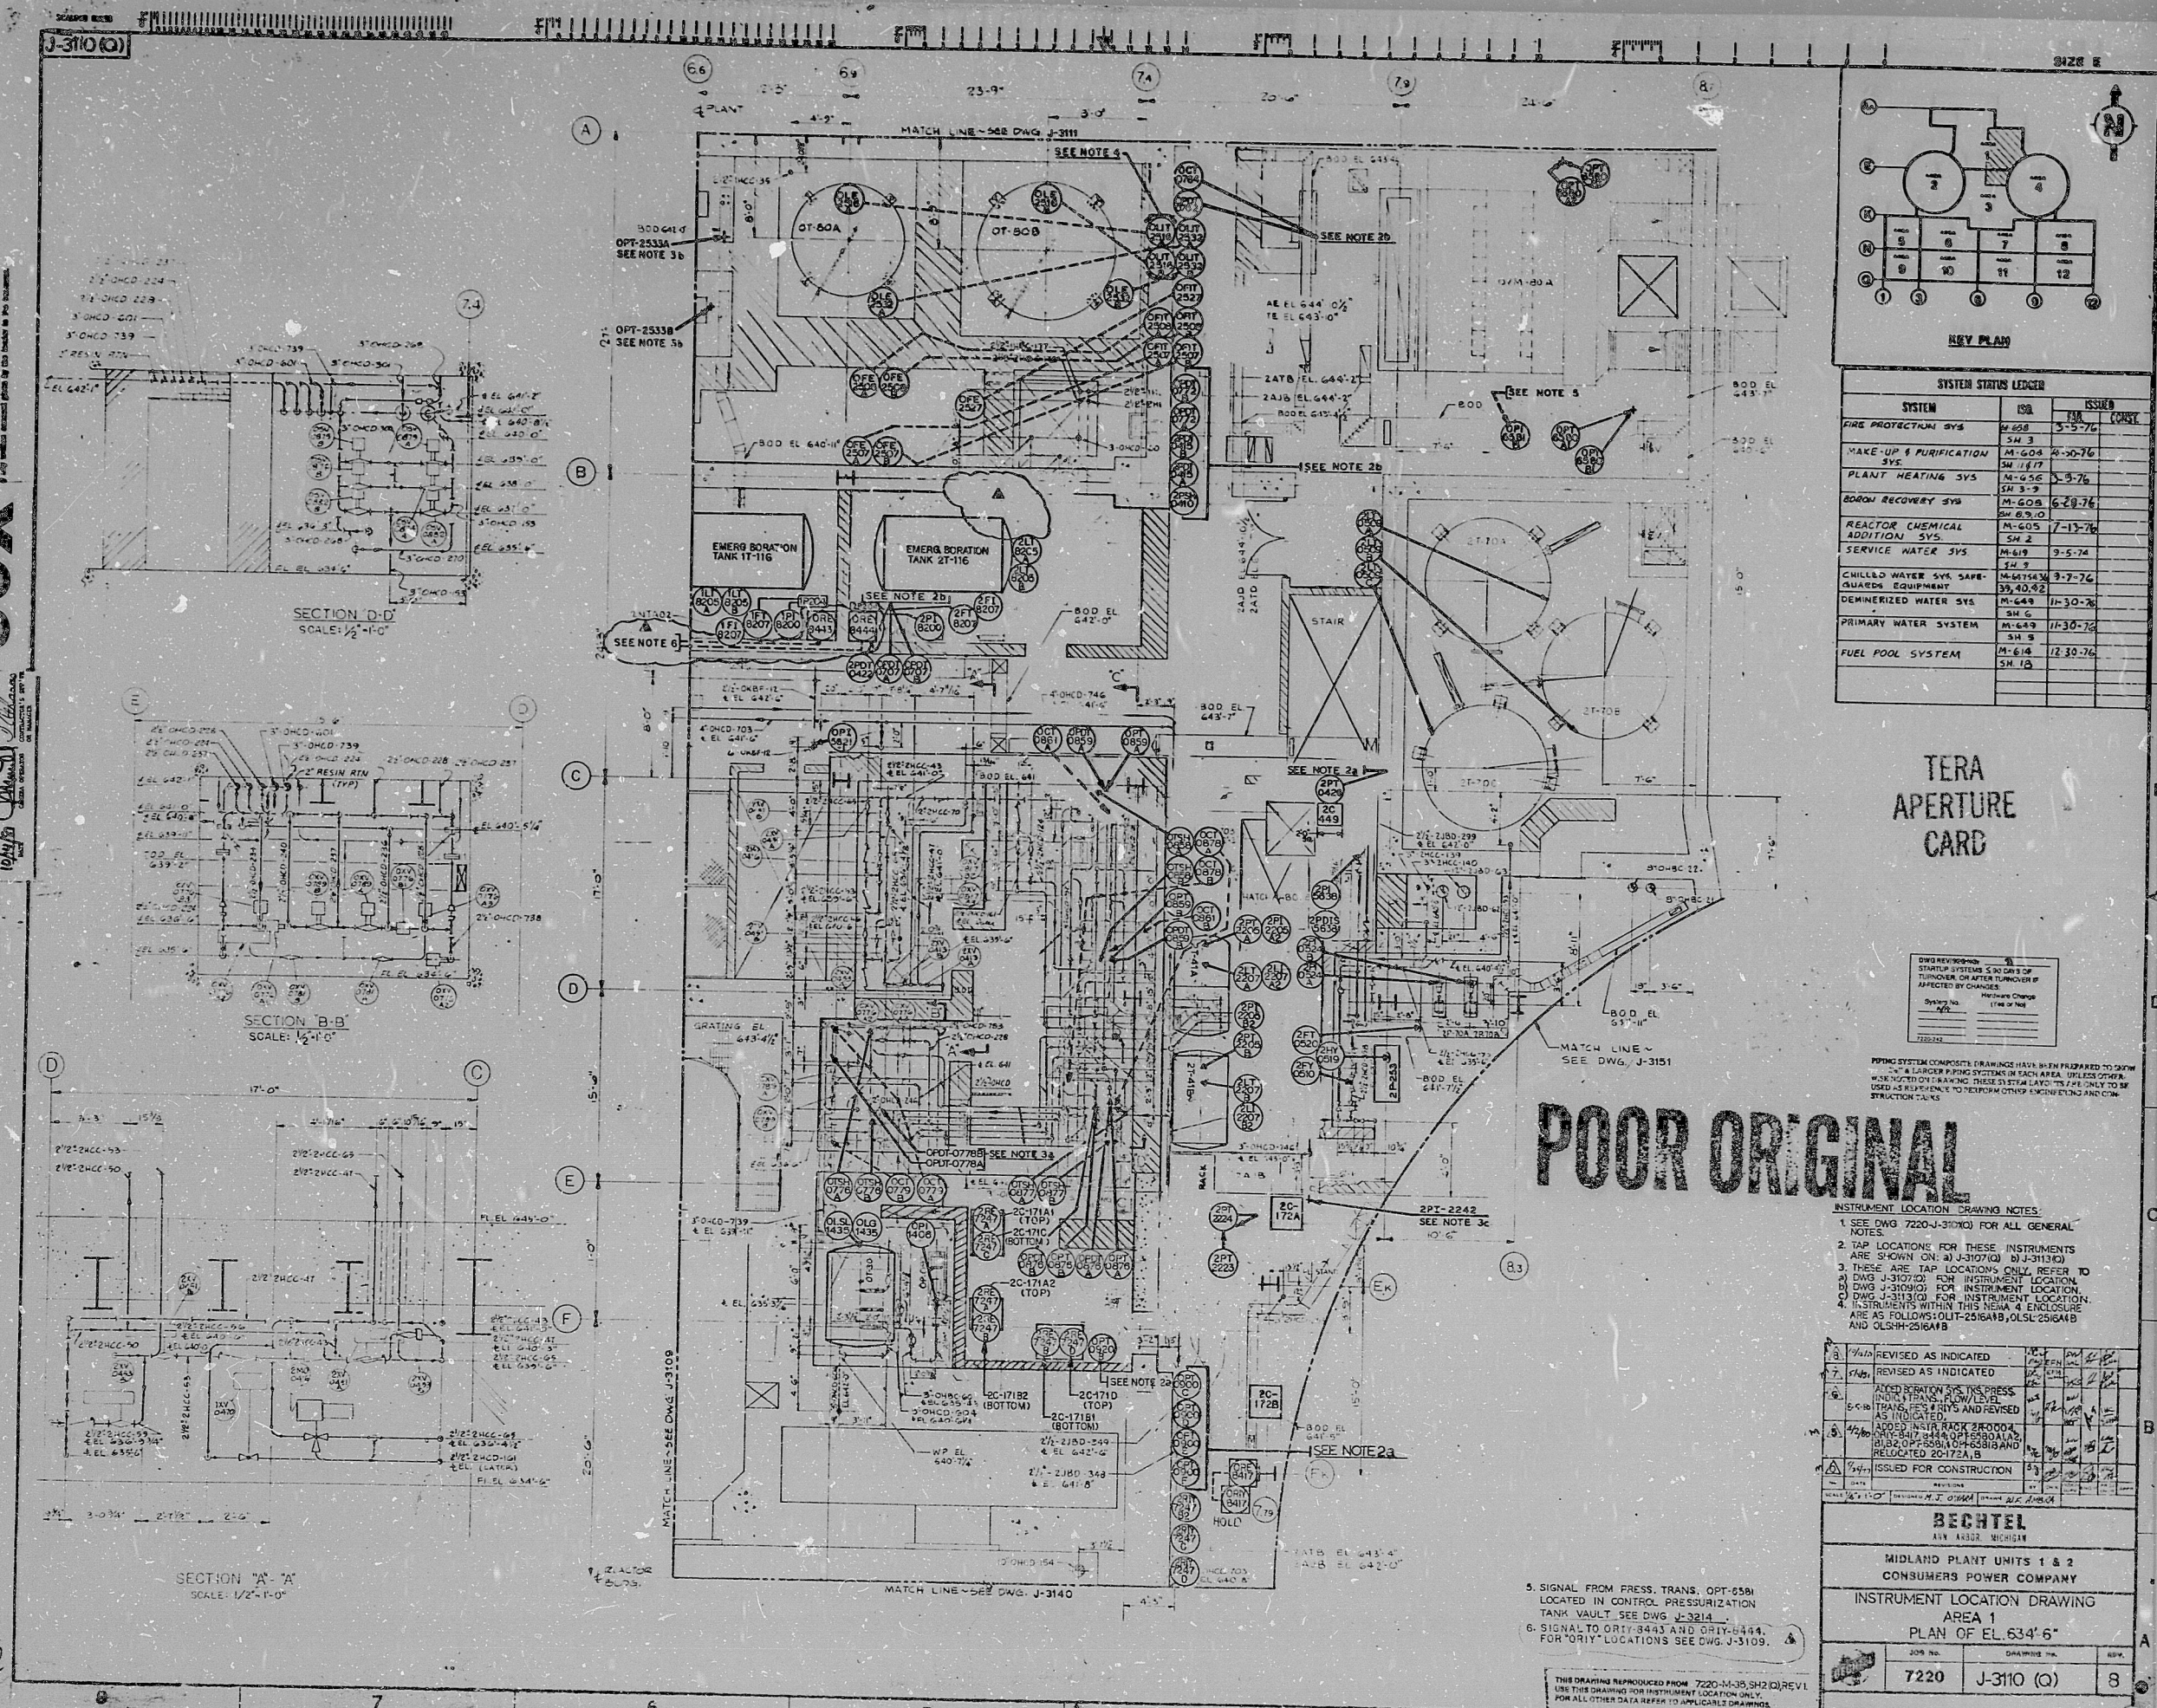

POOR ORIGINAL

INSTRUMENT LOCATION DRAWING NOTES:

1. SEE DWG 7220-J-3170(C) FOR ALL GENERAL NOTES.
2. TAP LOCATIONS FOR THESE INSTRUMENTS ARE SHOWN ON: a) J-3107(C) b) J-3113(C)
3. THESE ARE TAP LOCATIONS ONLY, REFER TO DWG J-3107(C) FOR INSTRUMENT LOCATION.
4. DWG 7220-J-3107(C) FOR INSTRUMENT LOCATION.
5. DWG J-3113(C) FOR INSTRUMENT LOCATION.
6. INSTRUMENTS WITHIN THIS AREA 4 ENCLOSURE ARE AS FOLLOWS: OLIT-2516A1B, OLSL-2516A1B AND OLSHH-2516A1B

DATE		REVISIONS	DATE	

BECHTEL

MIDLAND PLANT UNITS 1 & 2

CONSUMERS POWER COMPANY

INSTRUMENT LOCATION DRAWING
AREA 1

PLAN OF EL. 634

09 No.	DRAWN
--------	-------

220	J-3110
-----	--------

RIDS

8201110370

