


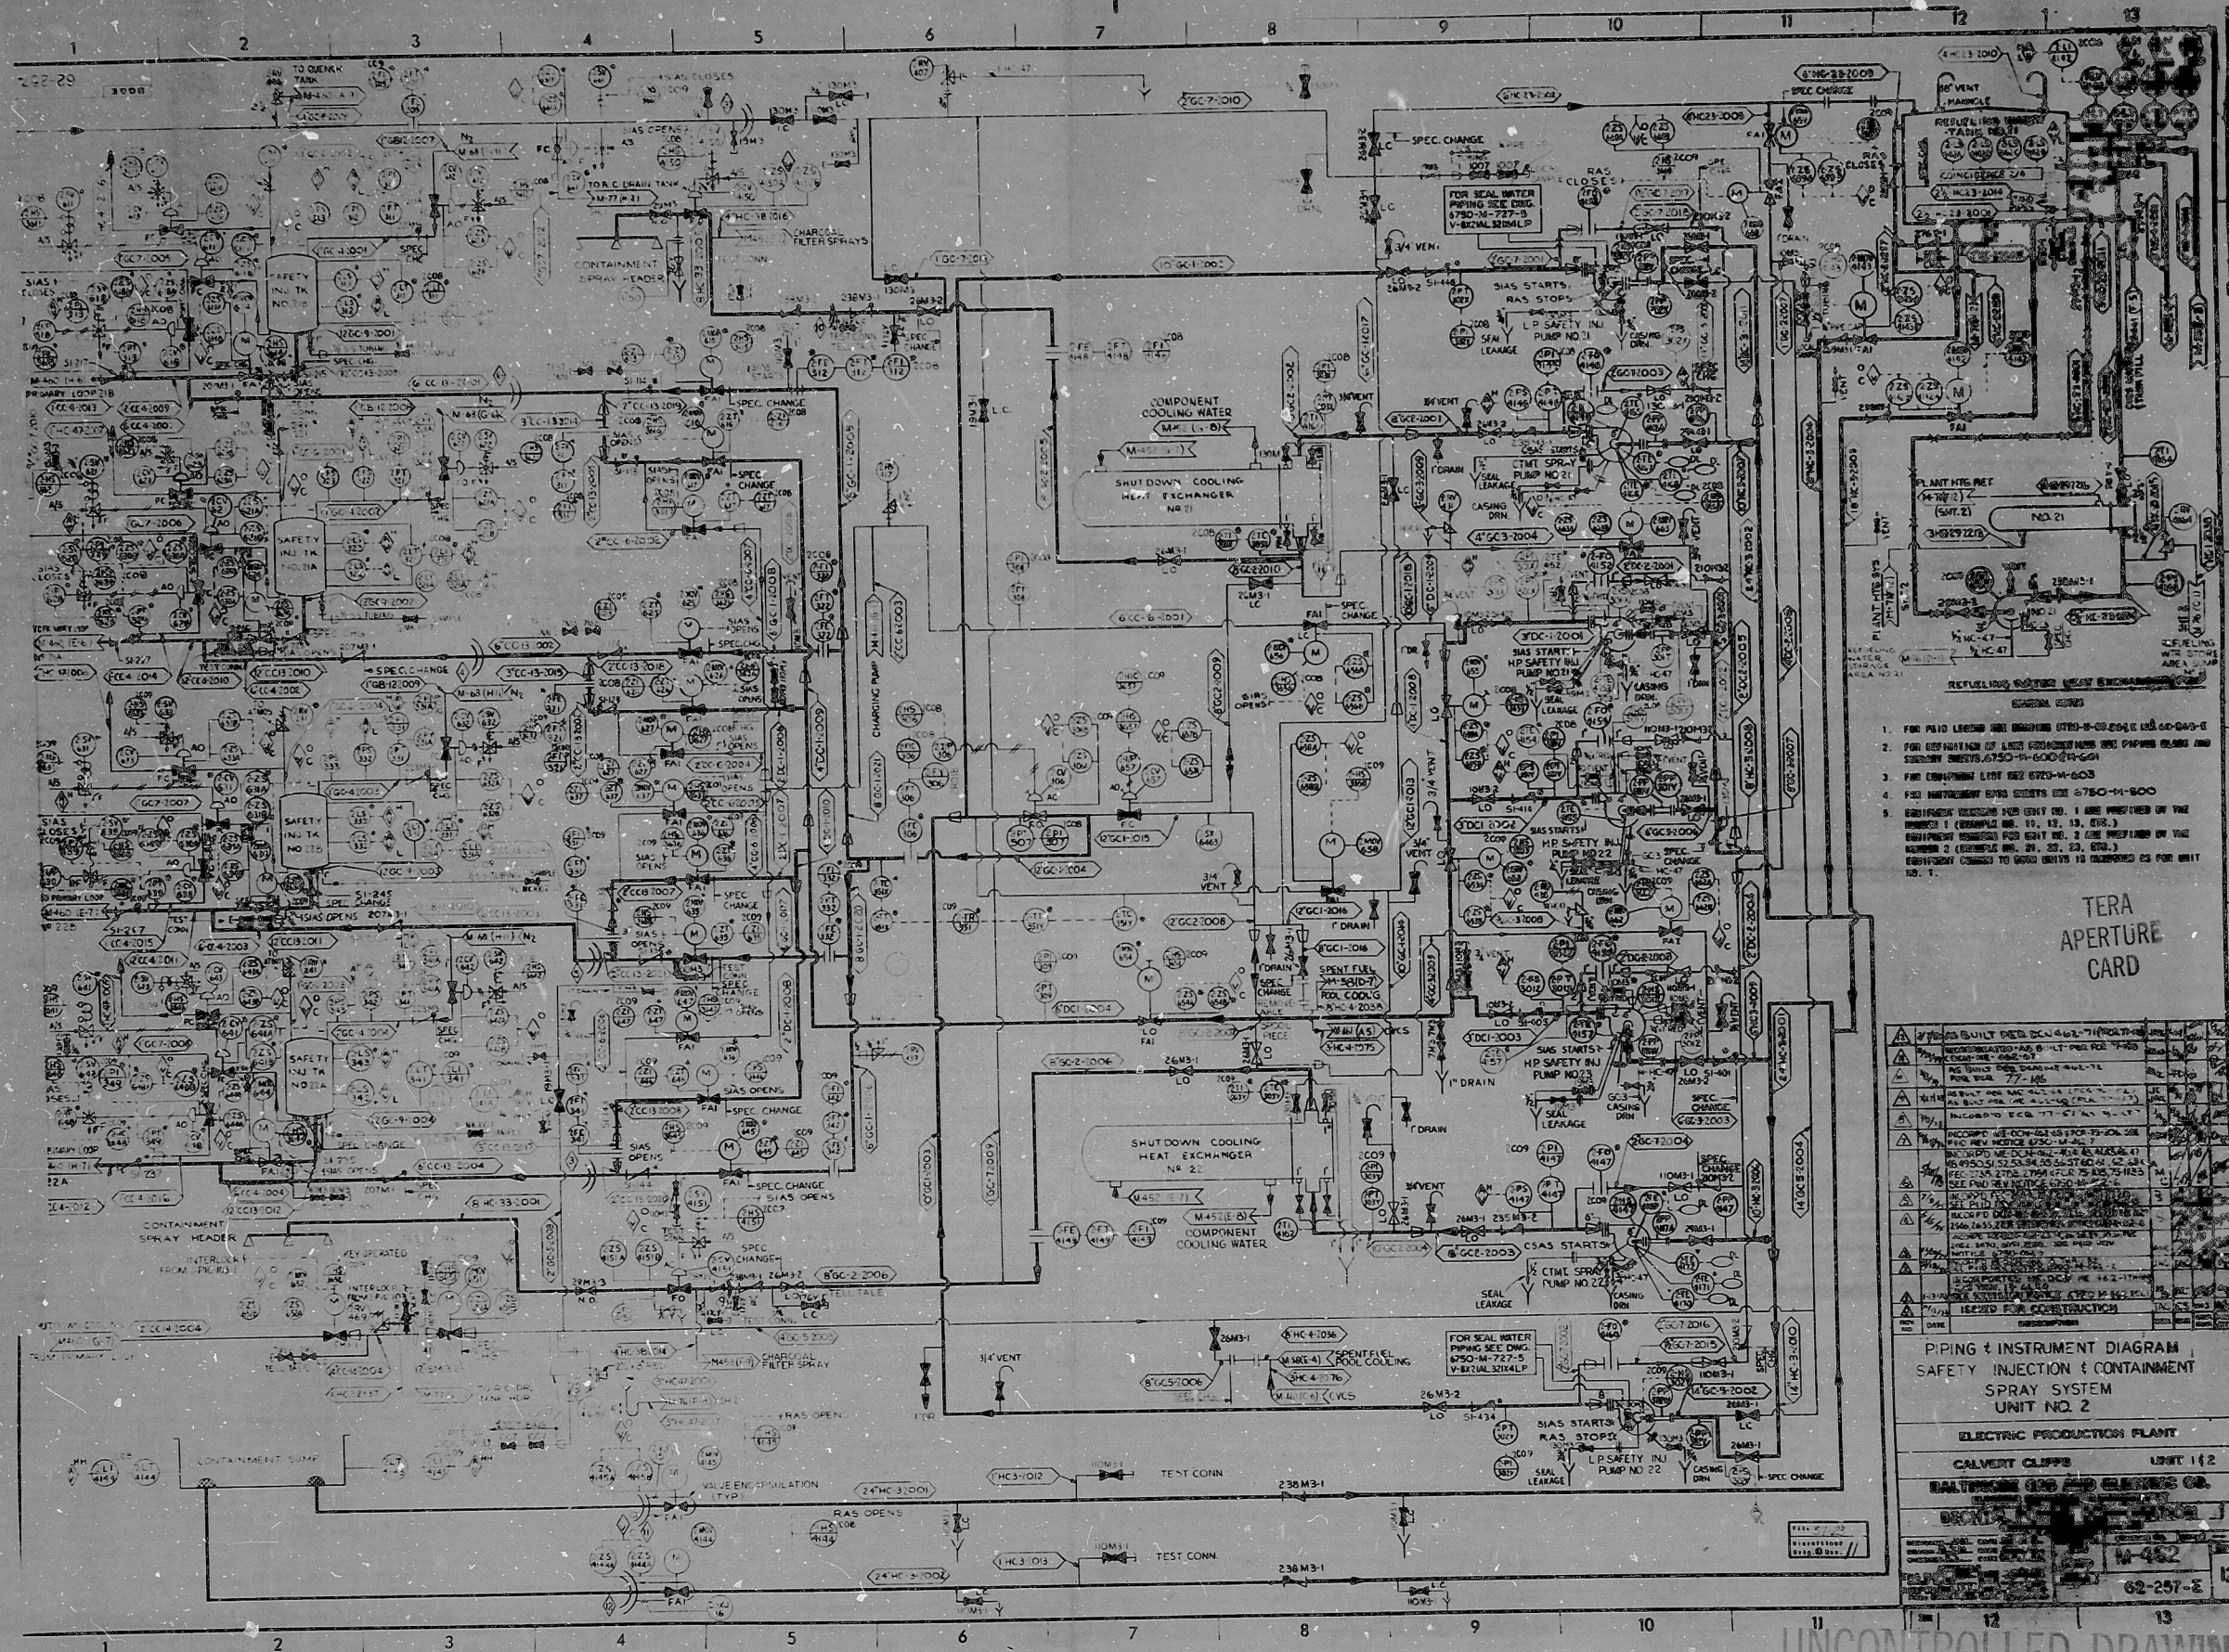

UNCONTROLLED DRAWING
 USER MUST VERIFY DRAWING TO BE
 LATEST REVISION PER DRAWING CON-
 TROL INDEX PRIOR TO USE AND
 WEEKLY DURING USE

8005050323

PDR

8005050323

