


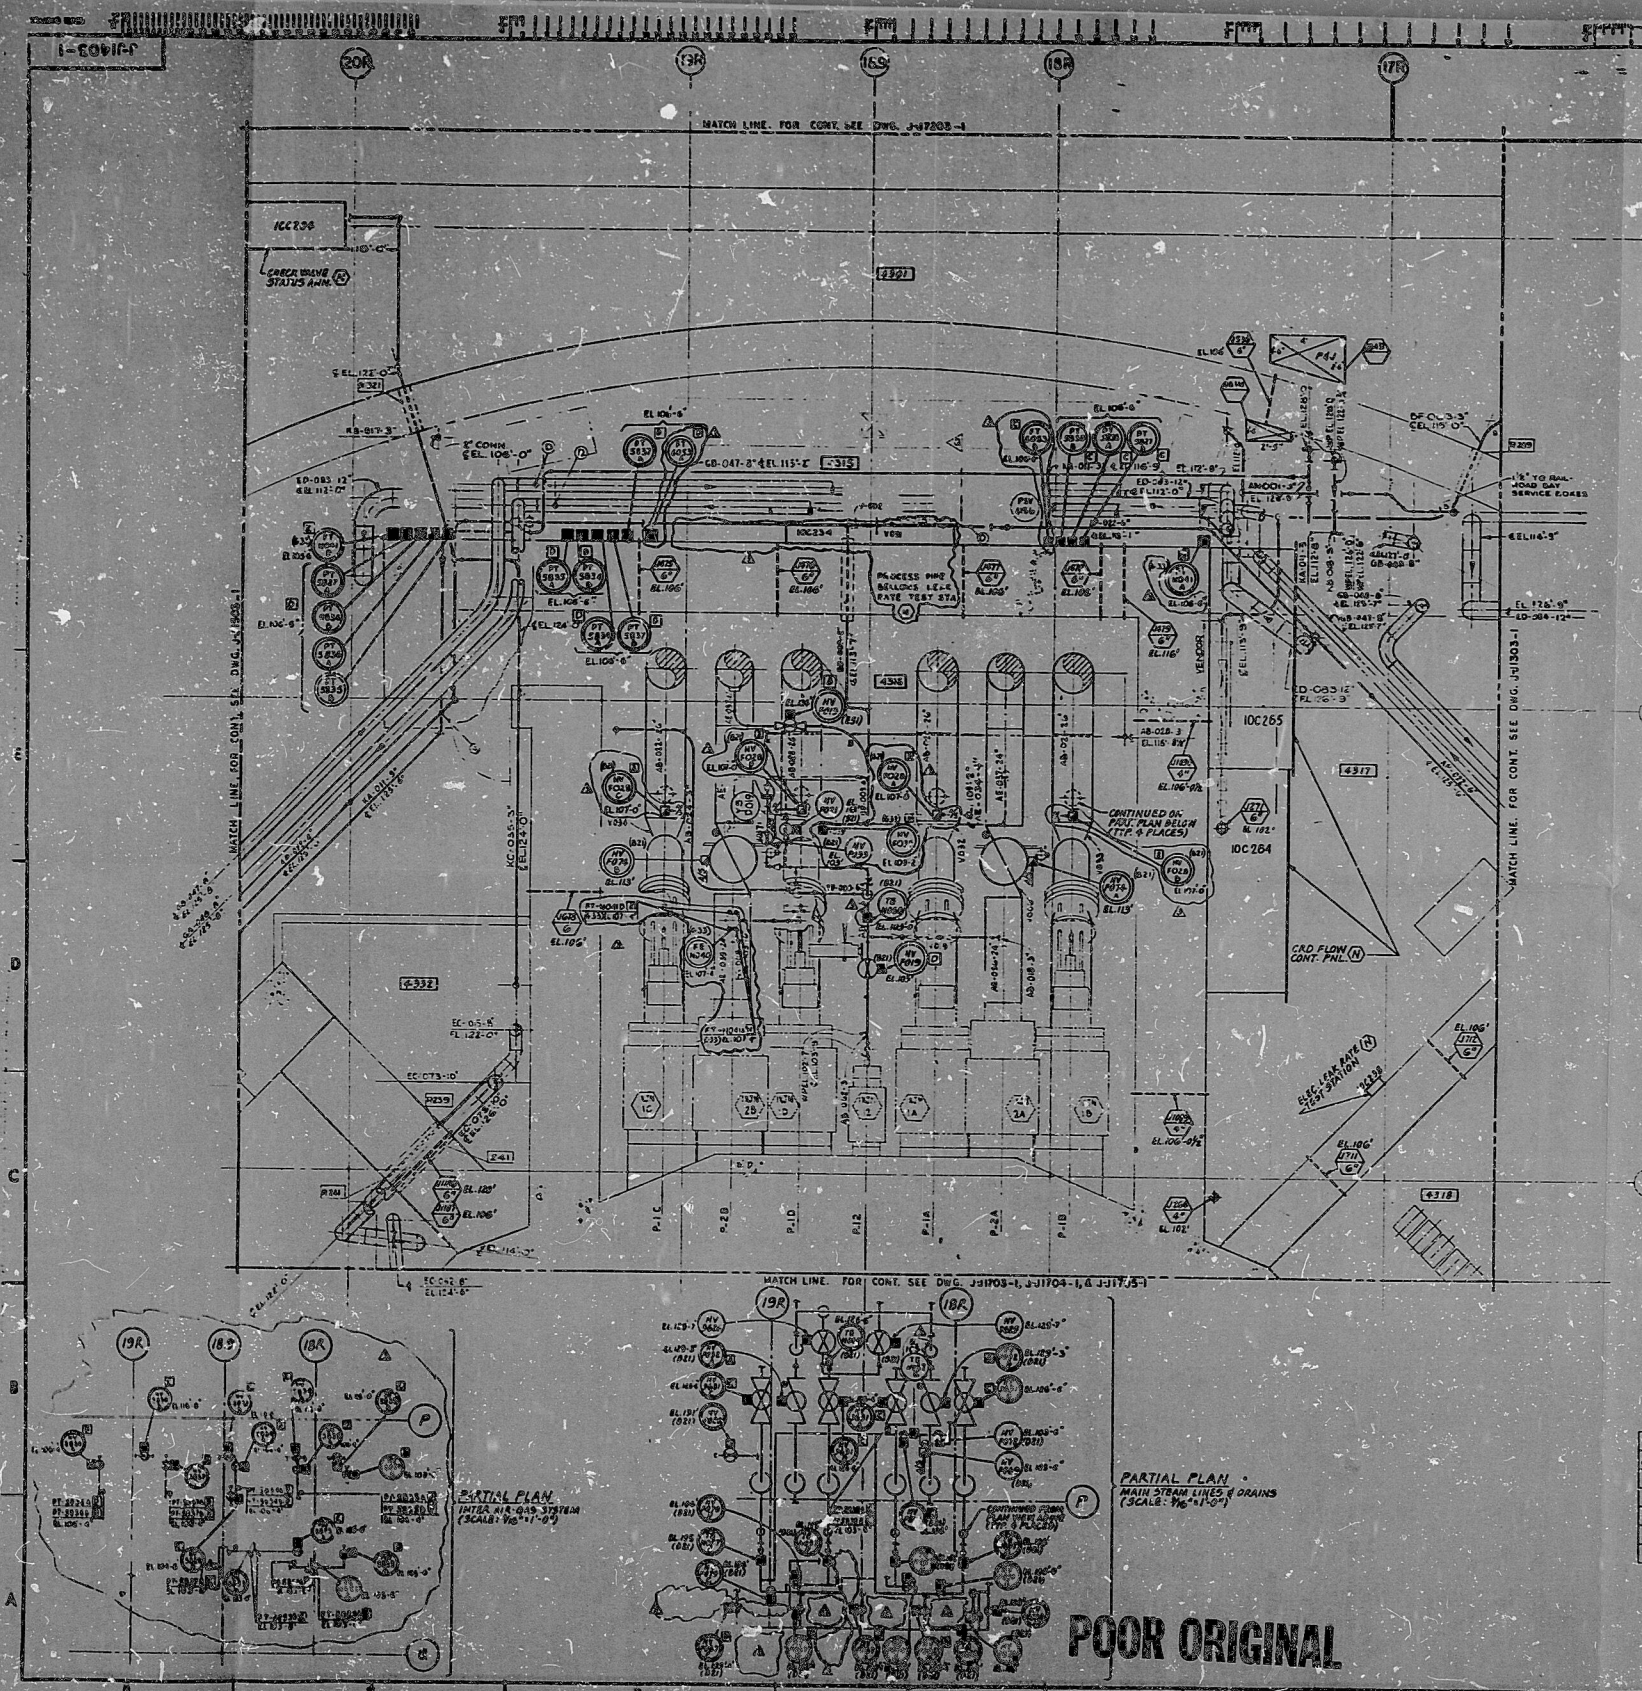

NO.	DESCRIPTION	DATE	BY	CHKD.
2	REVISION			
3	REVISION			
PROJ. REFERENCE DWGS:
M-41-SHT1&2, M-49-1, M-72-1, M-44-1.
Piping:
P-403-1, P-411-1, P-412-1, P-444-1.

NOTES:
1. FOR GENERAL NOTES AND LEGEND SEE DRA'ING J-10001.
2. ALL INSTRUMENTS ON 2" AND UNDER FIELD RUN PIPING WILL NOT APPEAR ON THE LOCATION DRAWING, AND WILL READ IN THE INSTRUMENT INDEX IN THE EQUIPMENT COLUMN.
3. FOR THE EXACT LOCATION OF THE PRIMARY POINT REFER TO THE ENGINEERING AND/OR FIELD ISOMETRIC DRAWINGS.



RIDS

8308040117

