


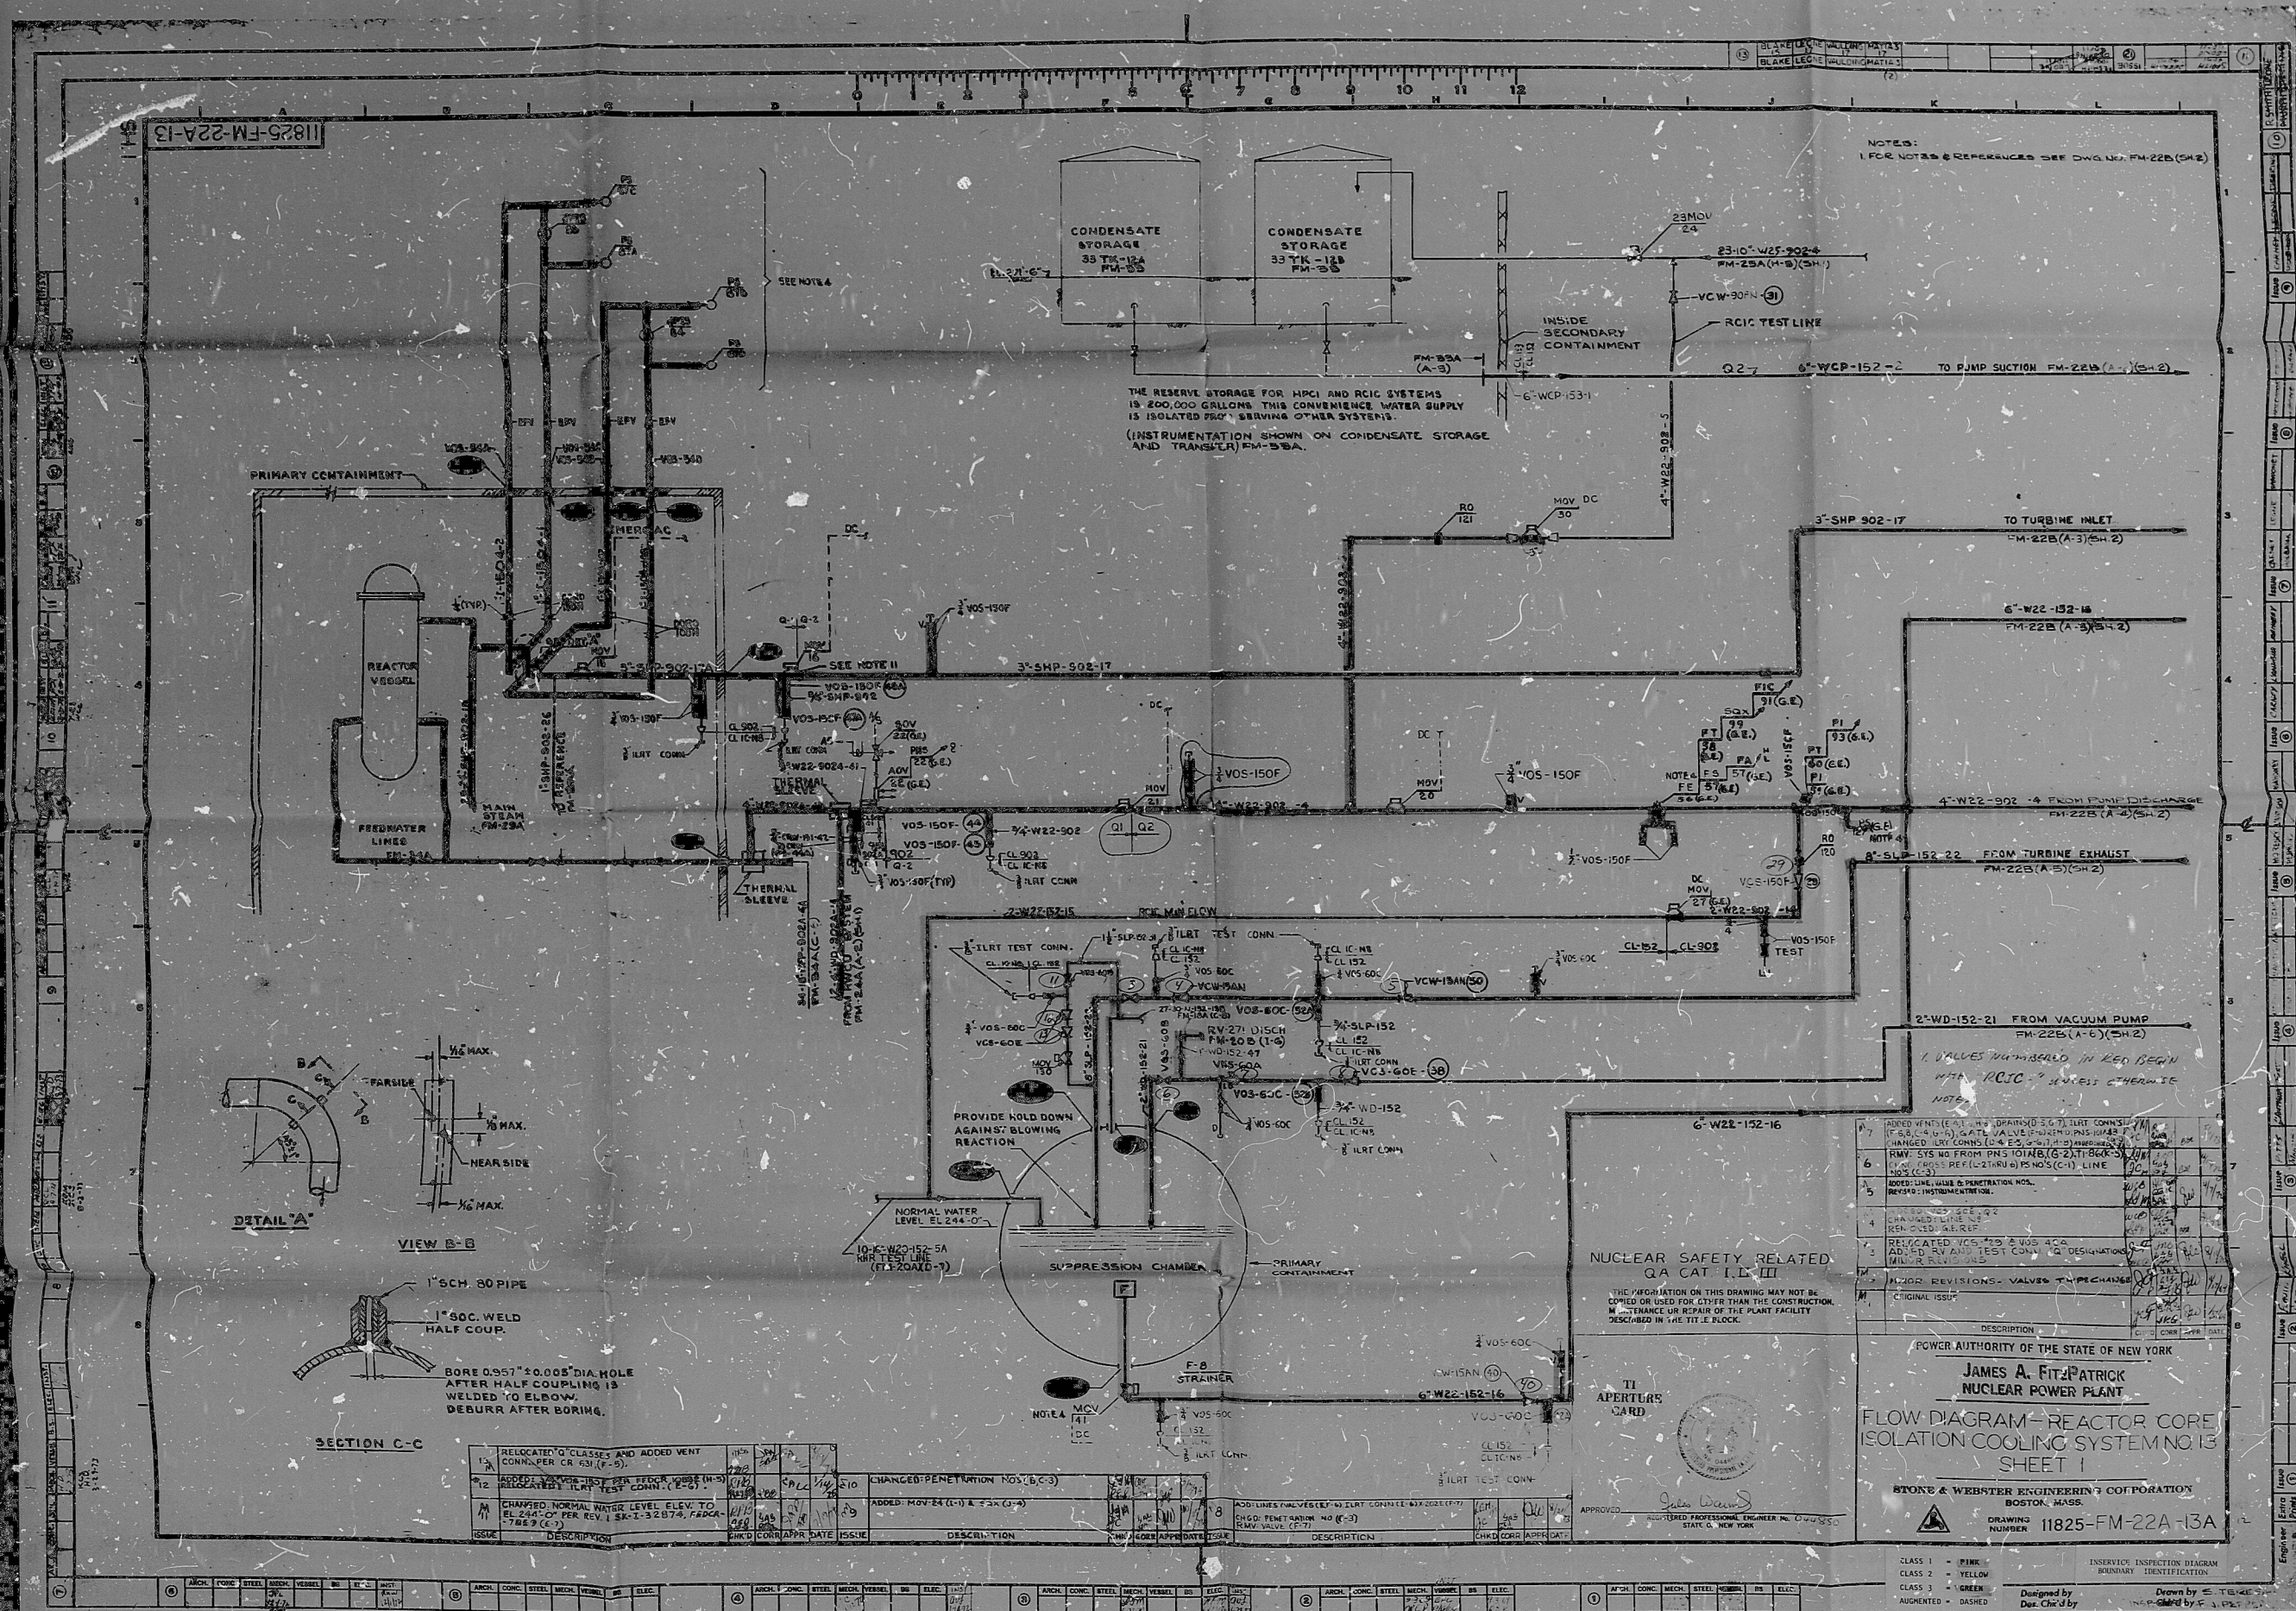



FDR

8501170182

