


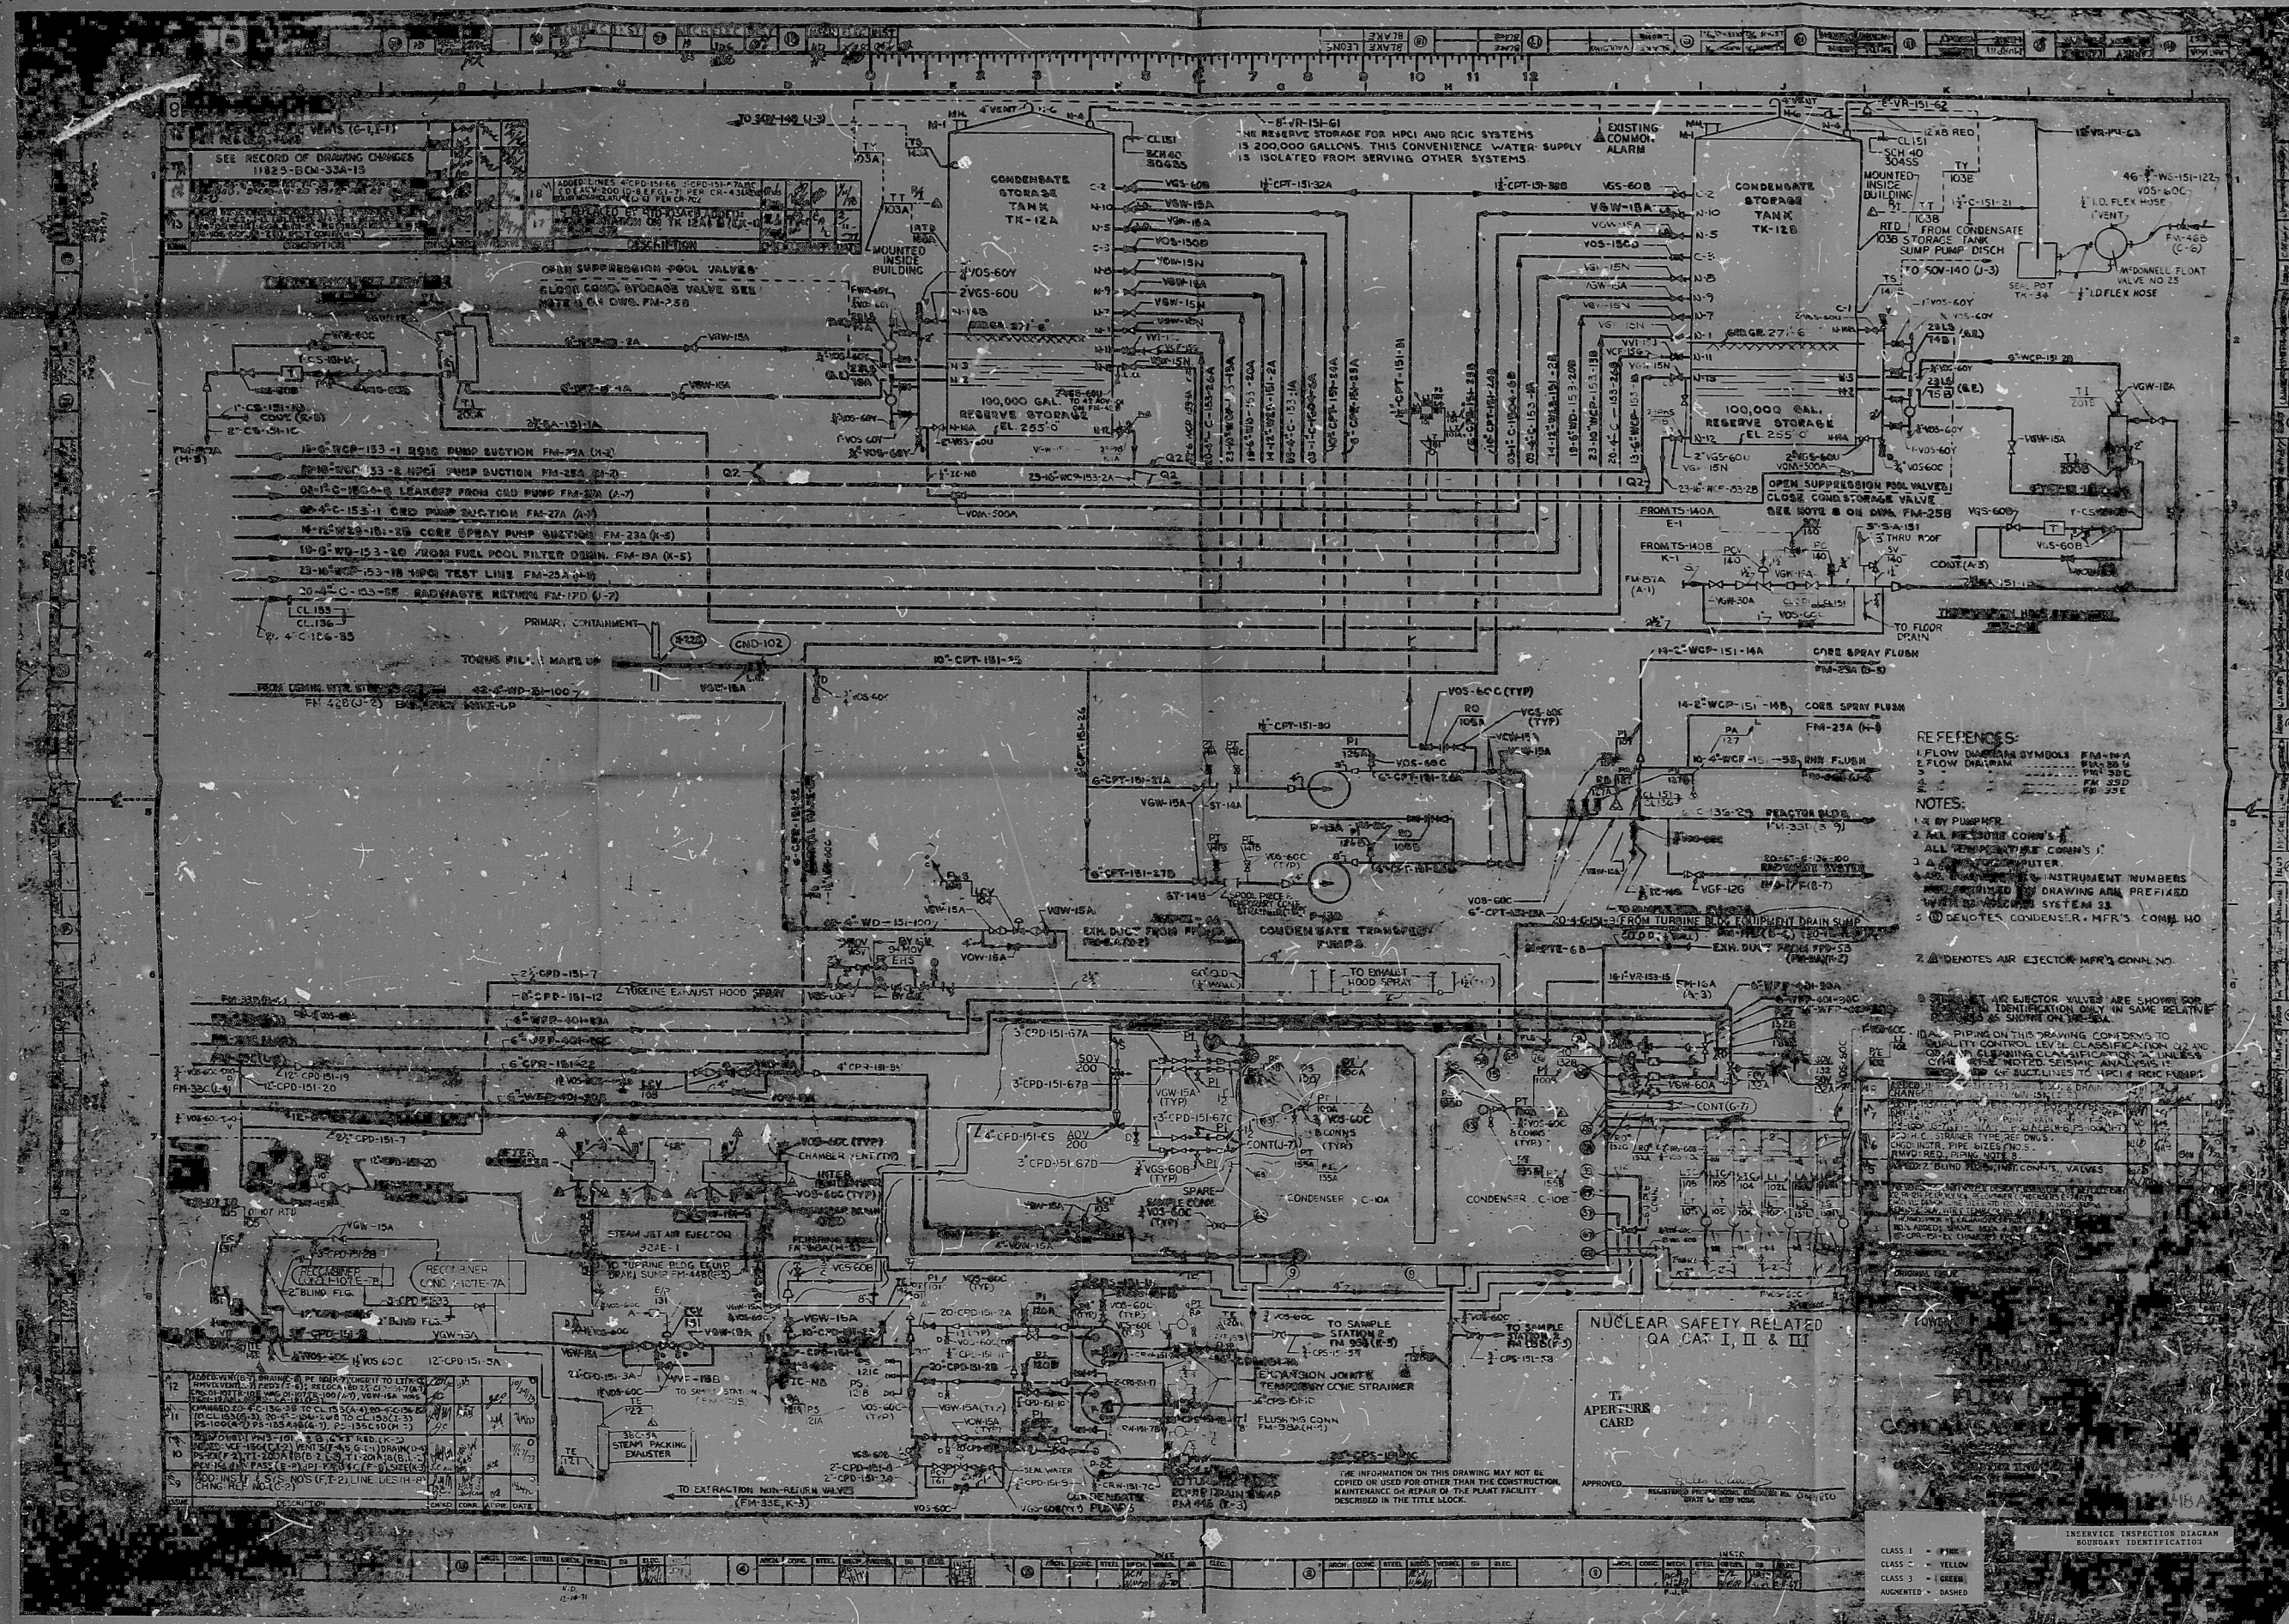

8501170187



PDR

8501170187

