


22"
17"
11"
8.5"
8.5"
11"
17"
22"

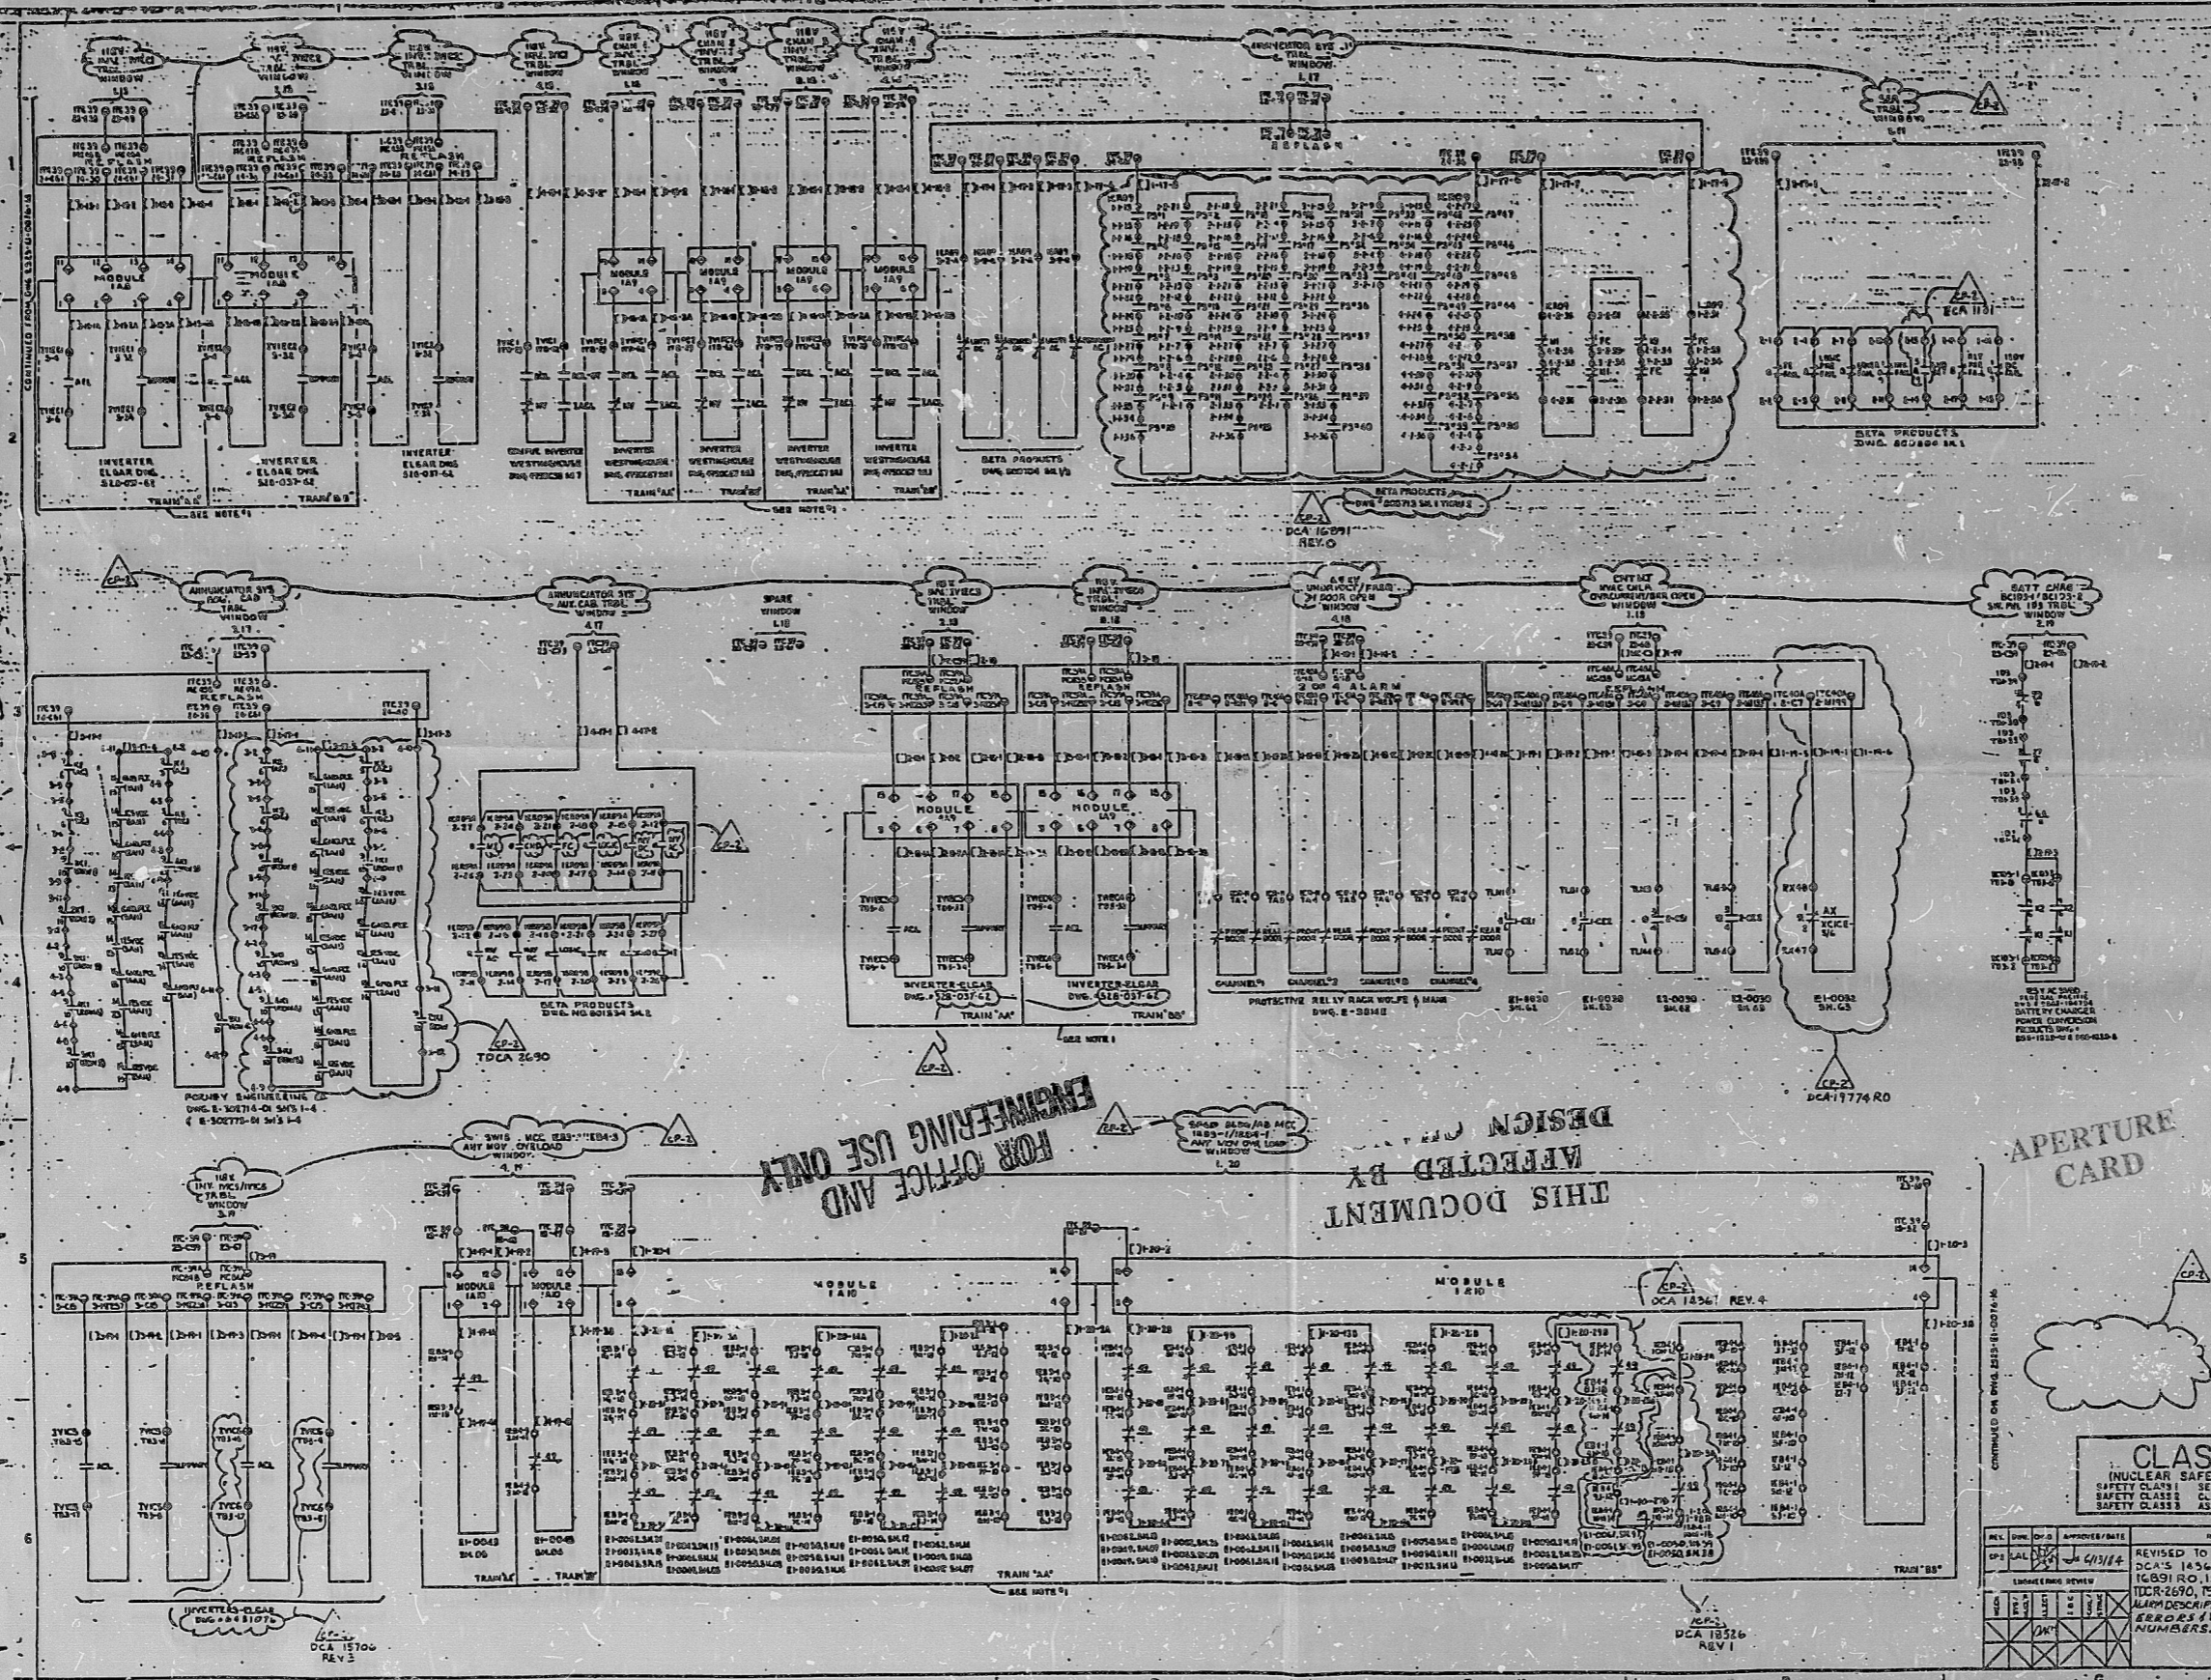

- SYMBOLS**
- INDICATES TERMINAL IN 6" x 12" 3190A CUB. IN. CAB. NO. 24
 - INDICATES TERMINAL IN 8" x 12" 3190A CUB. IN. CAB. NO. 24
 - INDICATES TERMINAL IN 8" x 12" 3190A CUB. IN. CAB. NO. 24
 - INDICATES TERMINAL IN ANNUNCIATOR TERMINATION CABINET
 - INDICATES TERMINAL AT MOTOR CONTROL CENTER
 - INDICATES TERMINAL NO. CONNECTION NO. MCC NO.
 - INDICATES TERMINAL AT PROTECTIVE RELAY BOARD OR RACK
 - INDICATES TERMINAL NO. TERMINAL BLOCK NO. FROM RELAY RACK OR RACK NO.
 - INDICATES TERMINAL AT ANNUNCIATOR LOGIC CABINET
 - INDICATES TERMINAL NO. TERMINAL BLOCK NO. DAY NO. 1-CR-00 BUILT
 - INDICATES TERMINAL NO. TERMINAL BLOCK NO. INVERTER NO. 4
 - INDICATES TERMINAL IN SOLID STATE ISOLATION CABINET ICR-07 (TRAIN 2A)
 - INDICATES TERMINAL IN SOLID STATE ISOLATION CABINET ICR-08 (TRAIN 2B)
 - INDICATES SAFEGUARD BROADCASTING CABINET (SBC) 71-CA-01
 - INDICATES SAFEGUARD BROADCASTING CABINET (SBC) 71-CA-02
 - INDICATES WIRE PREPARE 14000
 - INDICATES TERMINAL AT LOCAL KEYBOX

NOTES

1. ALL WIRING & CABLEING FOR THIS EQUIPMENT IS ASSOCIATED CLASS "B" TRAIN "A" OR "B" AS INDICATED. MODULES ARE CLASS "B" ISOLATION DEVICES.
2. FOR ANNUNCIATOR EXTERNAL CONNECTION PARASITIC SEE PAGE 2323-EI-0077 SERIES G.1323-EI-0078 SERIES.
3. FOR SOLID STATE ISOLATION CABINET EXTERNAL CONNECTION PARASITIC SEE DWG. 2323-EI-0079 SERIES.
4. ALL FIELD CONTACTS OPEN TO ALARM EXCEPT CLOSE TO ALARM WHERE INDICATED BY "C".
5. FOR ACTUAL WINDOW ENGRAVING SEE DWG. 2323-EI-0079 S.H. 23.

REFERENCE DRAWINGS

- 2323-EI-0078 LAMP CAB. I-CR-08. REV. 5.4.1
- 14
- 16

CLASS I
NUCLEAR SAFETY-RELATED
SAFETY CLASS I - SERVICED CATEGORY I
SAFETY CLASS 1 - CLASS I
SAFETY CLASS 3 - ASSOCIATED CIRCUITS

DESIGNED BY	APPROVED BY	DATE	REVISIONS
10900R1

TEXAS UTILITIES GENERATING CO.
ANNUNCIATOR LAMP CABINET
I-CR-10B
SCHEMATIC DIAGRAM S.H. 3

2323-EI-0076-15 CP-2

8906120233

*8906170121

PDR/DF

8906120233

