
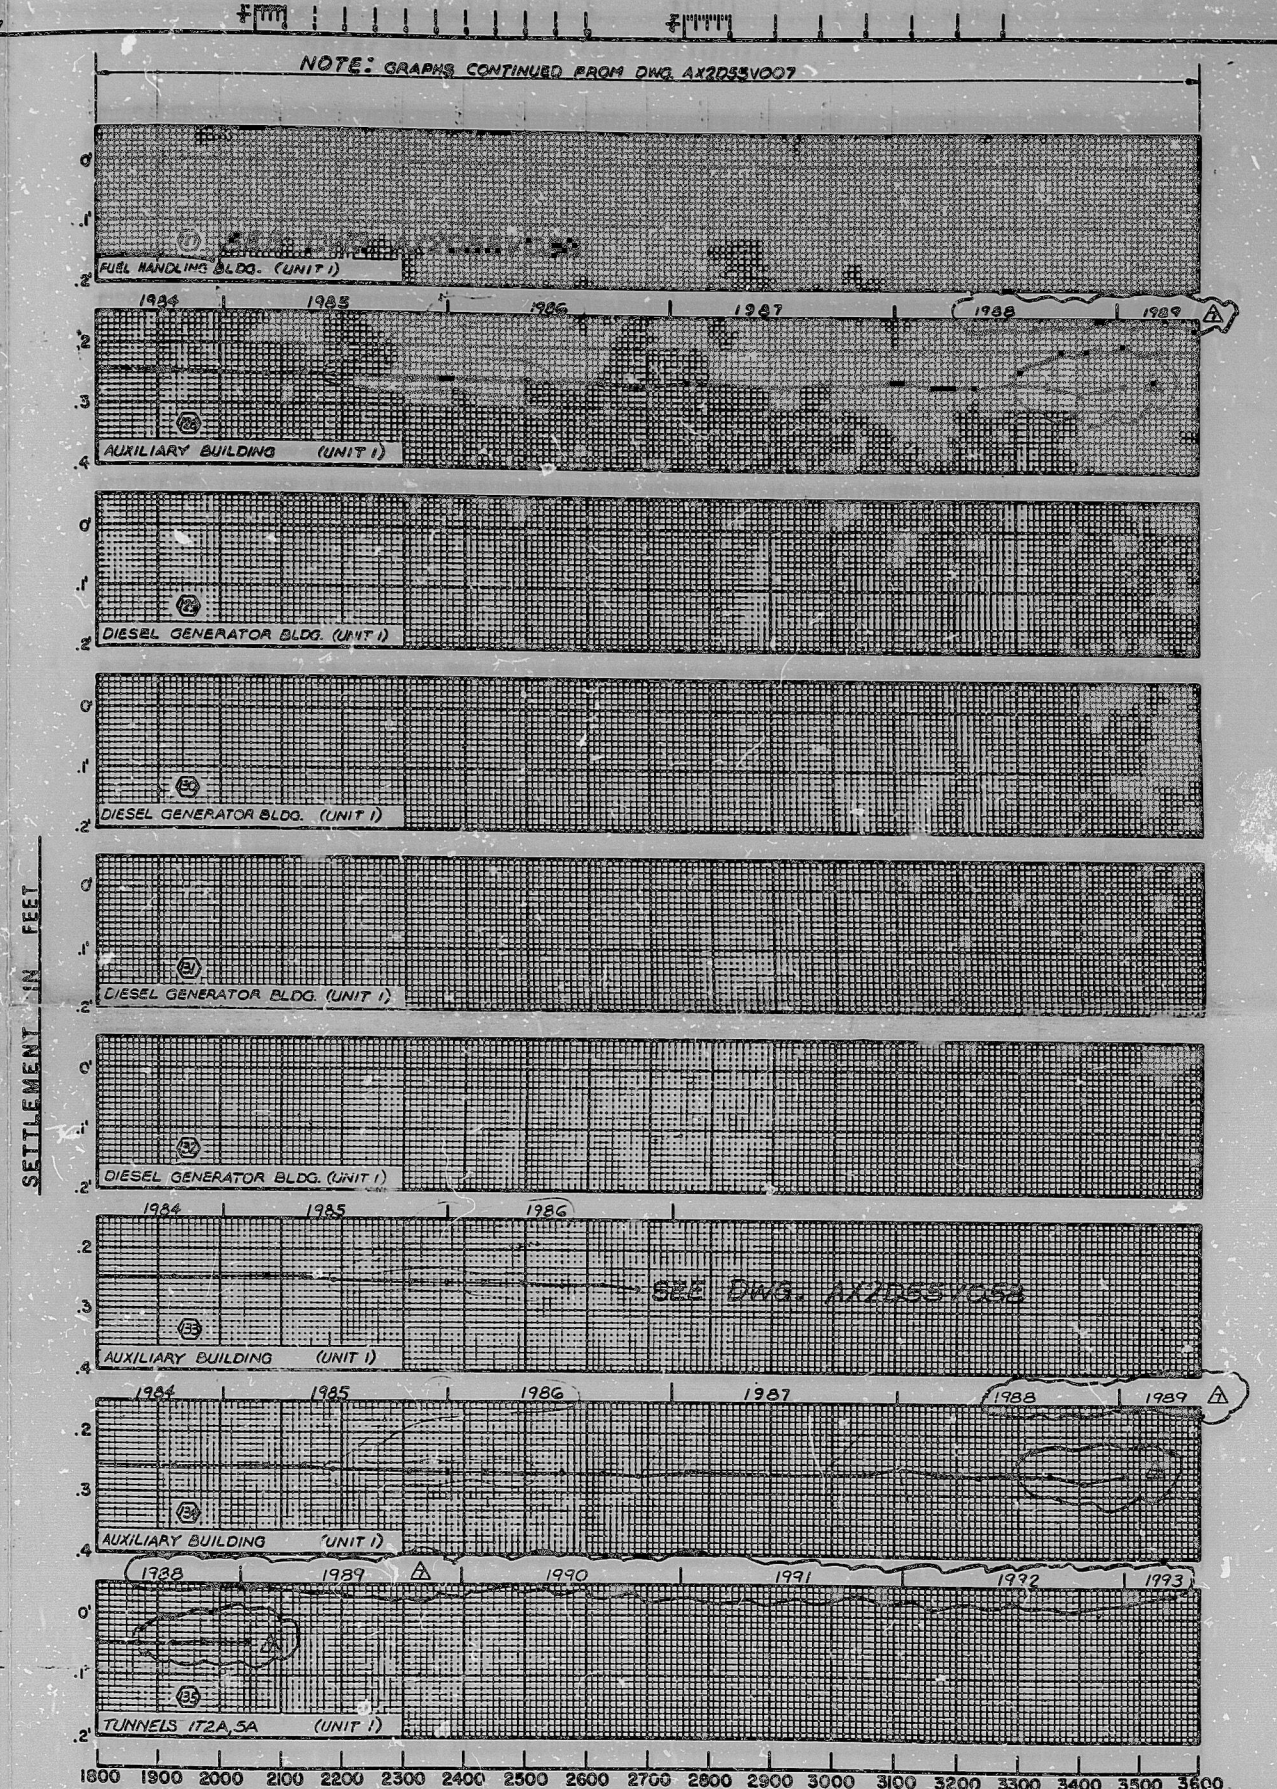


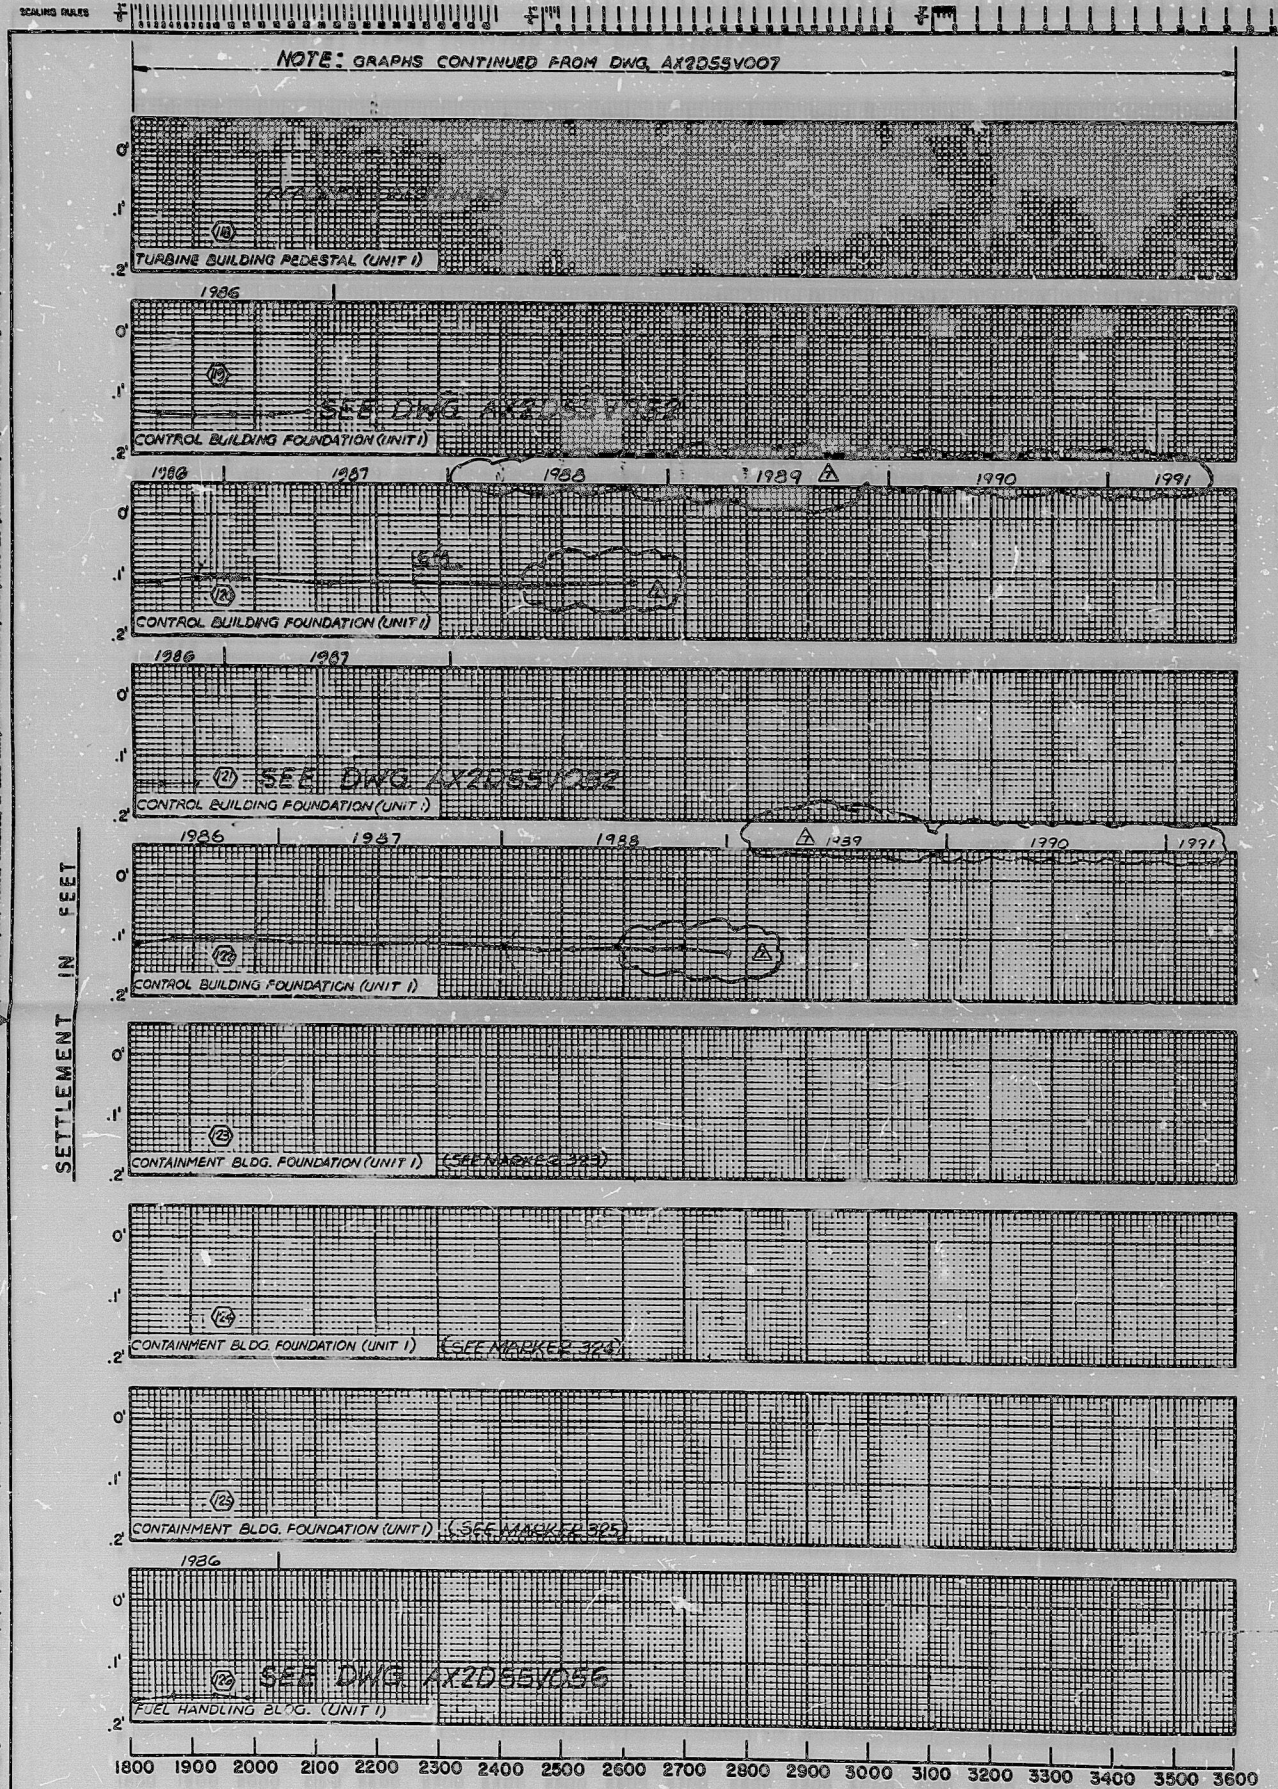

This drawing and the design it covers are the property of BECHTEL. They are loaned to you on the basis of your request and are not to be used for any other project without the written consent of BECHTEL. Any unauthorized use or reproduction of this drawing is prohibited by law.

SI
PERTURE
CARD

NOTE: BEGINNING OF 6-MONTH MONITORING FREQUENCY IS INDICATED BY THE SYMBOL Δ

NO.	REVISIONS	DATE	DR.	CHK.	SLIP	EGS	CH	PE	GA	RA
1										
2										
3										
4										
5										
6										
7										

TIME - DAYS

BECHTEL
LOS ANGELES

GEORGIA POWER COMPANY
ALVIN W. VOGTLE NUCLEAR PLANT

SETTLEMENT OBSERVATION MARKERS
GRAPH SHEET 2A

SCALE: NONE

DRAWING NO. AX2D55V008

JOB NO. 1910

DATE: 11/13

7

8907050481

PDR RIDS

