67 M 4 47VM51-6

WB-02067-880394, SH. 75 OF 100

Prepared By KCS Date 5/4/87

Checked By ABC Date 5/4/87

Legibility evaluated and accepted for issue

W J Schaffer 5/4/87

PART PLAN B6

DETAIL A6

B5-B6

D5-D6

GA 637-
*ASSUMED CONNECTION PT. FOR U2 SDBR WHEN REROUTED. K28 7/30/87

DET F6

PART PLAN M6-EL 565.0

M6-M6 (UNIT 1)

M5-N5

P5-P6

J5-J6

NO.	DESCRIPTION	BY	CK	APP	DATE
1	REVISED SUPPORTS AS PER FCR 84DS, 85DS, 86DS				
2	PER 89	K-11-87	MRS	BWH	GWH	WJS	8/5/87
	REVISED MISC. PIPING VIA & ORDER. PIPING & SUPPORTS				

POWERHOUSE
UNITS 1, 2 & 3
MECHANICAL
EMERGENCY EQUIPMENT
COOLING WATER
BROWNS FERRY NUCLEAR PLANT
TENNESSEE VALLEY AUTHORITY
DIVISION OF CONSTRUCTION, DESIGN

SI APERTURE CARD

30X | GRAPHIC DOCUMENTS | 1 3 2 5 1 | AUG 14 1987

8907100102

PDR RIDS

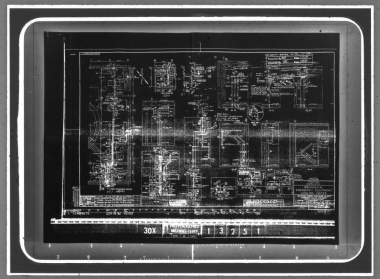

MMM 5824 — FULMSORT® Brand Aperture B Camera Cards and DUPLICARD® Brand Copy Cards — Product of 3M — St. Paul, Minn.