


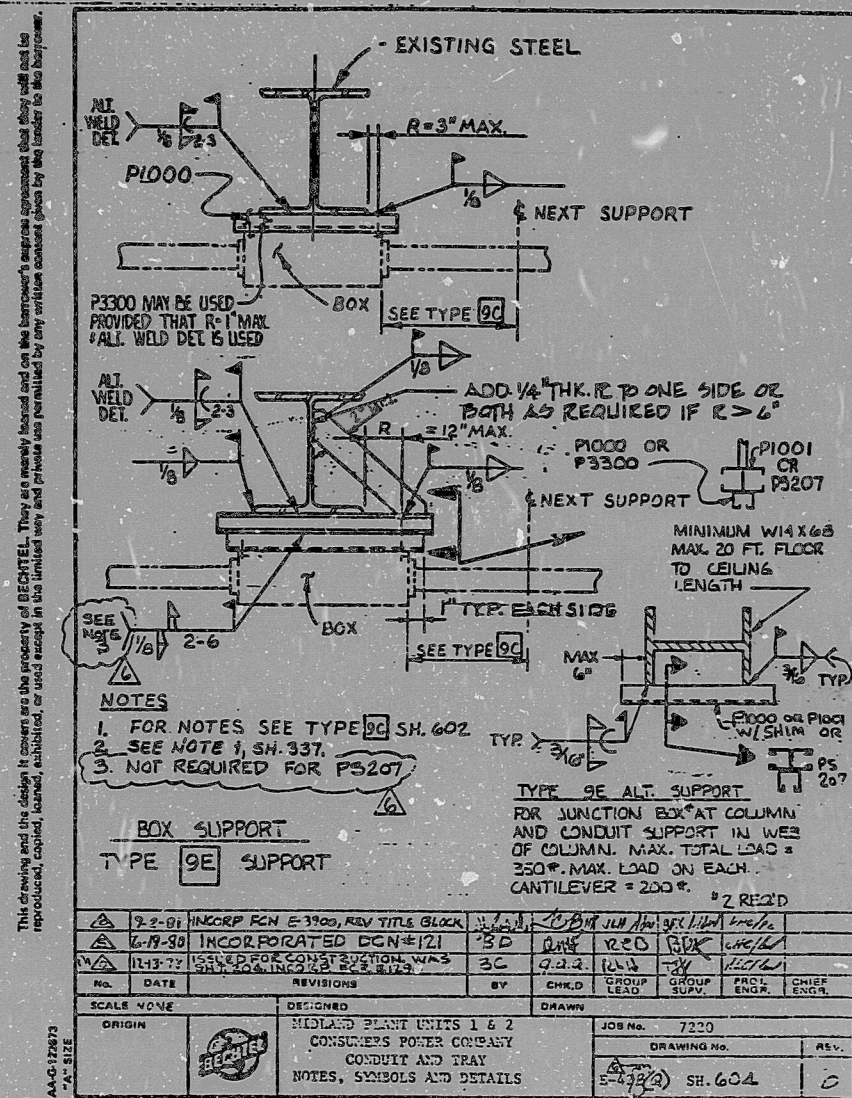

TERA
APERTURE
CARD

16X

"I certify that the image contained on this frame was made in the normal and regular course of business, on the date stated below and that it is an accurate reproduction of the document submitted to the contractor for filming, by Bachtel Power Corporation."

10-23-81 R. Capelle J. Charnas
DATE CAMERA OPERATOR CONTRACTOR'S SUPERVISOR OR MANAGER

RIDS

8201150497

