


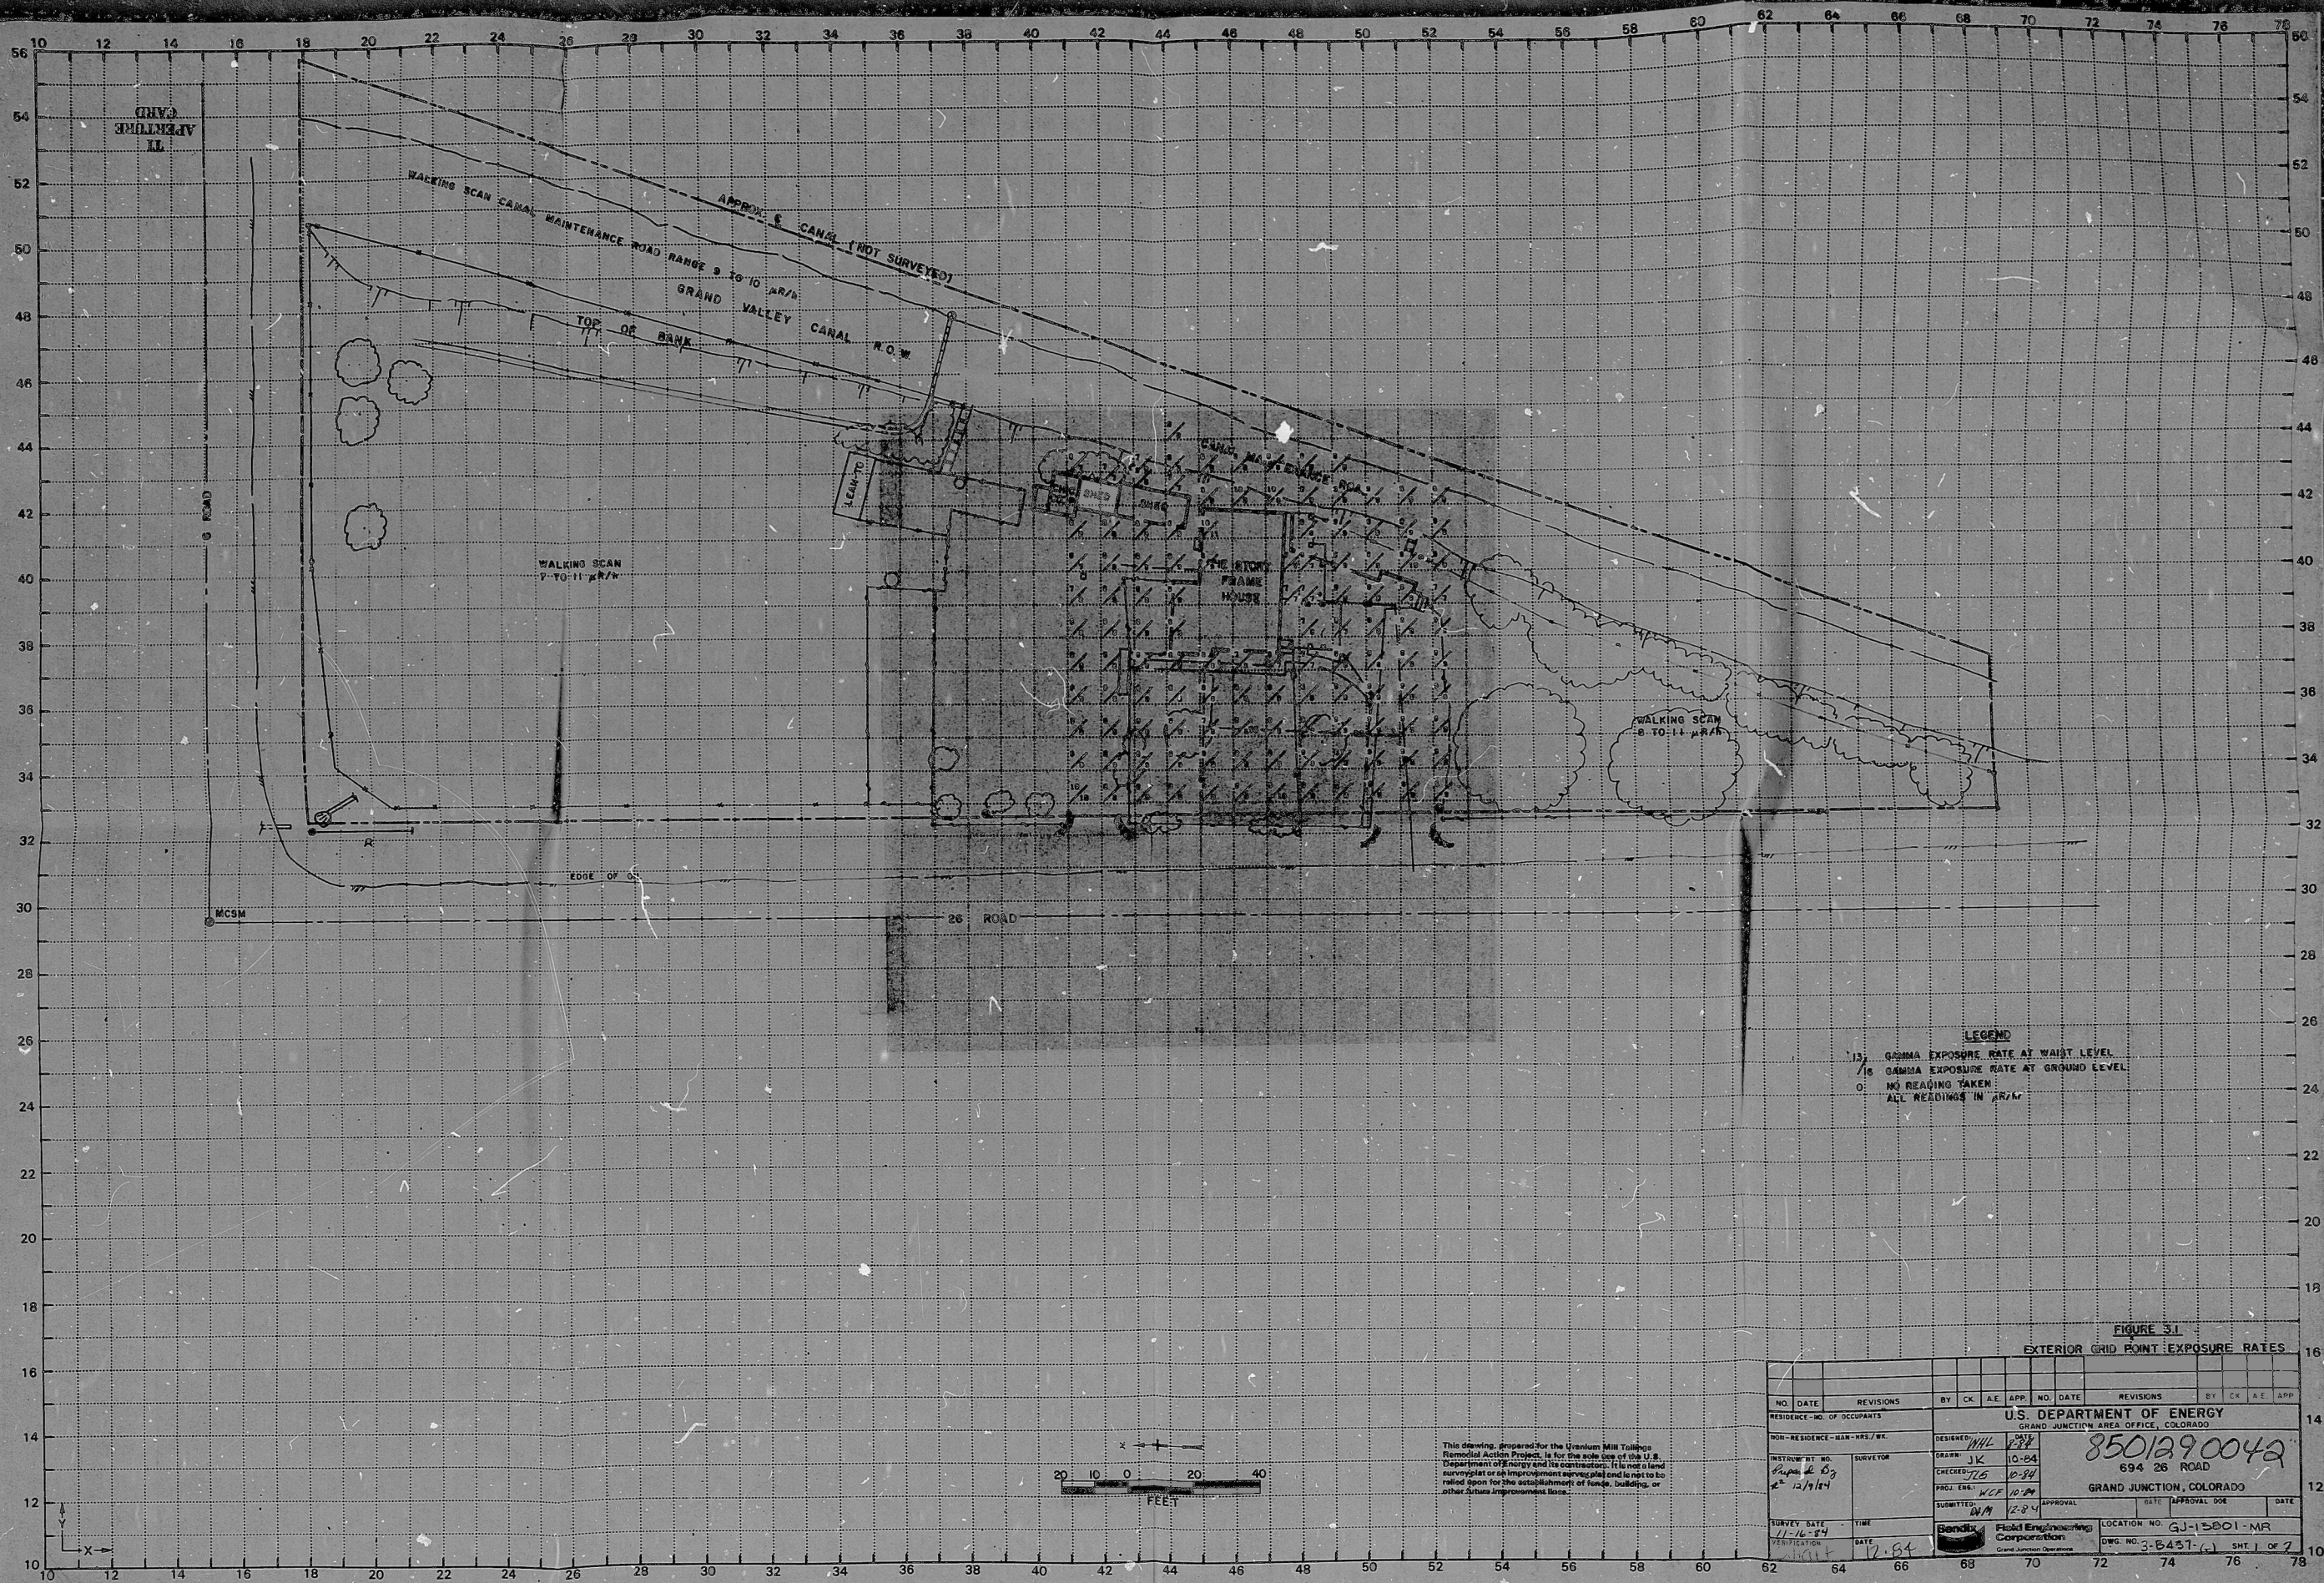

PdR

8501290042

