




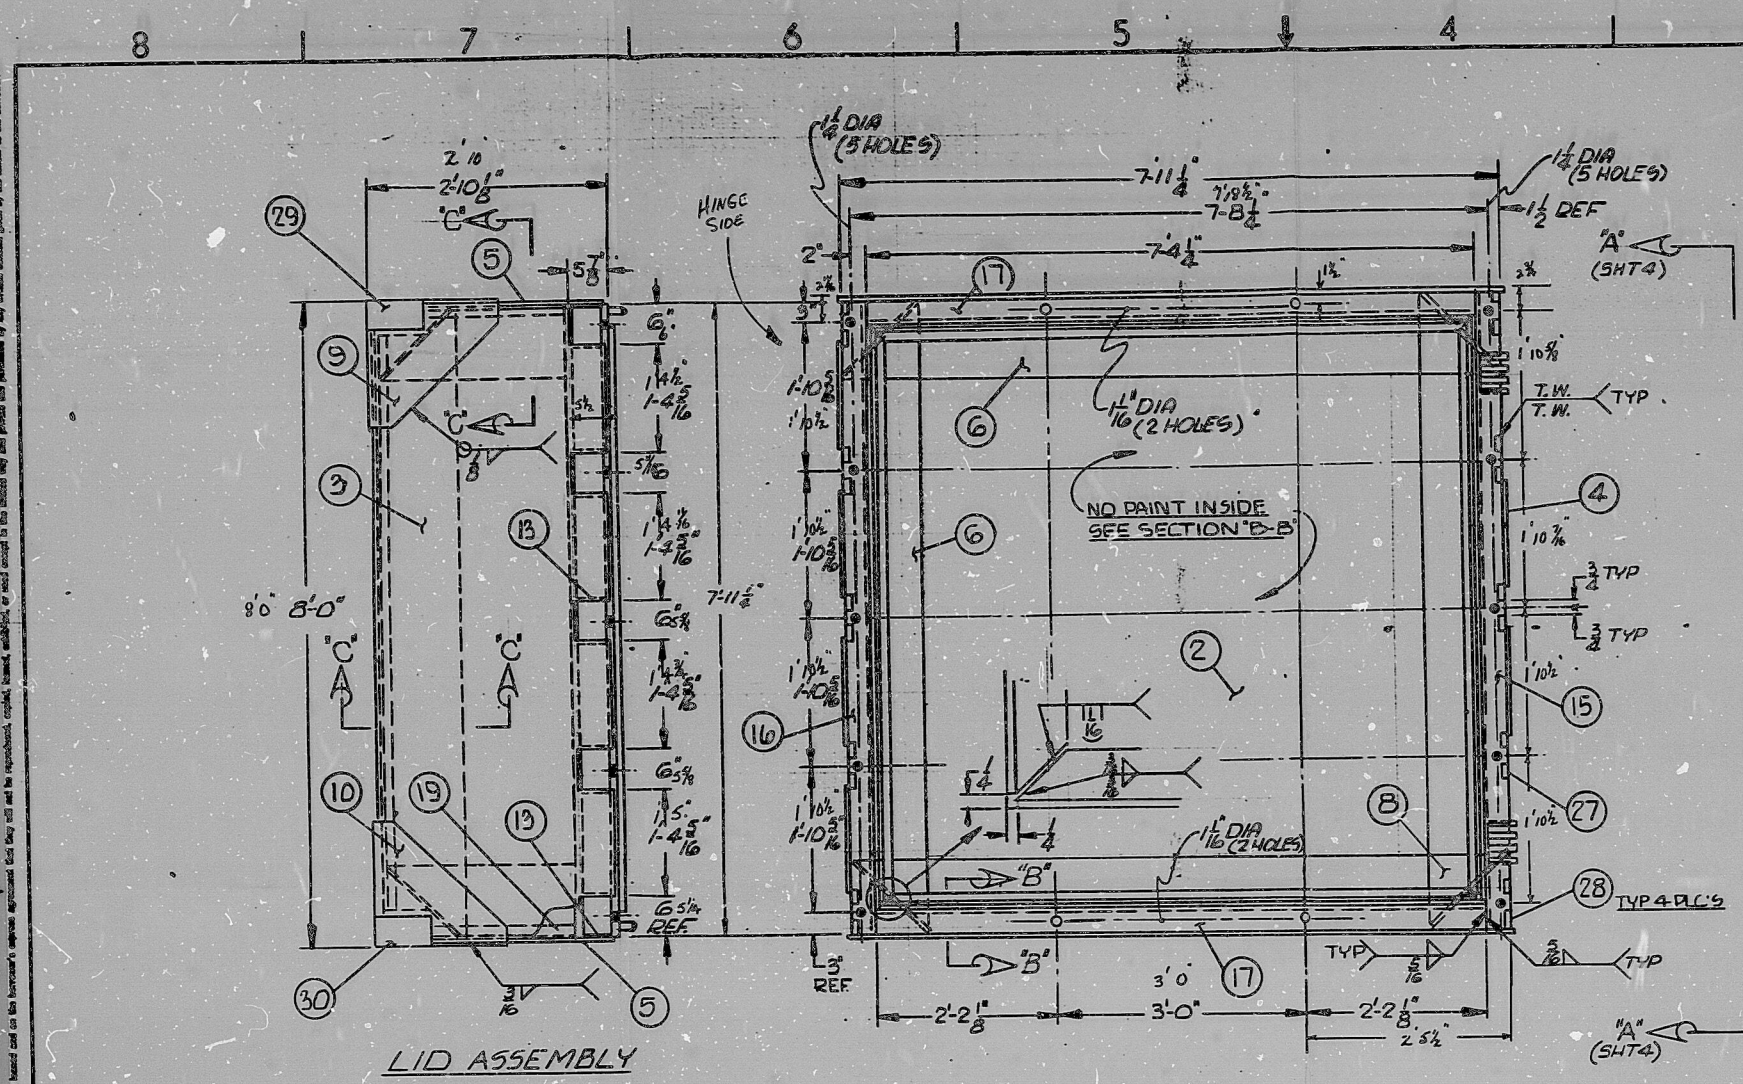

LID ASSEMBLY

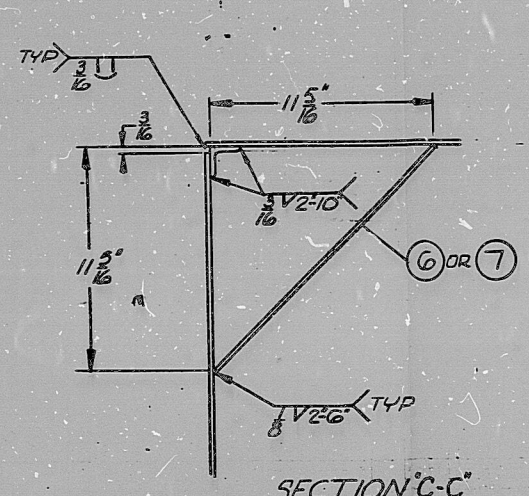

SECTION C-C

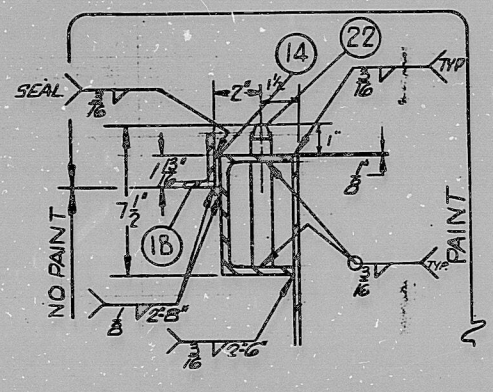

SECTION B-B (ROTATED 90°)

NOTES: UNLESS OTHERWISE SPECIFIED

* SEE SHT 9 FOR DETAILS

REVISIONS		DATE	APPROVED
1	SEE SHT #1		

ITEM	QTY	DESCRIPTION	REF DES
30	2	1.5.0. CASTING 5100 T.R.F	
29	2	1.5.0. CASTING 5100 T.L.F	
28	4	1/8 X 1 BAR X 2 1/4	
27	16	1/8 X 1 BAR X 3"	
26	1	1 1/2 STD HALF COUPLING	
25	4	3/4 R 4 1/8 X 5 3/8	
24	4	3/4 R 4 1/8 X 5 3/8	
23	4	1 1/2 STD PIPE X 2 6 1/4"	
22	4	1 DIA BAR X 7 1/8"	
21	2	L 1 1/2 X 1 1/2 X 3 1/16 X 6 11 1/2"	
20	2	L 1 1/2 X 1 1/2 X 3 1/16 X 7 2 1/2"	
19	4	L 1 1/2 X 1 1/2 X 3 1/16 X 7 9 1/8"	
18	4	L 2 1/2 X 1 1/2 X 3 1/16 X 7 3 1/2"	
17	2	MC 6 X 15.3 X 7 4 1/4"	
16	1	MC 6 X 15.3 X 7 11 1/4"	
15	1	MC 6 X 15.3 X 7 11 1/4"	
14	4	1/8 X 2 BAR X 7 3 1/8"	
13	16	1/8 R 3 1/8 X 5 3/8	
12	4	1/8 R 3 1/8 X 5 3/8	
11	2	3/16 R 3 3/16 X 1 1/2"	
10	2	3/16 R 3 3/16 X 3 3/8"	
9	2	3/16 R 3 3/16 X 3 3/8"	
8	4	12 GA 1 1/2 X 1 1/2 X 1 1/2"	
7	4	12 GA 1 1/2 X 1 1/2 X 1 1/2"	
6	4	12 GA 1 1/2 X 1 1/2 X 1 1/2"	
5	2	3/16 R 2 9 1/16 X 7 11 1/8"	
4	1	3/16 R 2 9 1/16 X 7 10 7/8"	
3	1	3/16 R 2 9 1/16 X 7 10 7/8"	
2	1	3/16 R 7 10 7/8 X 7 10 7/8"	
1	1	LID ASSEMBLY	

ITEM	QTY	DESCRIPTION	REF DES
1	1	LID ASSEMBLY	

UNLESS OTHERWISE SPECIFIED	PROTECTIVE PACKAGING, INC.
TOLERANCES: FRACTIONS:	
ANGLES:	
3 PLACE DECIMALS:	
2 PLACE DECIMALS:	
1 PLACE DECIMALS:	
DIMENSIONS ARE IN INCHES	
DRAWN: S. J. J.	12/1/74
CHECK:	
ENG:	
Q.A.	
DWG. REL.	

QTY	DESCRIPTION	REF DES
32395	LID ASSEMBLY	
B	APERTURE CARD	

SCALE	1" = 1'-0"	WT.	SHEET 3 OF 5
-------	------------	-----	--------------

8006060179

PDR

8006060179

