
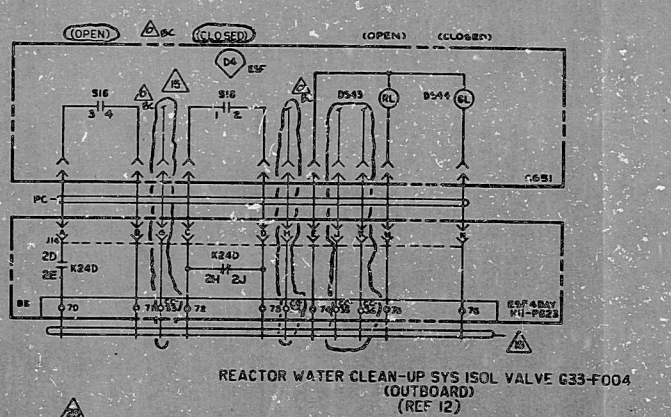
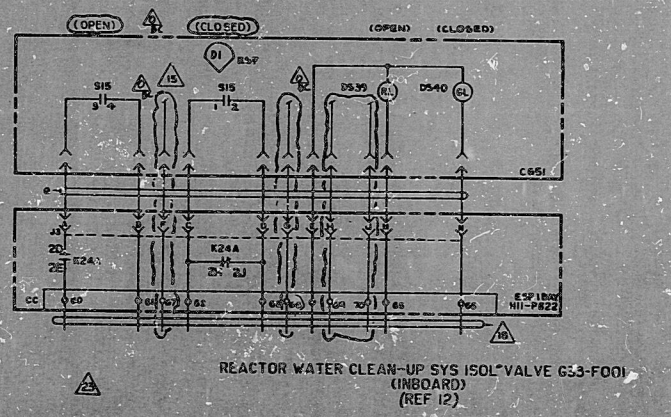
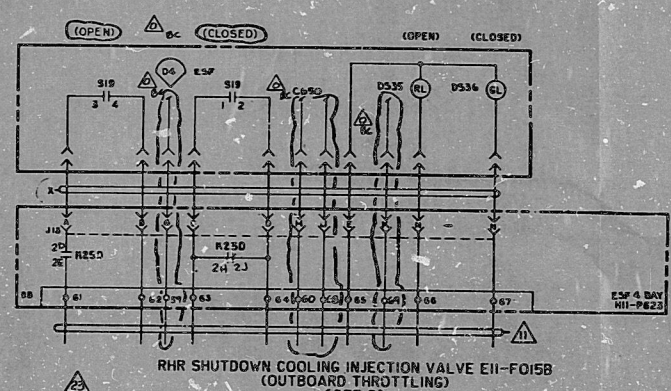
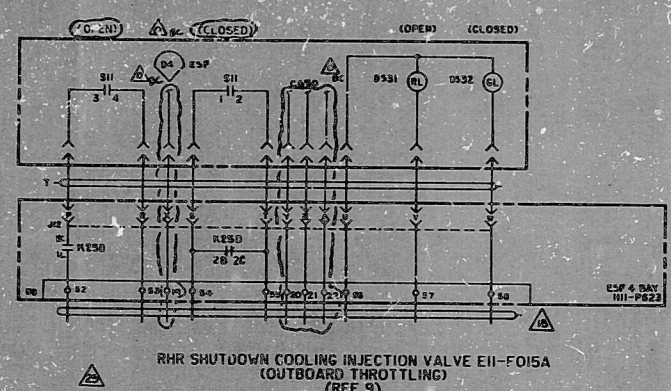
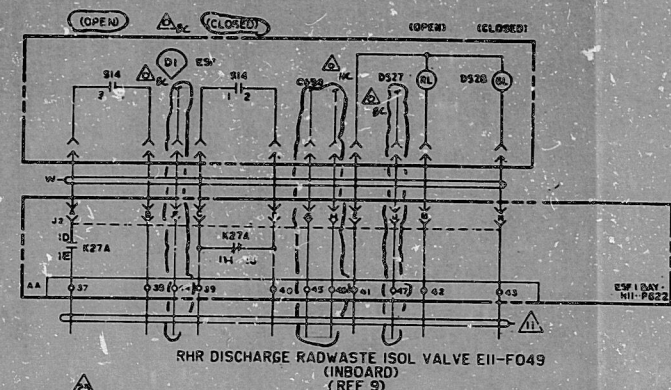


10055-N		521-1090	

RIDS

8398050081

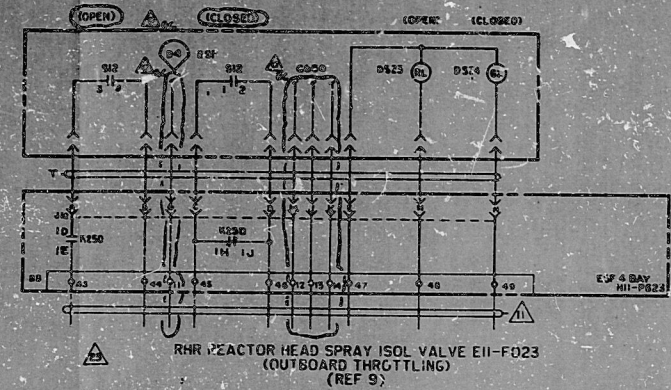