



J-102-0 SHT. 3

LOGIC CABINET AC652

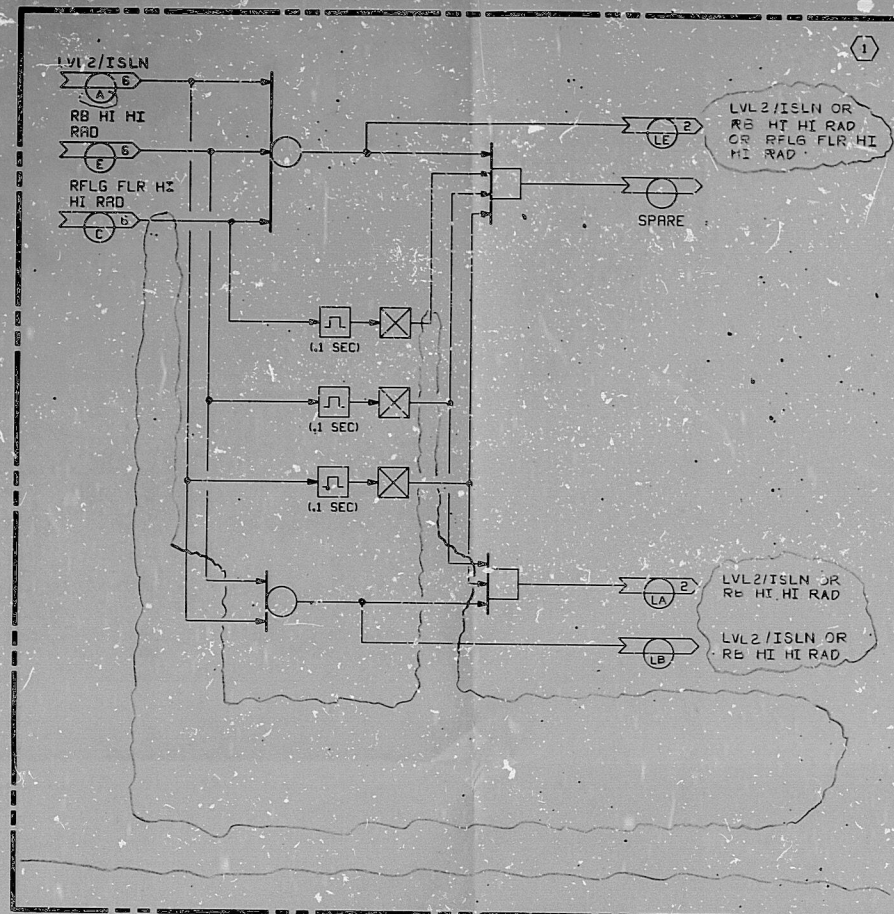

HIGH RADIATION AND LVL 2/ISLN SIGNALS COMBINATION
CLASS 1E CHANNEL A

LOGIC CABINET BC652

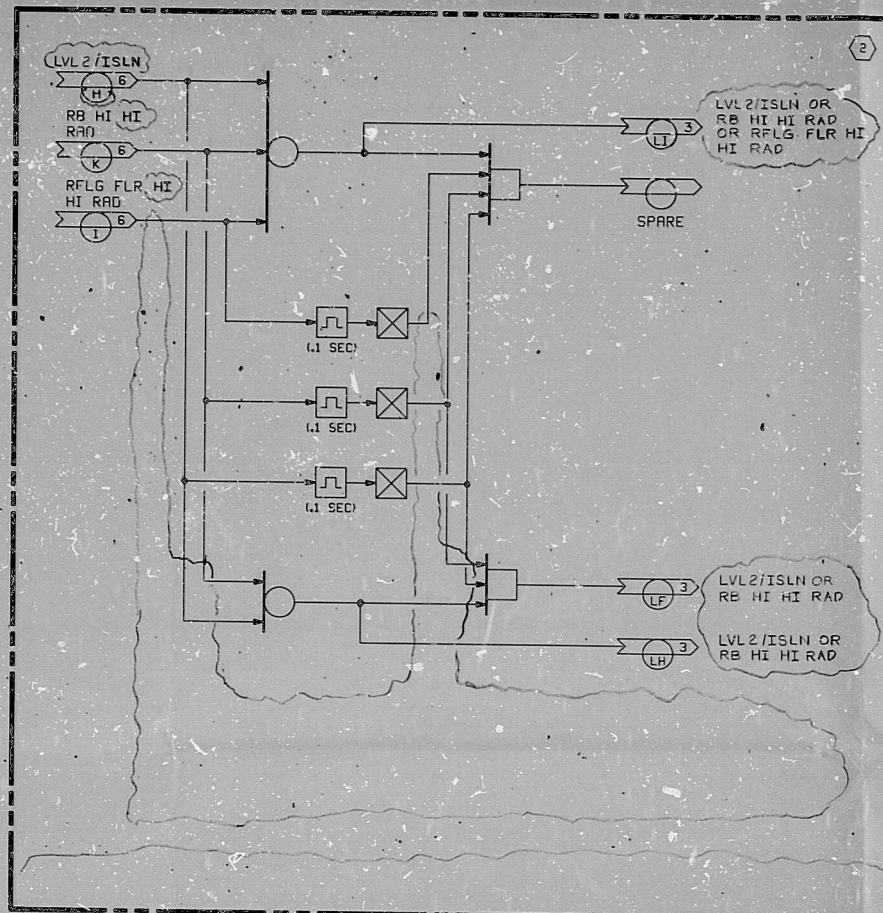

HIGH RADIATION AND LVL 2/ISLN SIGNALS COMBINATION
CLASS 1E CHANNEL B

PRO
APERTURE
CARD

△									
△									
△									
△	6/1/72	DESIGN FREEZE ISSUE							
△	10/1/72	NEW SHEET REQUIRED TO INCORPORATE DCN#1, 2 & 3							
△	DATE	REVISIONS	BY	CHKD	DESIGN	ENTER	APPR		
SCALE	NONE	DESIGNED	SC	DRAWN	CRD				
BECHTEL SAN FRANCISCO									
PUBLIC SERVICE ELECTRIC AND GAS COMPANY HOPE CREEK GENERATING STATION									
LOGIC DIAGRAM HIGH RADIATION & LOCA/ISLN SIGNALS FANOUT CH A & B HIGH RADIATION & LVL 2/ISLN SIGNALS COMBINATION									
JOB No.		DRAWING No.		REV.					
10855		J-102-0		SHT. 3		REV. 1 Q			

S/U-SP, SM

This drawing and the design it covers are the property of BECHTEL. They are hereby loaned to the borrower's express agreement that they will not be reproduced, copied, loaned, exhibited, nor used in any way without written consent given by the lender to the borrower.

RIDS

8308050131

