


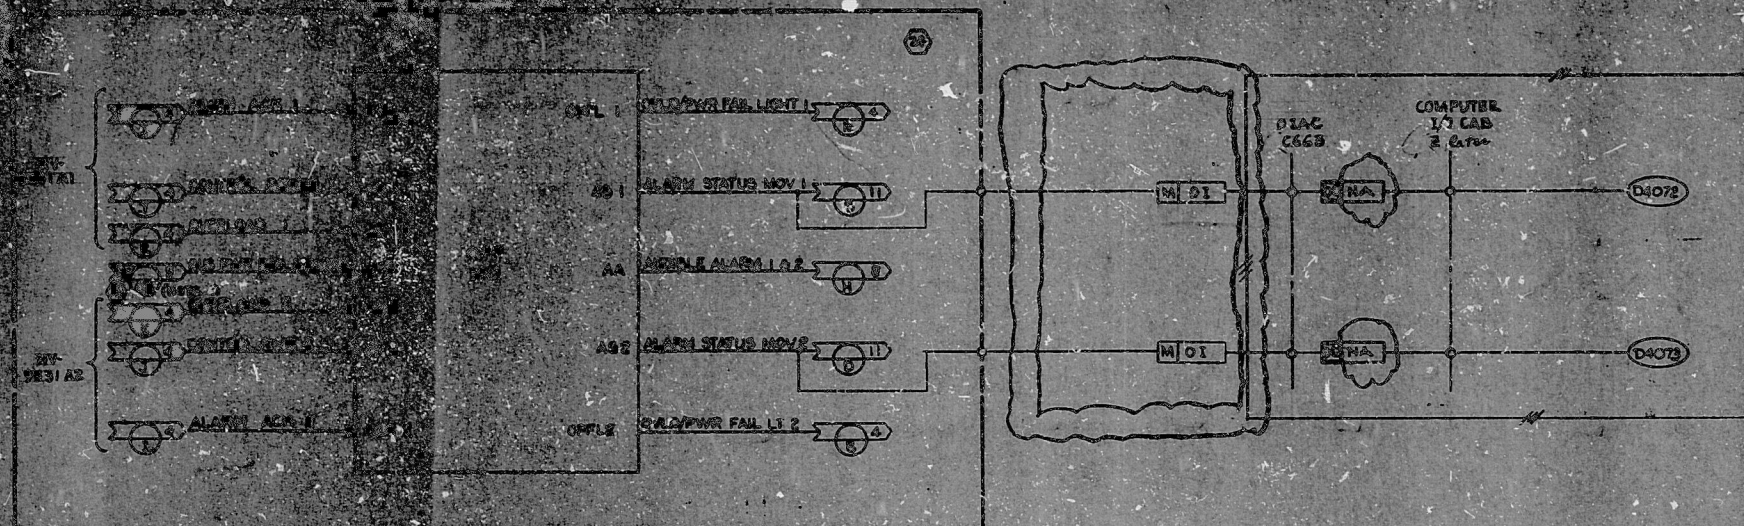

CROSS REFERENCE TABLE

SERVICE	OFF MON CRT. NO	IN PUT ARROWS				CHANNEL	OUTPUT ARROWS				COMPUTER I/O CABINET OR
		VALUE NO.	YCH	CH	CH		CH	CH	CH	CH	

NOTES
1. EVENTS FOLLOWING RESTORATION OF BUS POWER

PRO
APERTURE
CARD

1	2	
---	---	---	---	---	---	---	---	---	----	----	-----

RIDS

8308050351

