


9527-F-3044

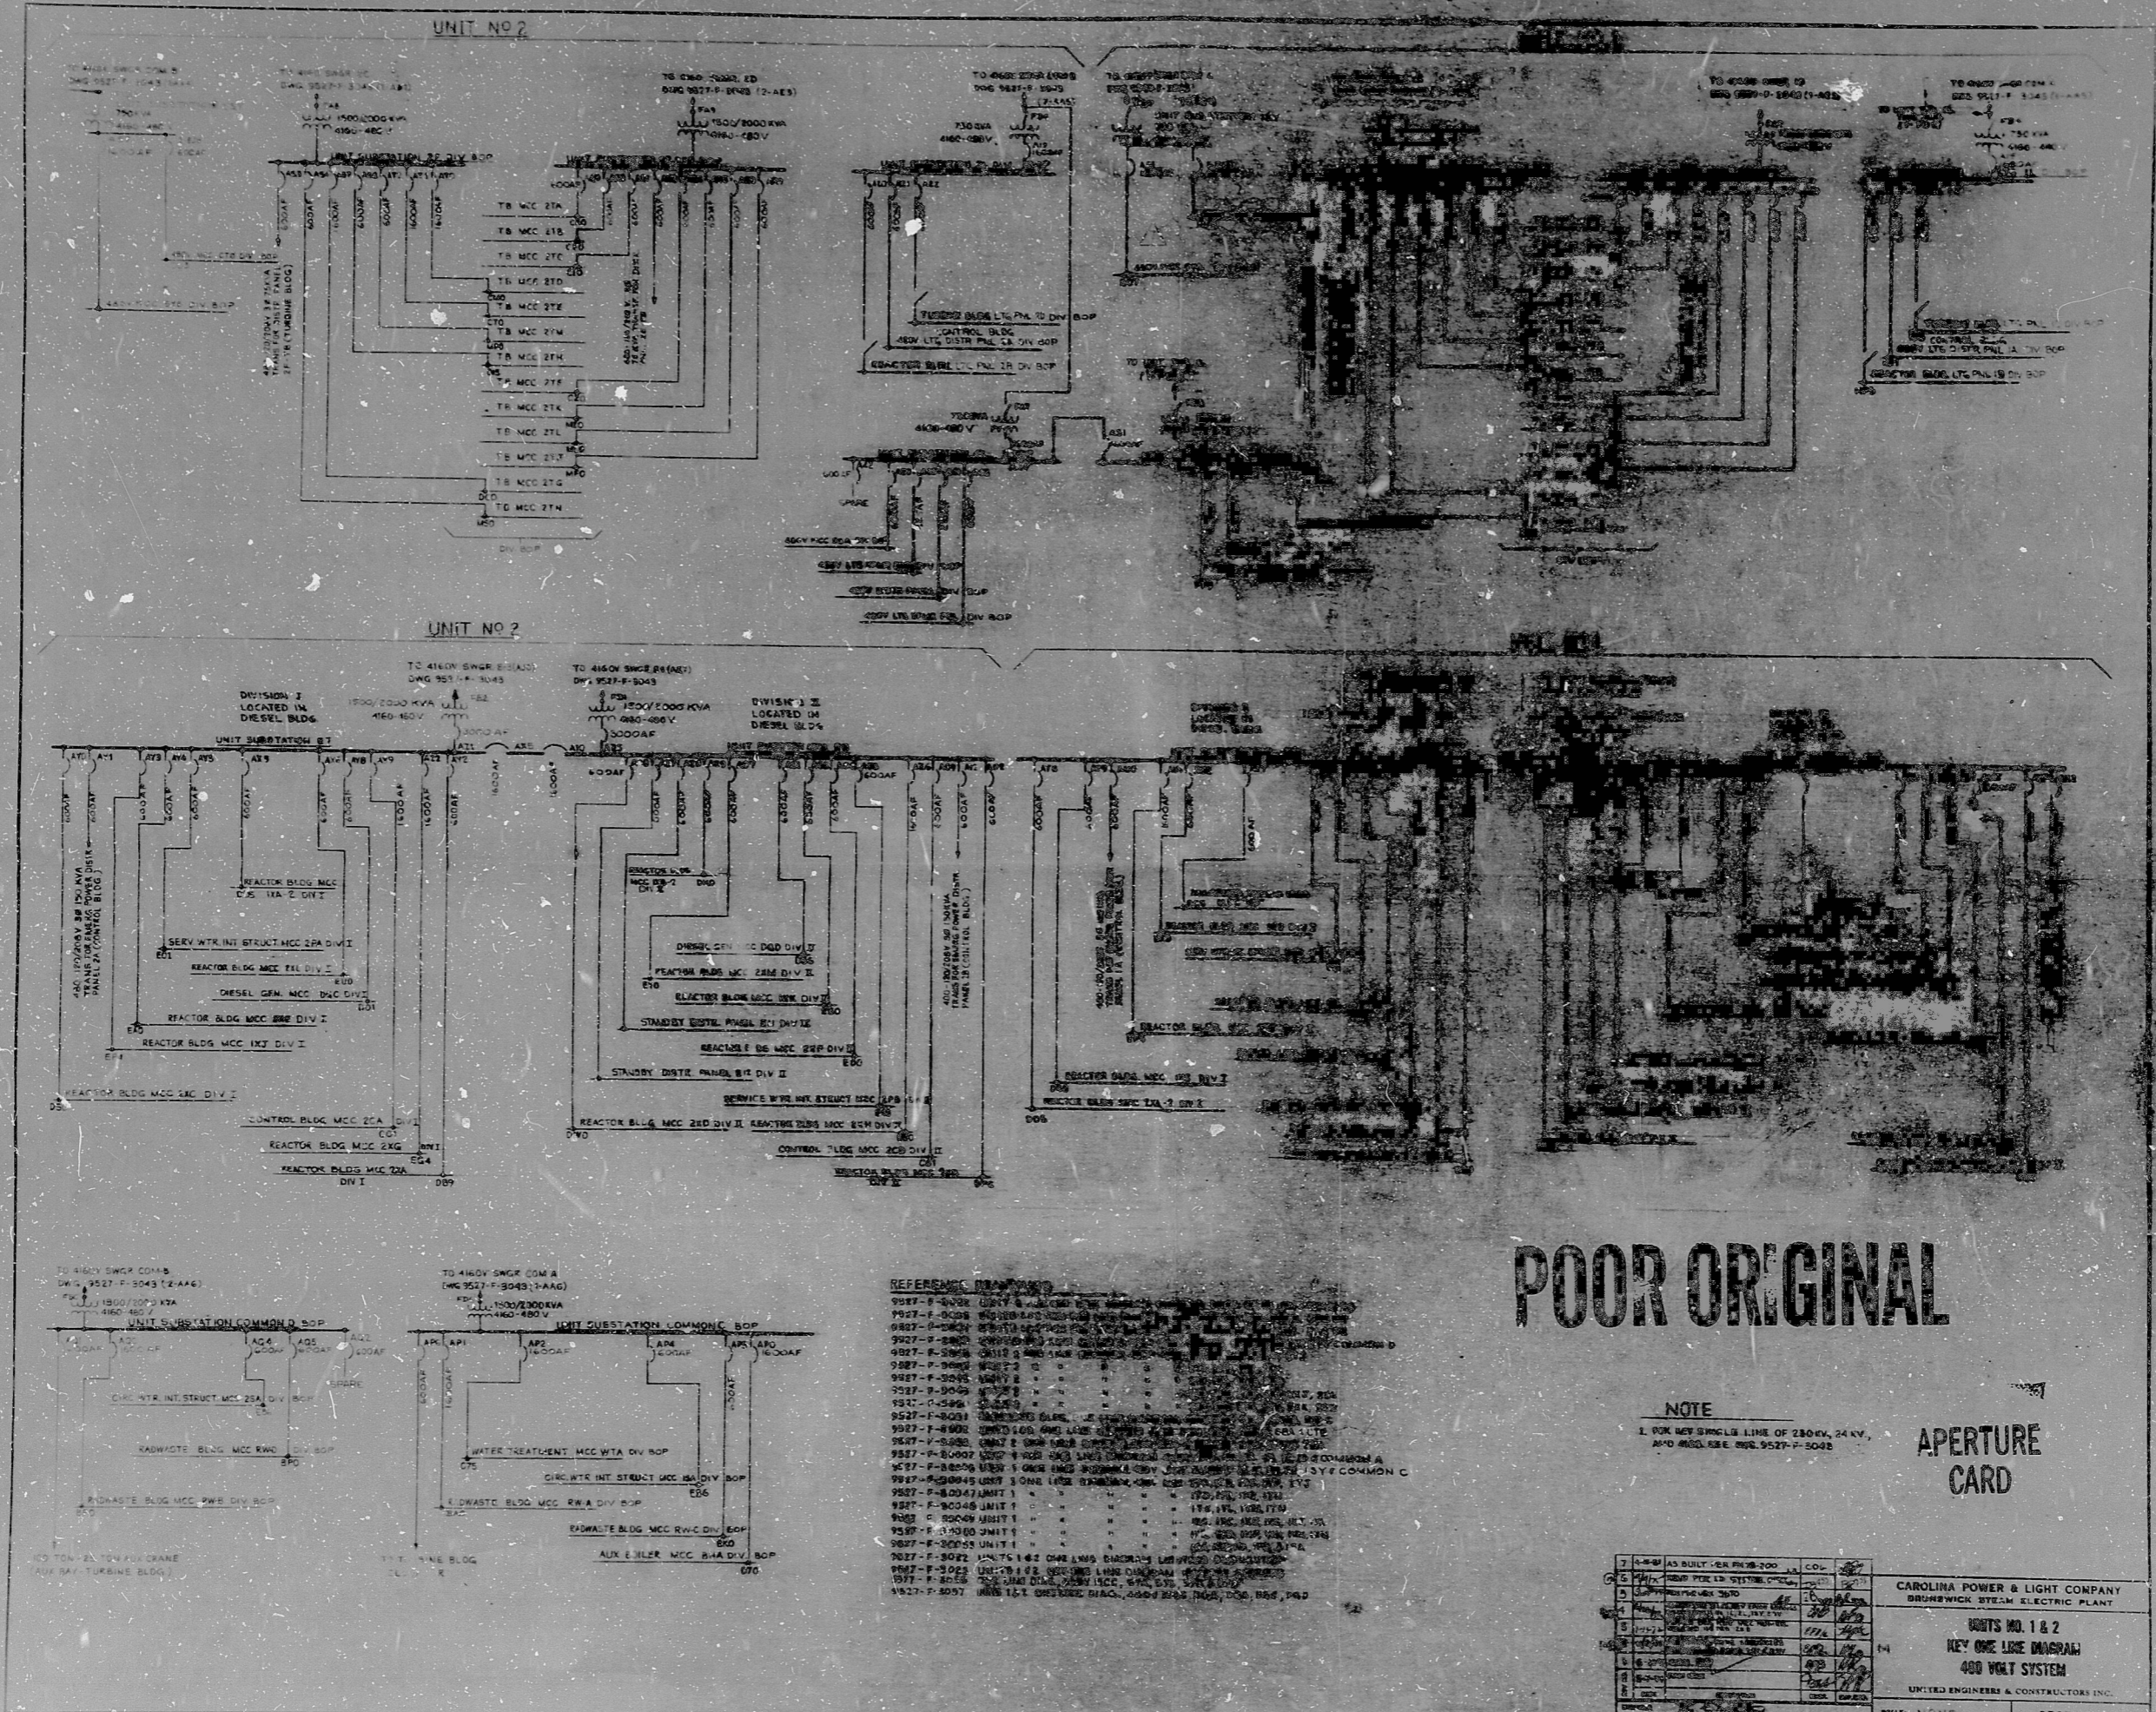

41

41

59

85"

11"

17"

FOR INFORMATION ONLY
UNCONTROLLED COPY

POOR ORIGINAL

NOTE
1. FOR KEY SINGLE LINE OF 280V, 24V,
AND 480V SEE 9527-F-3044

**APERTURE
CARD**

REFERENCES

9527-F-3044	UNIT 2 ELECTRICAL KEY
9527-F-3045	UNIT 2 ELECTRICAL KEY
7	AS BUILT - GR. 100-200	COL.	

CAROLINA POWER & LIGHT COMPANY
BRUNSWICK STEAM ELECTRIC PLANT
UNITS NO. 1 & 2
KEY ONE LINE DIAGRAM
480 VOLT SYSTEM
UNITED ENGINEERS & CONSTRUCTORS INC.
SCALE: NONE 9527-F-3044

820203062

17"

8202030262

