




RIDS

8308050484

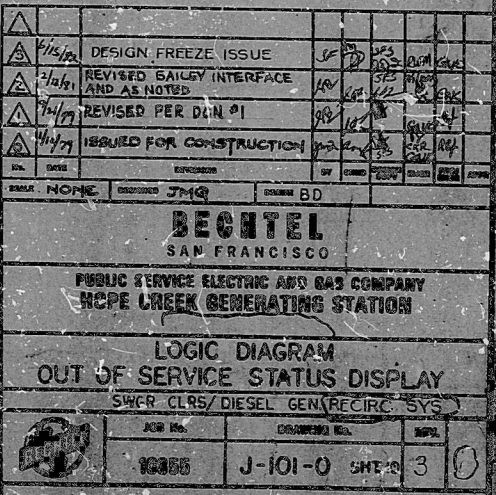