
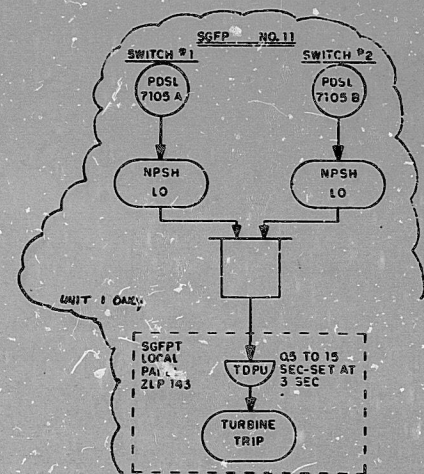


97 40482

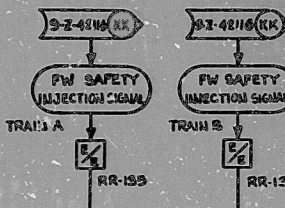

SERVICE	SGFPT LOCAL PANEL	NPSH TRIP	
		SWITCH #1	SWITCHES SWITCH #2
PUMP #1	ZLP-143	PD5L-7105A	PD5L-7105 B
PUMP #2	ZLP-144	PD5L-7110A	PD5L-7110 B
PUMP #3	ZLP-145	PD5L-7115A	PD5L-7115 B

SGPT NO	HIGH VIBRATION INBOARD/ OUTBOARD				THRUST BEARING	HEAR
	NO	PROXIMITY	NON TOR	TRIP LRP	REPAIRING	WIP
11	X	NVM-X10304	NVM-X10304L	NVM-X10304SL	NVM-X10304F	NVM-X10304PF
	Y	NVM-X10304	NVM-X10304L	NVM-X10304SL	NVM-X10304F	NVM-X10304PF
	X	NVM-X10304E	NVM-X10304L	NVM-X10304SL	NVM-X10304F	NVM-X10304PF
	Y	NVM-X10304E	NVM-X10304L	NVM-X10304SL	NVM-X10304F	NVM-X10304PF
	X	NVM-X10304A	NVM-X10304AL	NVM-X10304AL	NVM-X10304F	NVM-X10304PF
	Y	NVM-X10304A	NVM-X10304AL	NVM-X10304AL	NVM-X10304F	NVM-X10304PF
12	X	NVM-X10305	NVM-X10305L	NVM-X10305SL	NVM-X10305F	NVM-X10305PF
	Y	NVM-X10305	NVM-X10305L	NVM-X10305SL	NVM-X10305F	NVM-X10305PF
	X	NVM-X10305E	NVM-X10305L	NVM-X10305SL	NVM-X10305F	NVM-X10305PF
	Y	NVM-X10305E	NVM-X10305L	NVM-X10305SL	NVM-X10305F	NVM-X10305PF
	X	NVM-X10305A	NVM-X10305AL	NVM-X10305AL	NVM-X10305F	NVM-X10305PF
	Y	NVM-X10305A	NVM-X10305AL	NVM-X10305AL	NVM-X10305F	NVM-X10305PF
13	X	NVM-X10306	NVM-X10306L	NVM-X10306SL	NVM-X10306F	NVM-X10306PF
	Y	NVM-X10306	NVM-X10306L	NVM-X10306SL	NVM-X10306F	NVM-X10306PF
	X	NVM-X10306E	NVM-X10306L	NVM-X10306SL	NVM-X10306F	NVM-X10306PF
	Y	NVM-X10306E	NVM-X10306L	NVM-X10306SL	NVM-X10306F	NVM-X10306PF
	X	NVM-X10306A	NVM-X10306AL	NVM-X10306AL	NVM-X10306F	NVM-X10306PF
	Y	NVM-X10306A	NVM-X10306AL	NVM-X10306AL	NVM-X10306F	NVM-X10306PF

NUCLEAR SAFETY RELATED				0
STEAM GENERATOR FEEDWATER PMP.				
TURBINE CUSTOMER TRIPS				
LOGIC DIAGRAM				
SYSTEM: FW				
SCALE	JOB NO.	DRAWING NO.		REV
NONE	14926	5S-13-9-7-40482#1		5

890727042

PDR RIDS

