

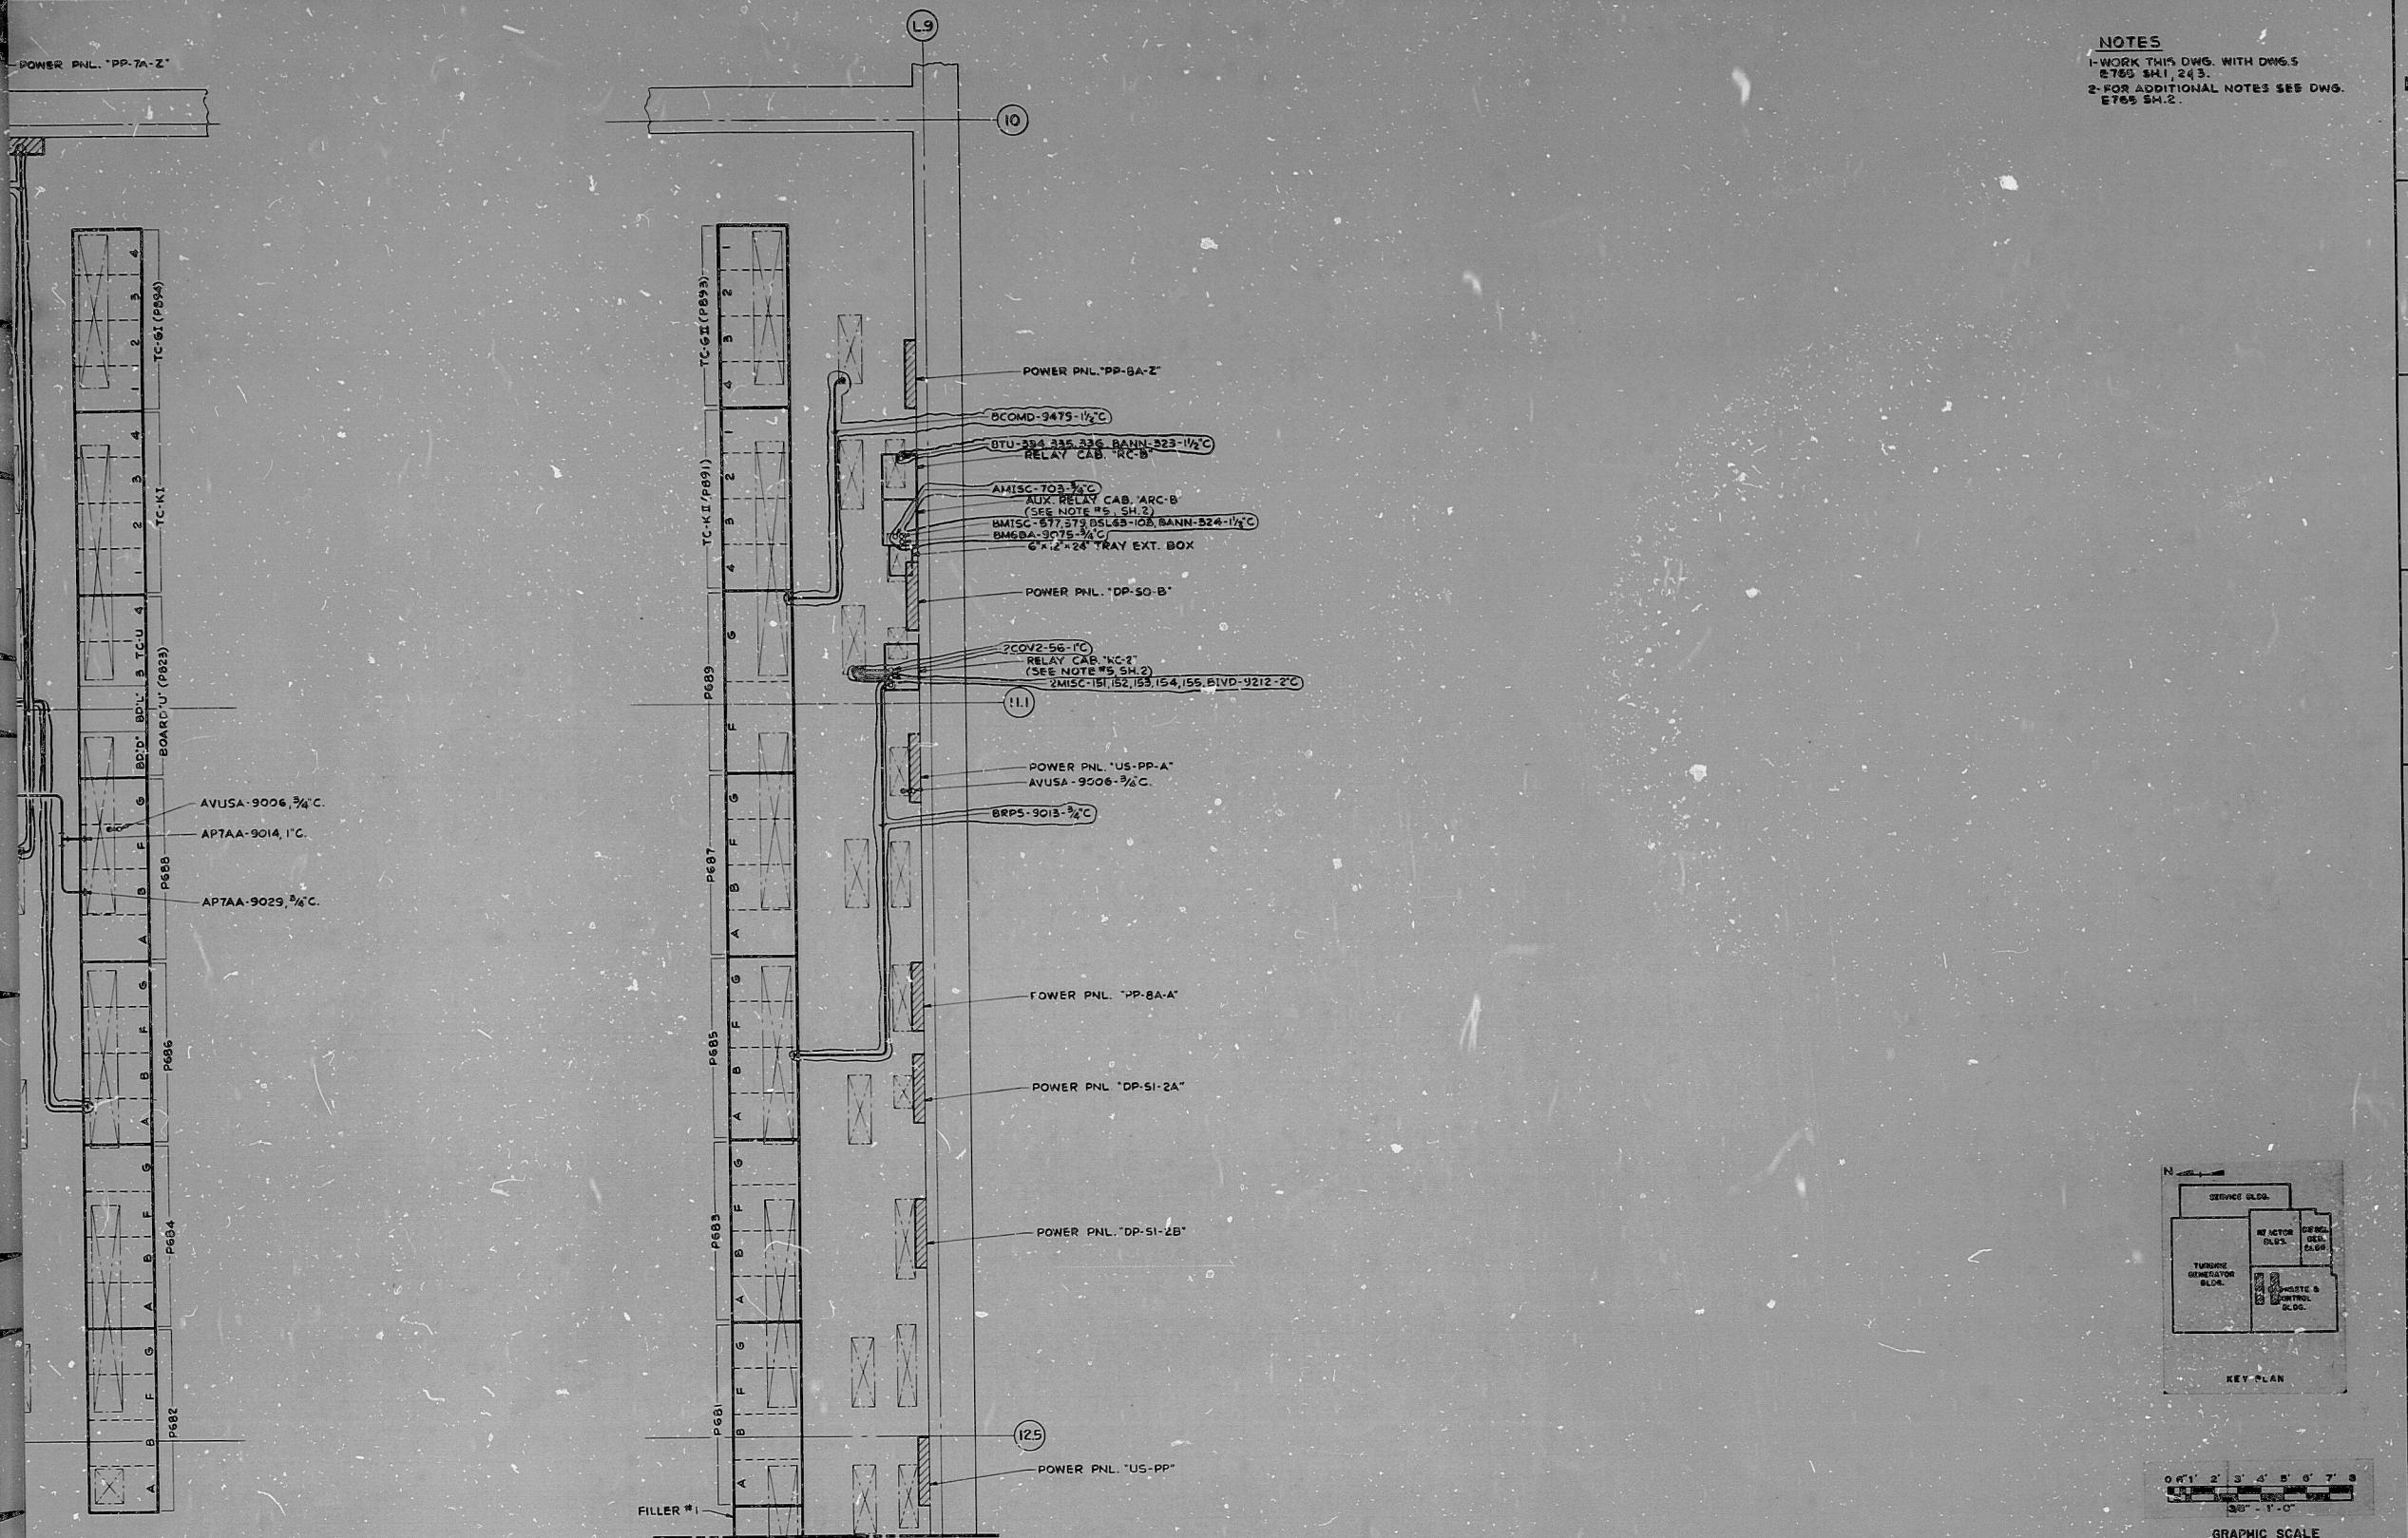


13 12 11 10 9 8 7 6 5 4 3 2 1

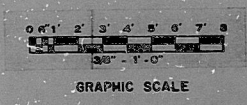

NOTES
 1-WORK THIS DWG. WITH DWG. 5 E765 SH.1, 2, 3.
 2-FOR ADDITIONAL NOTES SEE DWG. E765 SH.2.

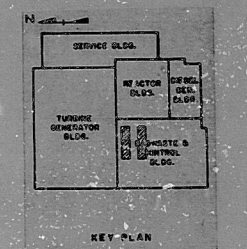

ENLARGED PART PLAN
 CONTROL ROOM EL. 501'-0"
 SCALE: 3/8" = 1'-0"
 (ALL CONTROL RM. CONDUITS TO BE RUN IN RAISED FLOOR UNLESS OTHERWISE NOTED.)

TERA APERTURE CARD

BURNS AND ROE, INC.
 ENGINEERS AND CONSTRUCTORS
 ORADELL, N. J. HEMPSTEAD, N. Y. LOS ANGELES, CALIF.
 RADWASTE & CONTROL BUILDING
 ELEVATIONS 501'-0" & 507'-0"
 INSTA. & CONTR. COND. & TRAY PLAN SH. 4
 WASHINGTON PUBLIC POWER SUPPLY SYSTEM
 HANFORD No. 2

REV. NO.	REVISION	DATE	BY	CHKD.	APPROVED	RELEASED FOR	BY	DATE
0	CONTRACT 213: DWG. APPROVED FOR CONSTRUCTION. PER TASK 8500 INCORPORATED PER 218-E-1816	11/18/79	AM	JIS	JIS	CONSTRUCTION		
1	PER TASK 8500 INCORPORATED PER 218-E-1715, 2429, 5065, 5075, 5081, 5085, 5090	12/6/80	AM	JIS	JIS	CONSTRUCTION		

13 12 11 10 9 8 7 6 5 4 3 2 1

PDR

8007010032

