


This drawing and the design it covers are the property of BECHTEL. They are merely loaned and on the borrower's express agreement that they will not be reproduced, copied, loaned, exhibited, or used except in the private use permitted by any written consent given by the lender to the borrower.

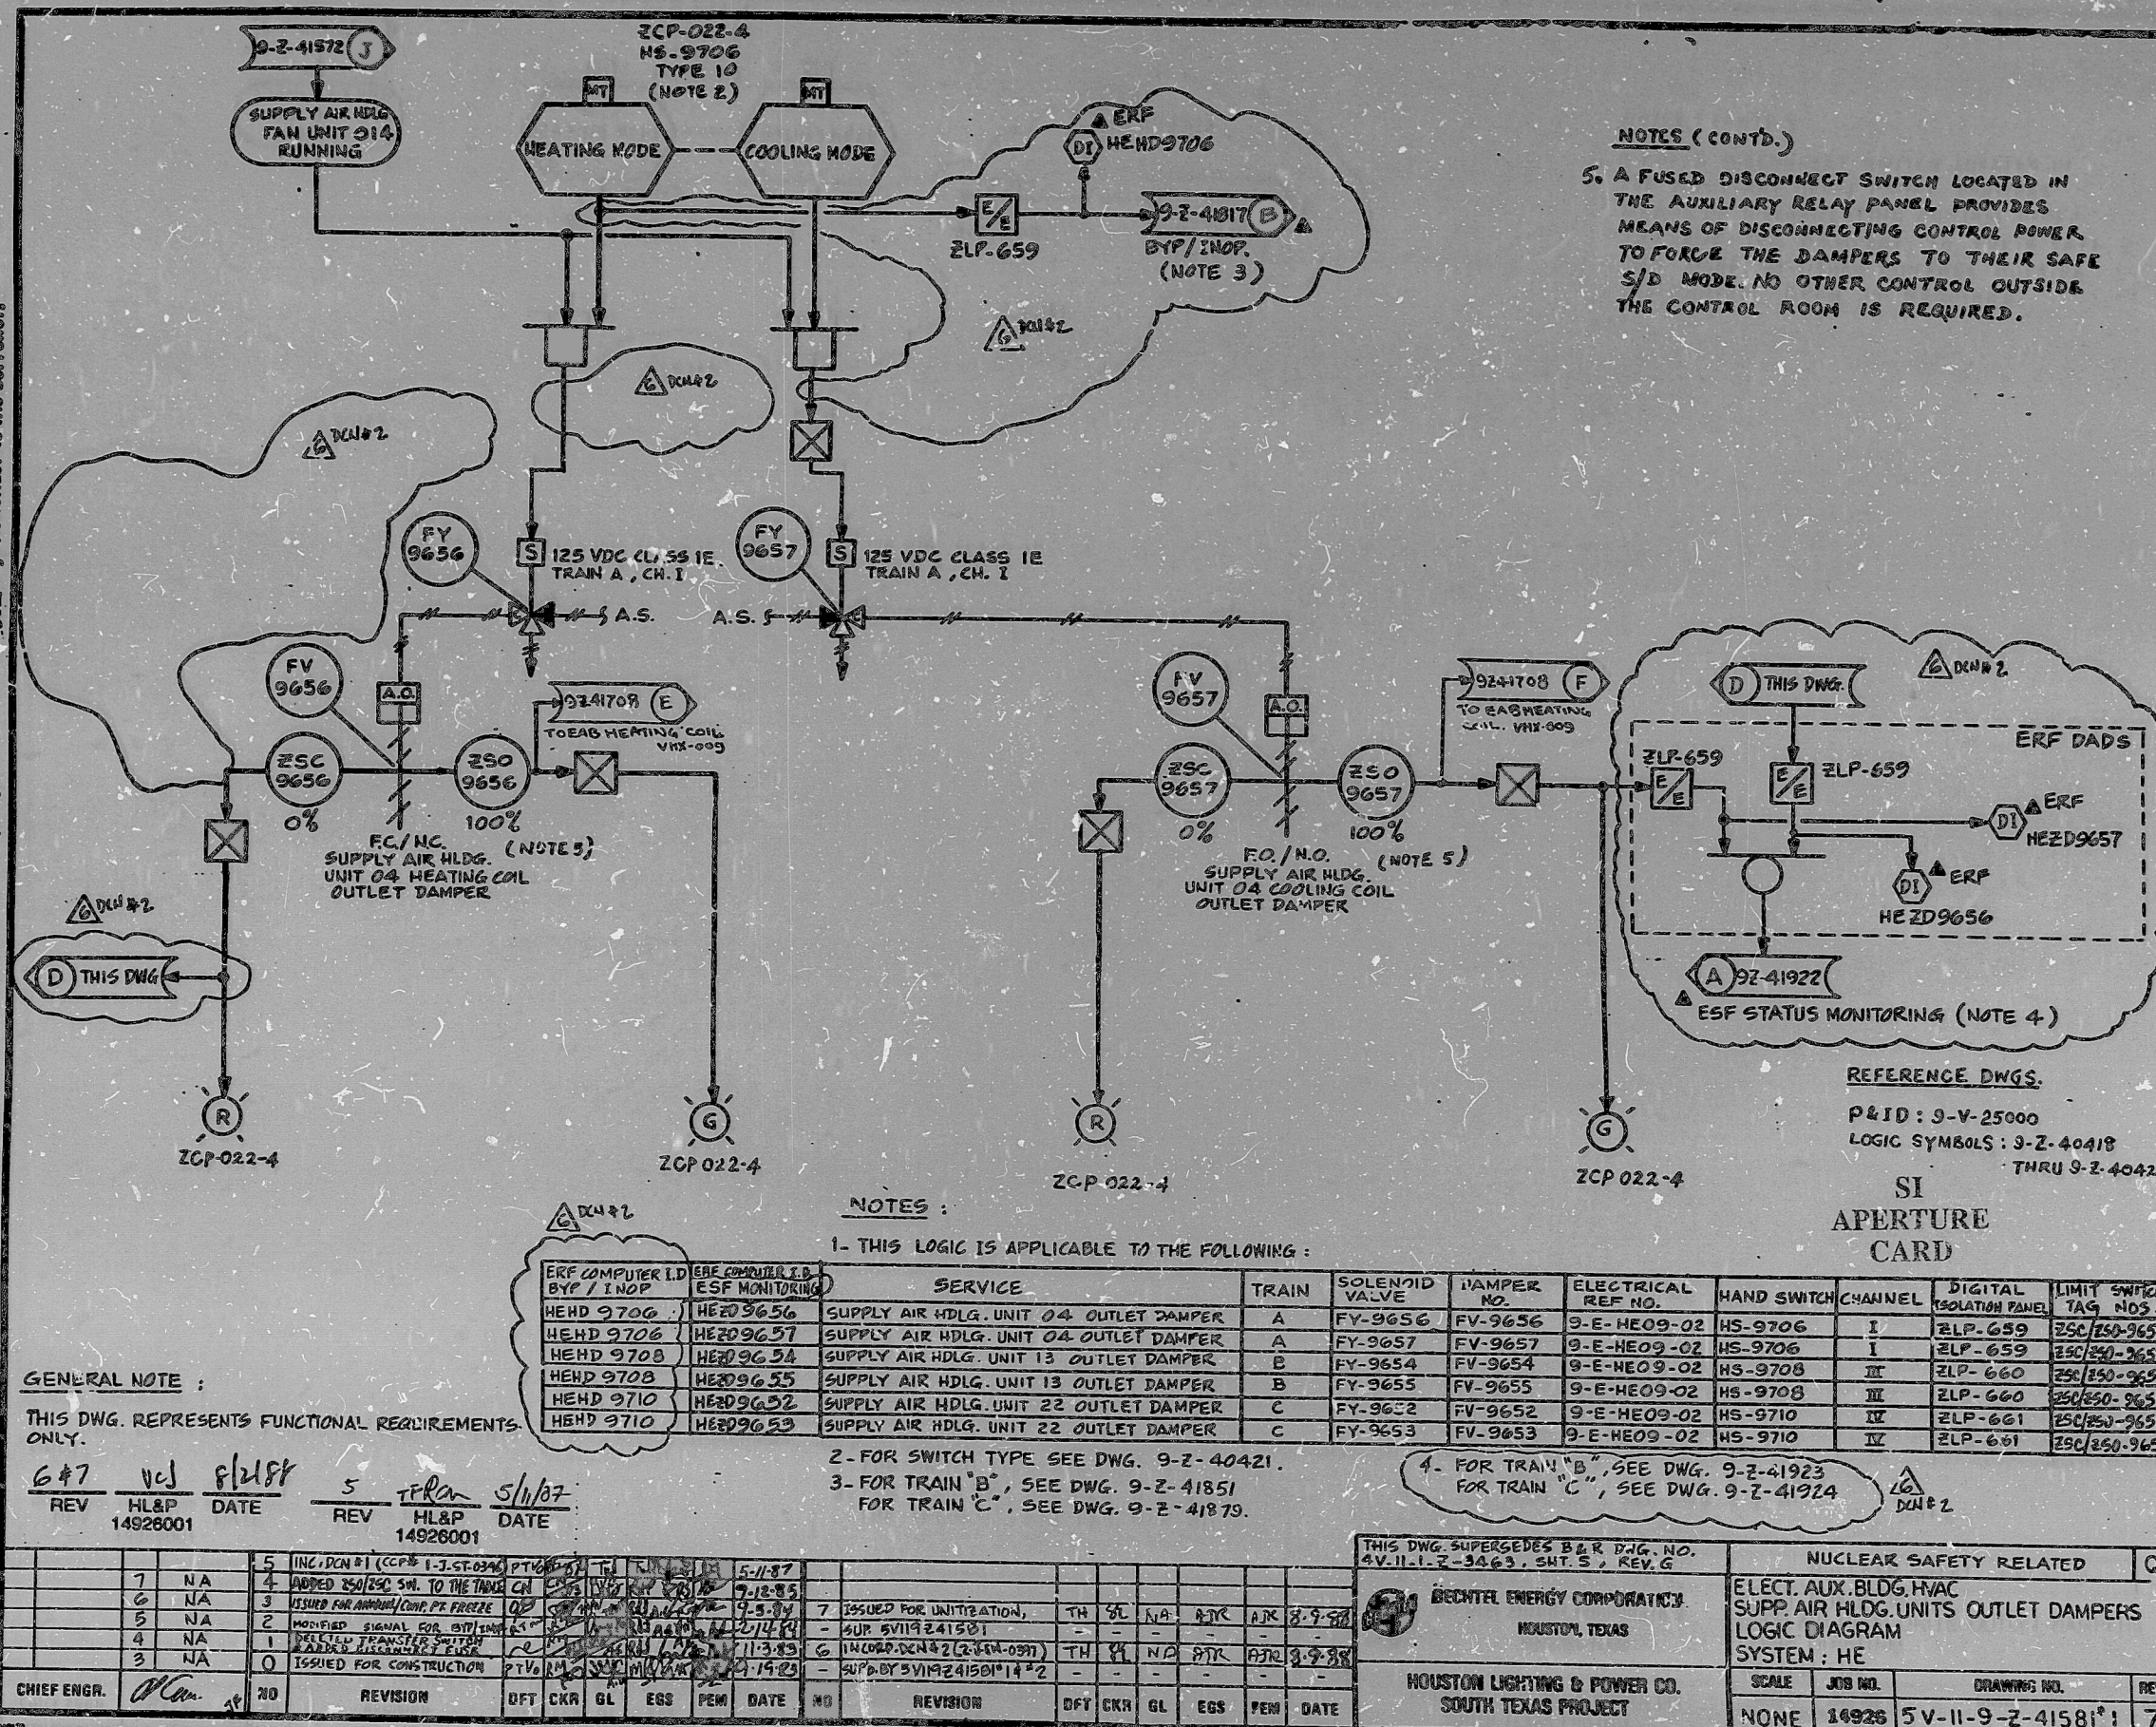

16:1

I certify that the image contained on this frame was made in the normal and regular course of business on the date stated below and that it is an accurate reproduction of the document submitted to microfilm.

Date: 5-11-87 Operator: [Signature] Supervisor: [Signature]



8907270290

PDR RIDS

