


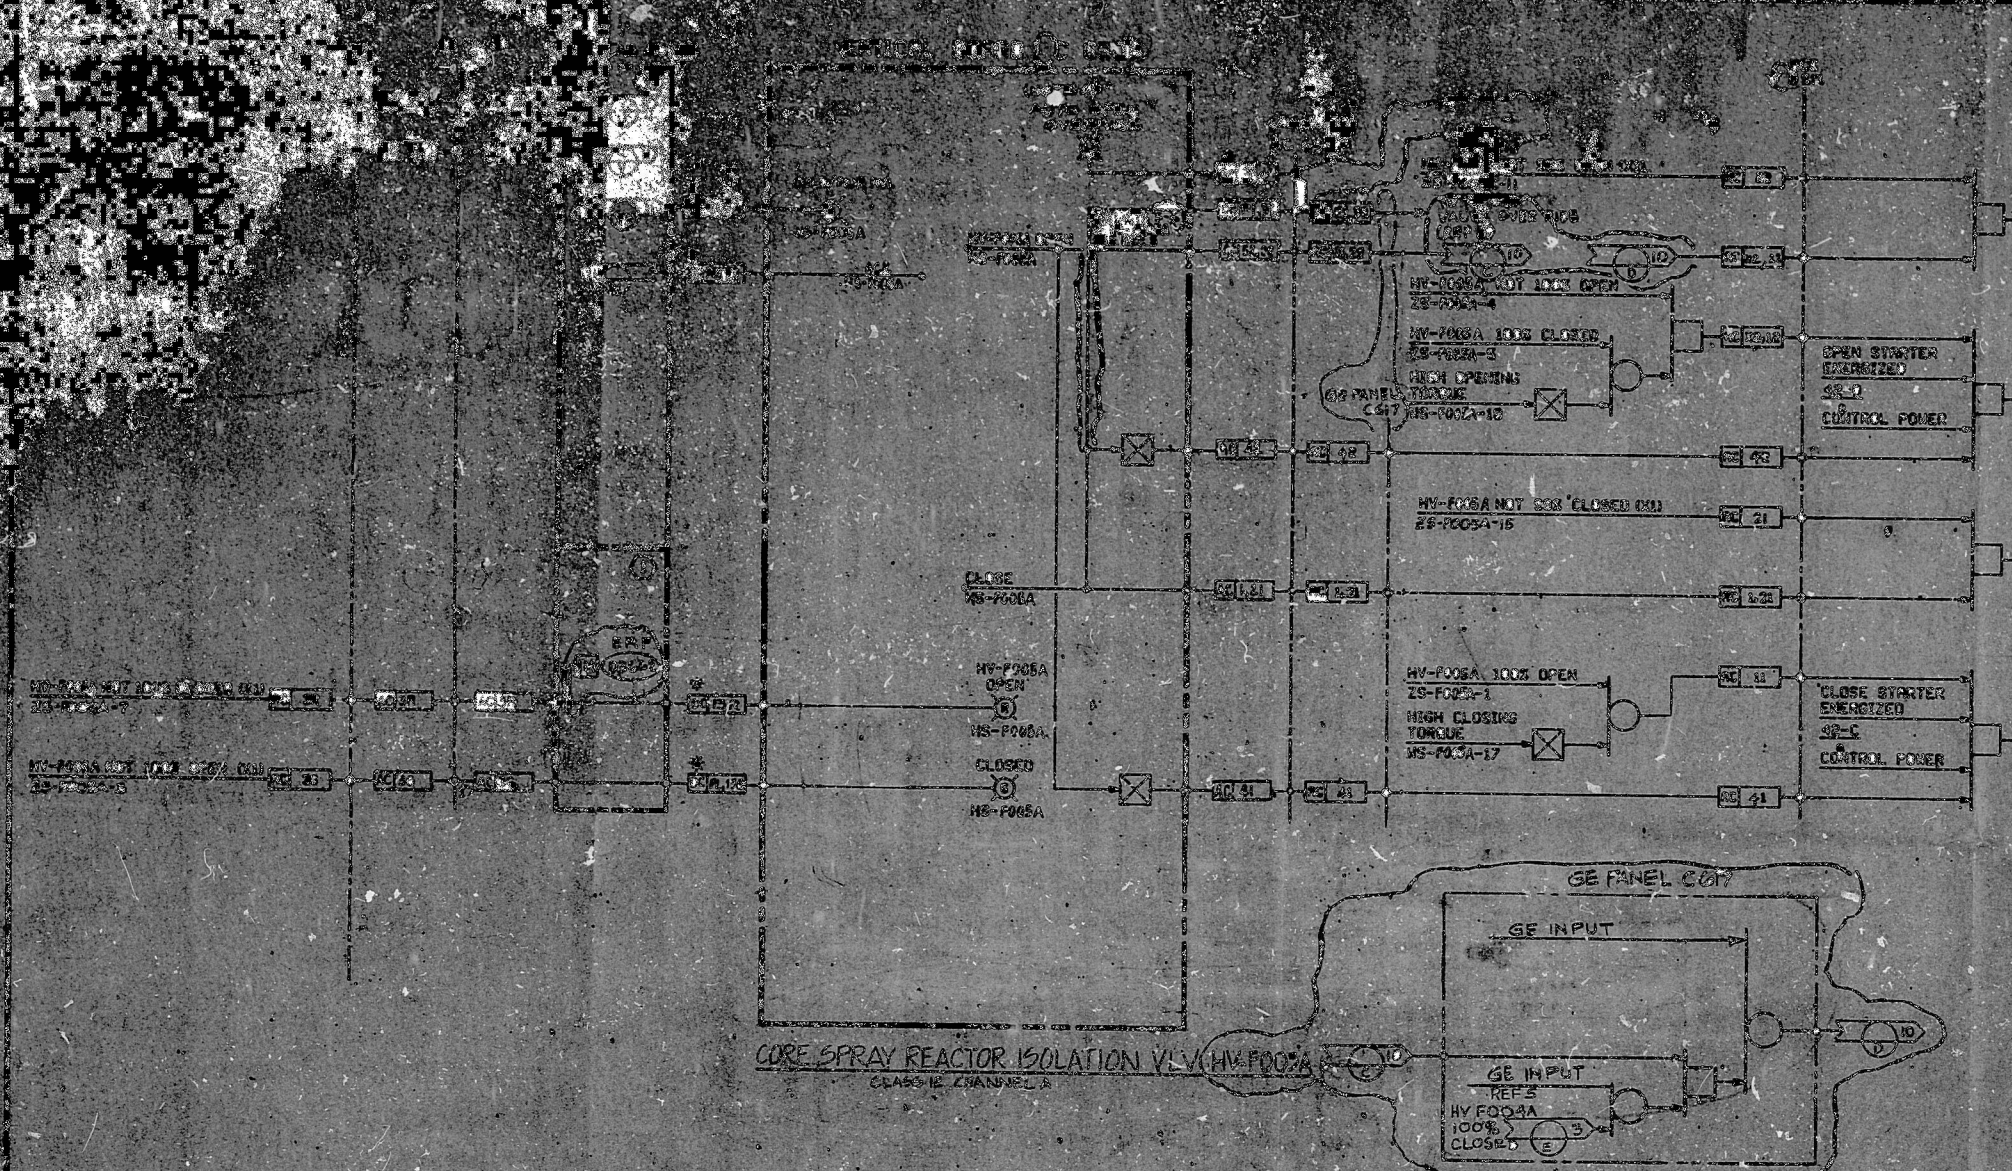

CROSS REFERENCE TABLE

VALVE	SERVICE	CONTROL SWITCH	POSITION SWITCH (NOTE 1)	TORQUE SWITCH (NOTE 1)	STATUS	CLASS	NO.	GE PANEL	LOGIC CABINET	CIRCUIT NO.	ON/OFF/FAIL	OFF NO.	TYPE
HV-F005A	ISOLATION	HS-F005A	ZS-F005A	NS-F005A	05500	A	233	CS-17	AC-22	1	SHUTTER	5	PS-22
HV-F005A	ISOLATION	HS-F005A	ZS-F005A	NS-F005A	05500	B	233	CS-18	AC-22	2	SHUTTER	6	PS-22



- NOTES:
1. THE BASIC POSITION (ON) TORQUE SWITCH AND RED LIGHT VALVE (ON) SWITCH IN THE TRAIL, OPEN AND TO KEYWAY SPECIFIC CIRCUITS SHALL BE SHOWN ON THE DRAWING.
 2. DELETED
 3. DELETED
 4. THE AUTO OVERRIDE LIGHT IS SHOWN FOR REFERENCE ONLY AND IS CONNECTED TO WIRE NO. 82. THE RETURN SIDE OF THE LIGHT IS CONNECTED AS SHOWN ON FIG. 5.

ERC
APERTURE
CARD

POOR ORIGINAL

1	2	
---	---	---	---	---	---	---	---	---	----	----	-----






RIDS

4308050582

