


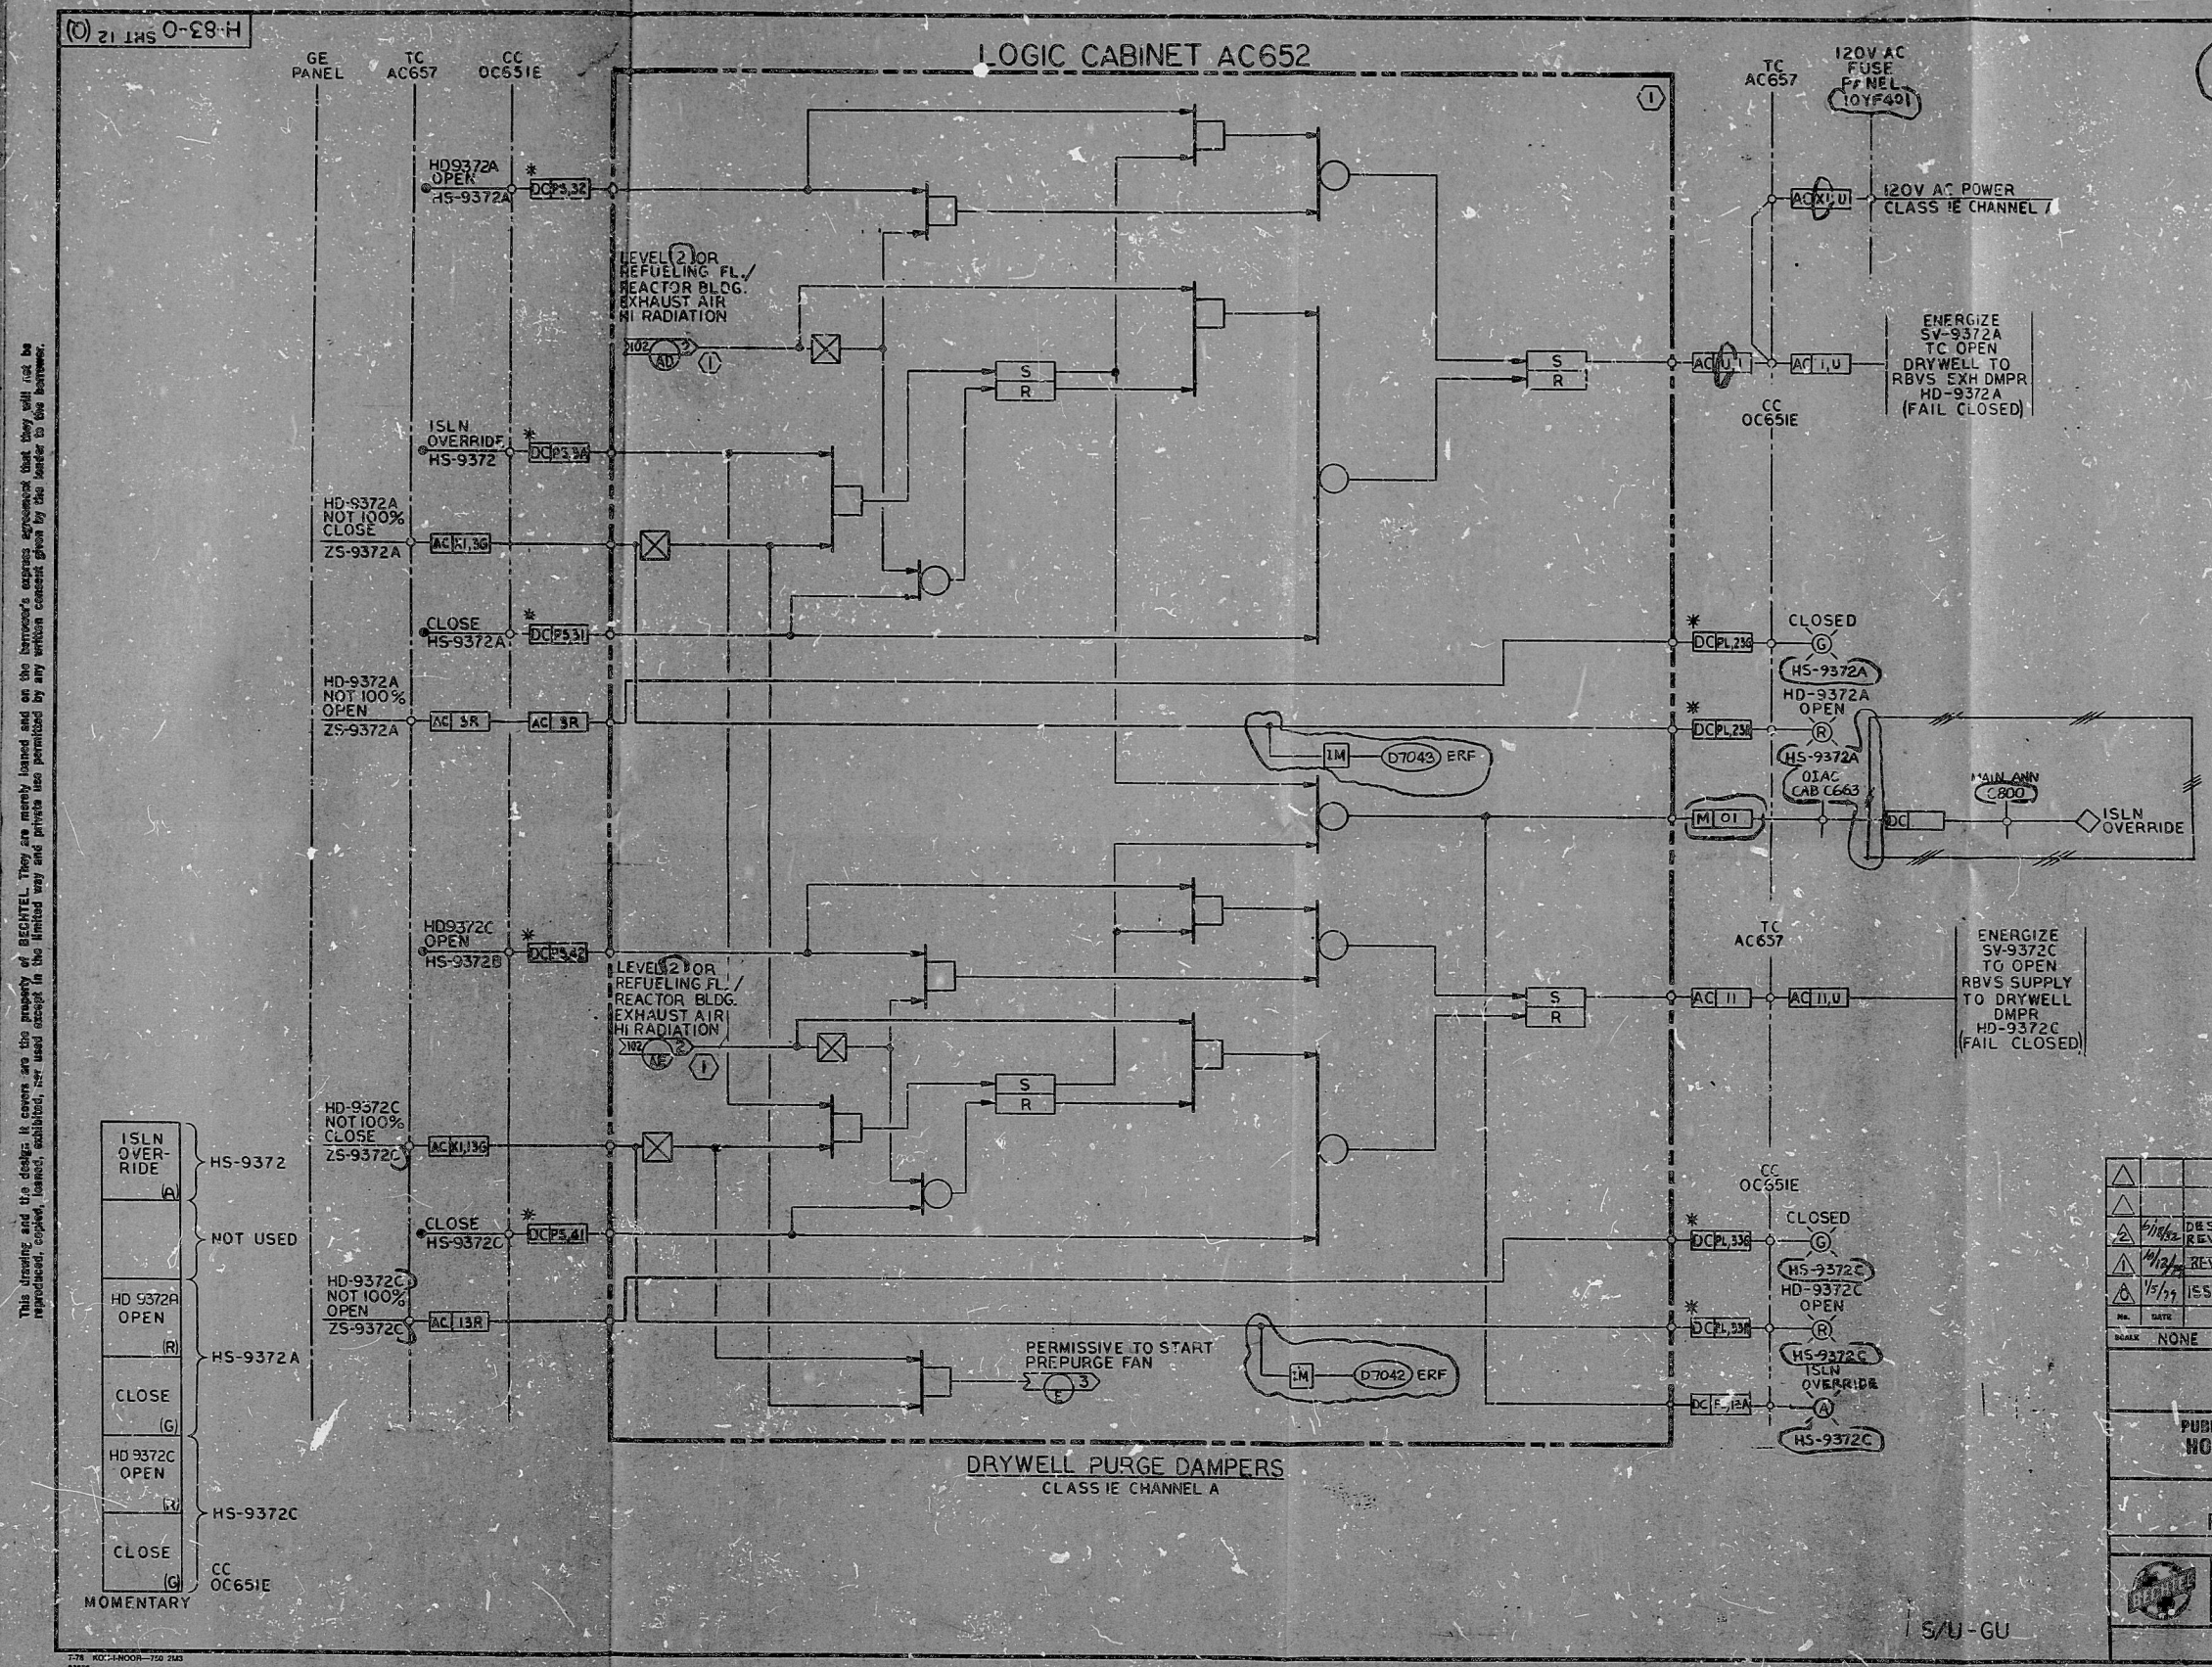

This drawing and its design is covered by the property of DECHTEL. They are hereby loaned and on the borrower's express agreement that they will not be reproduced, copied, loaned, exhibited, nor used except in the limited way and within the consent given by the lender to the borrower.



RIDS

4308050652

