



22

17

10

8.5"

8599

11"

17"

22"

34"

40

77


11

10



11"

174

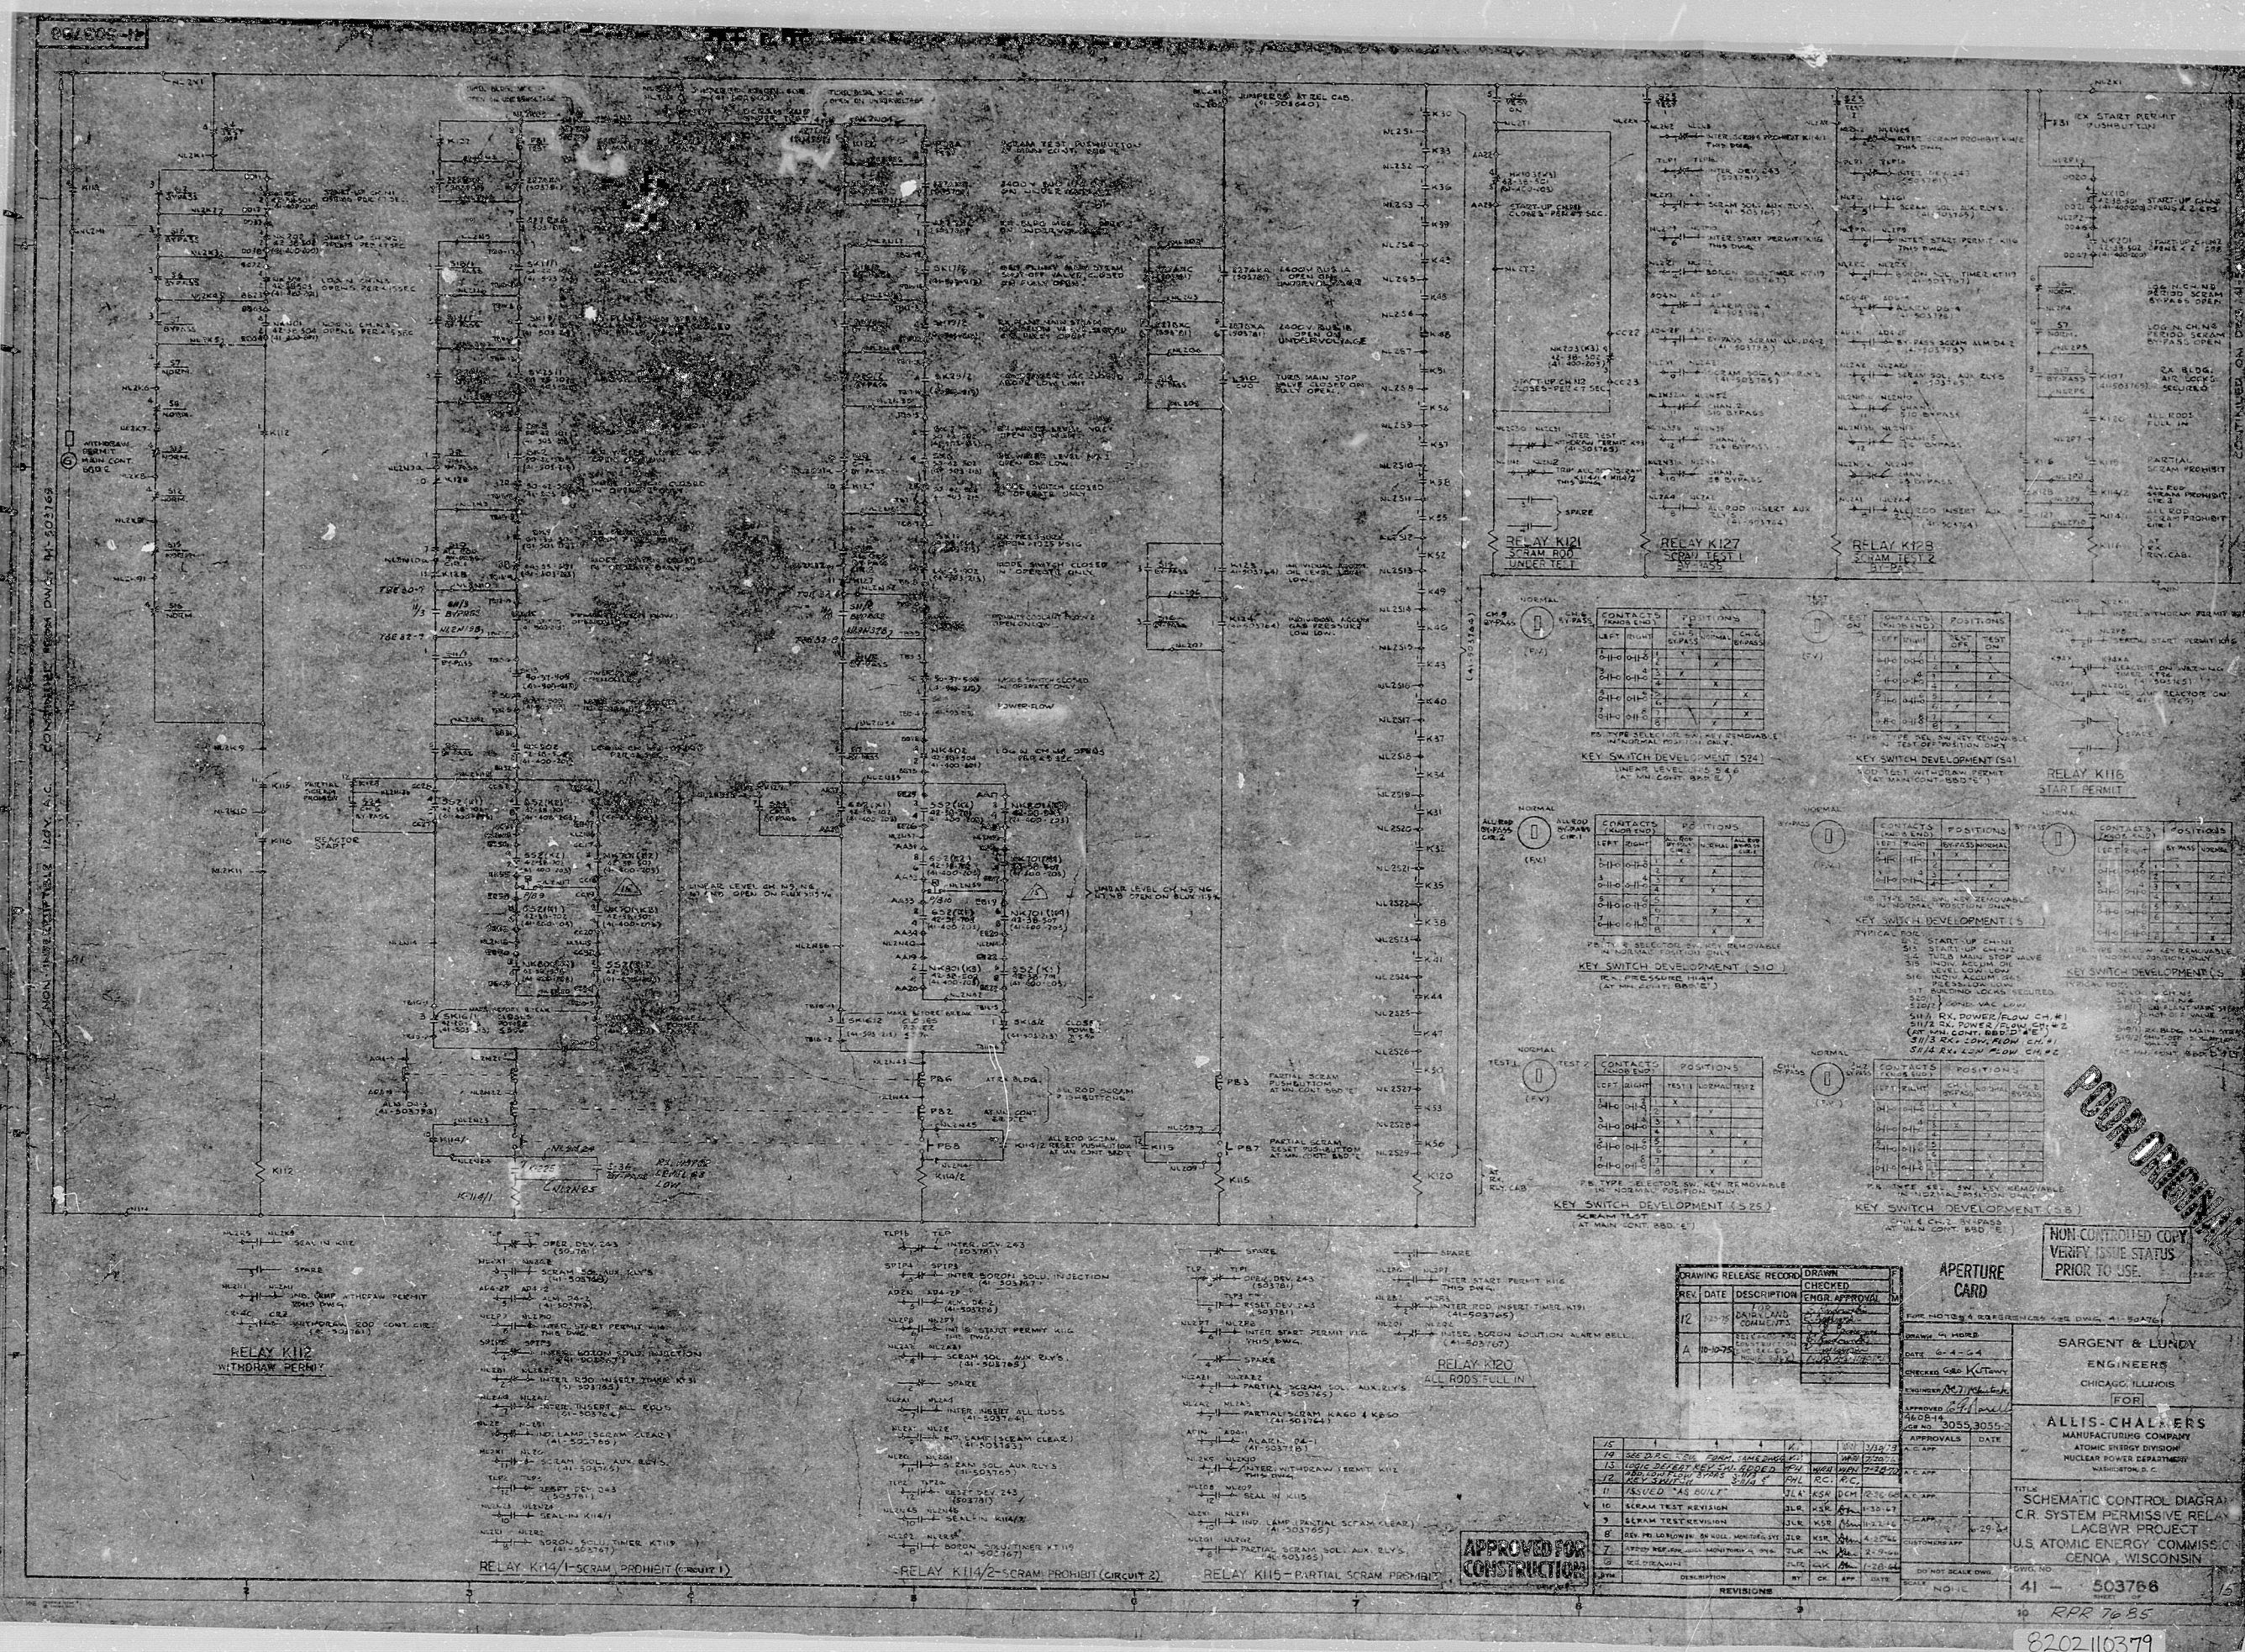

R. OS

8202110379

