




RIDS

8202230632

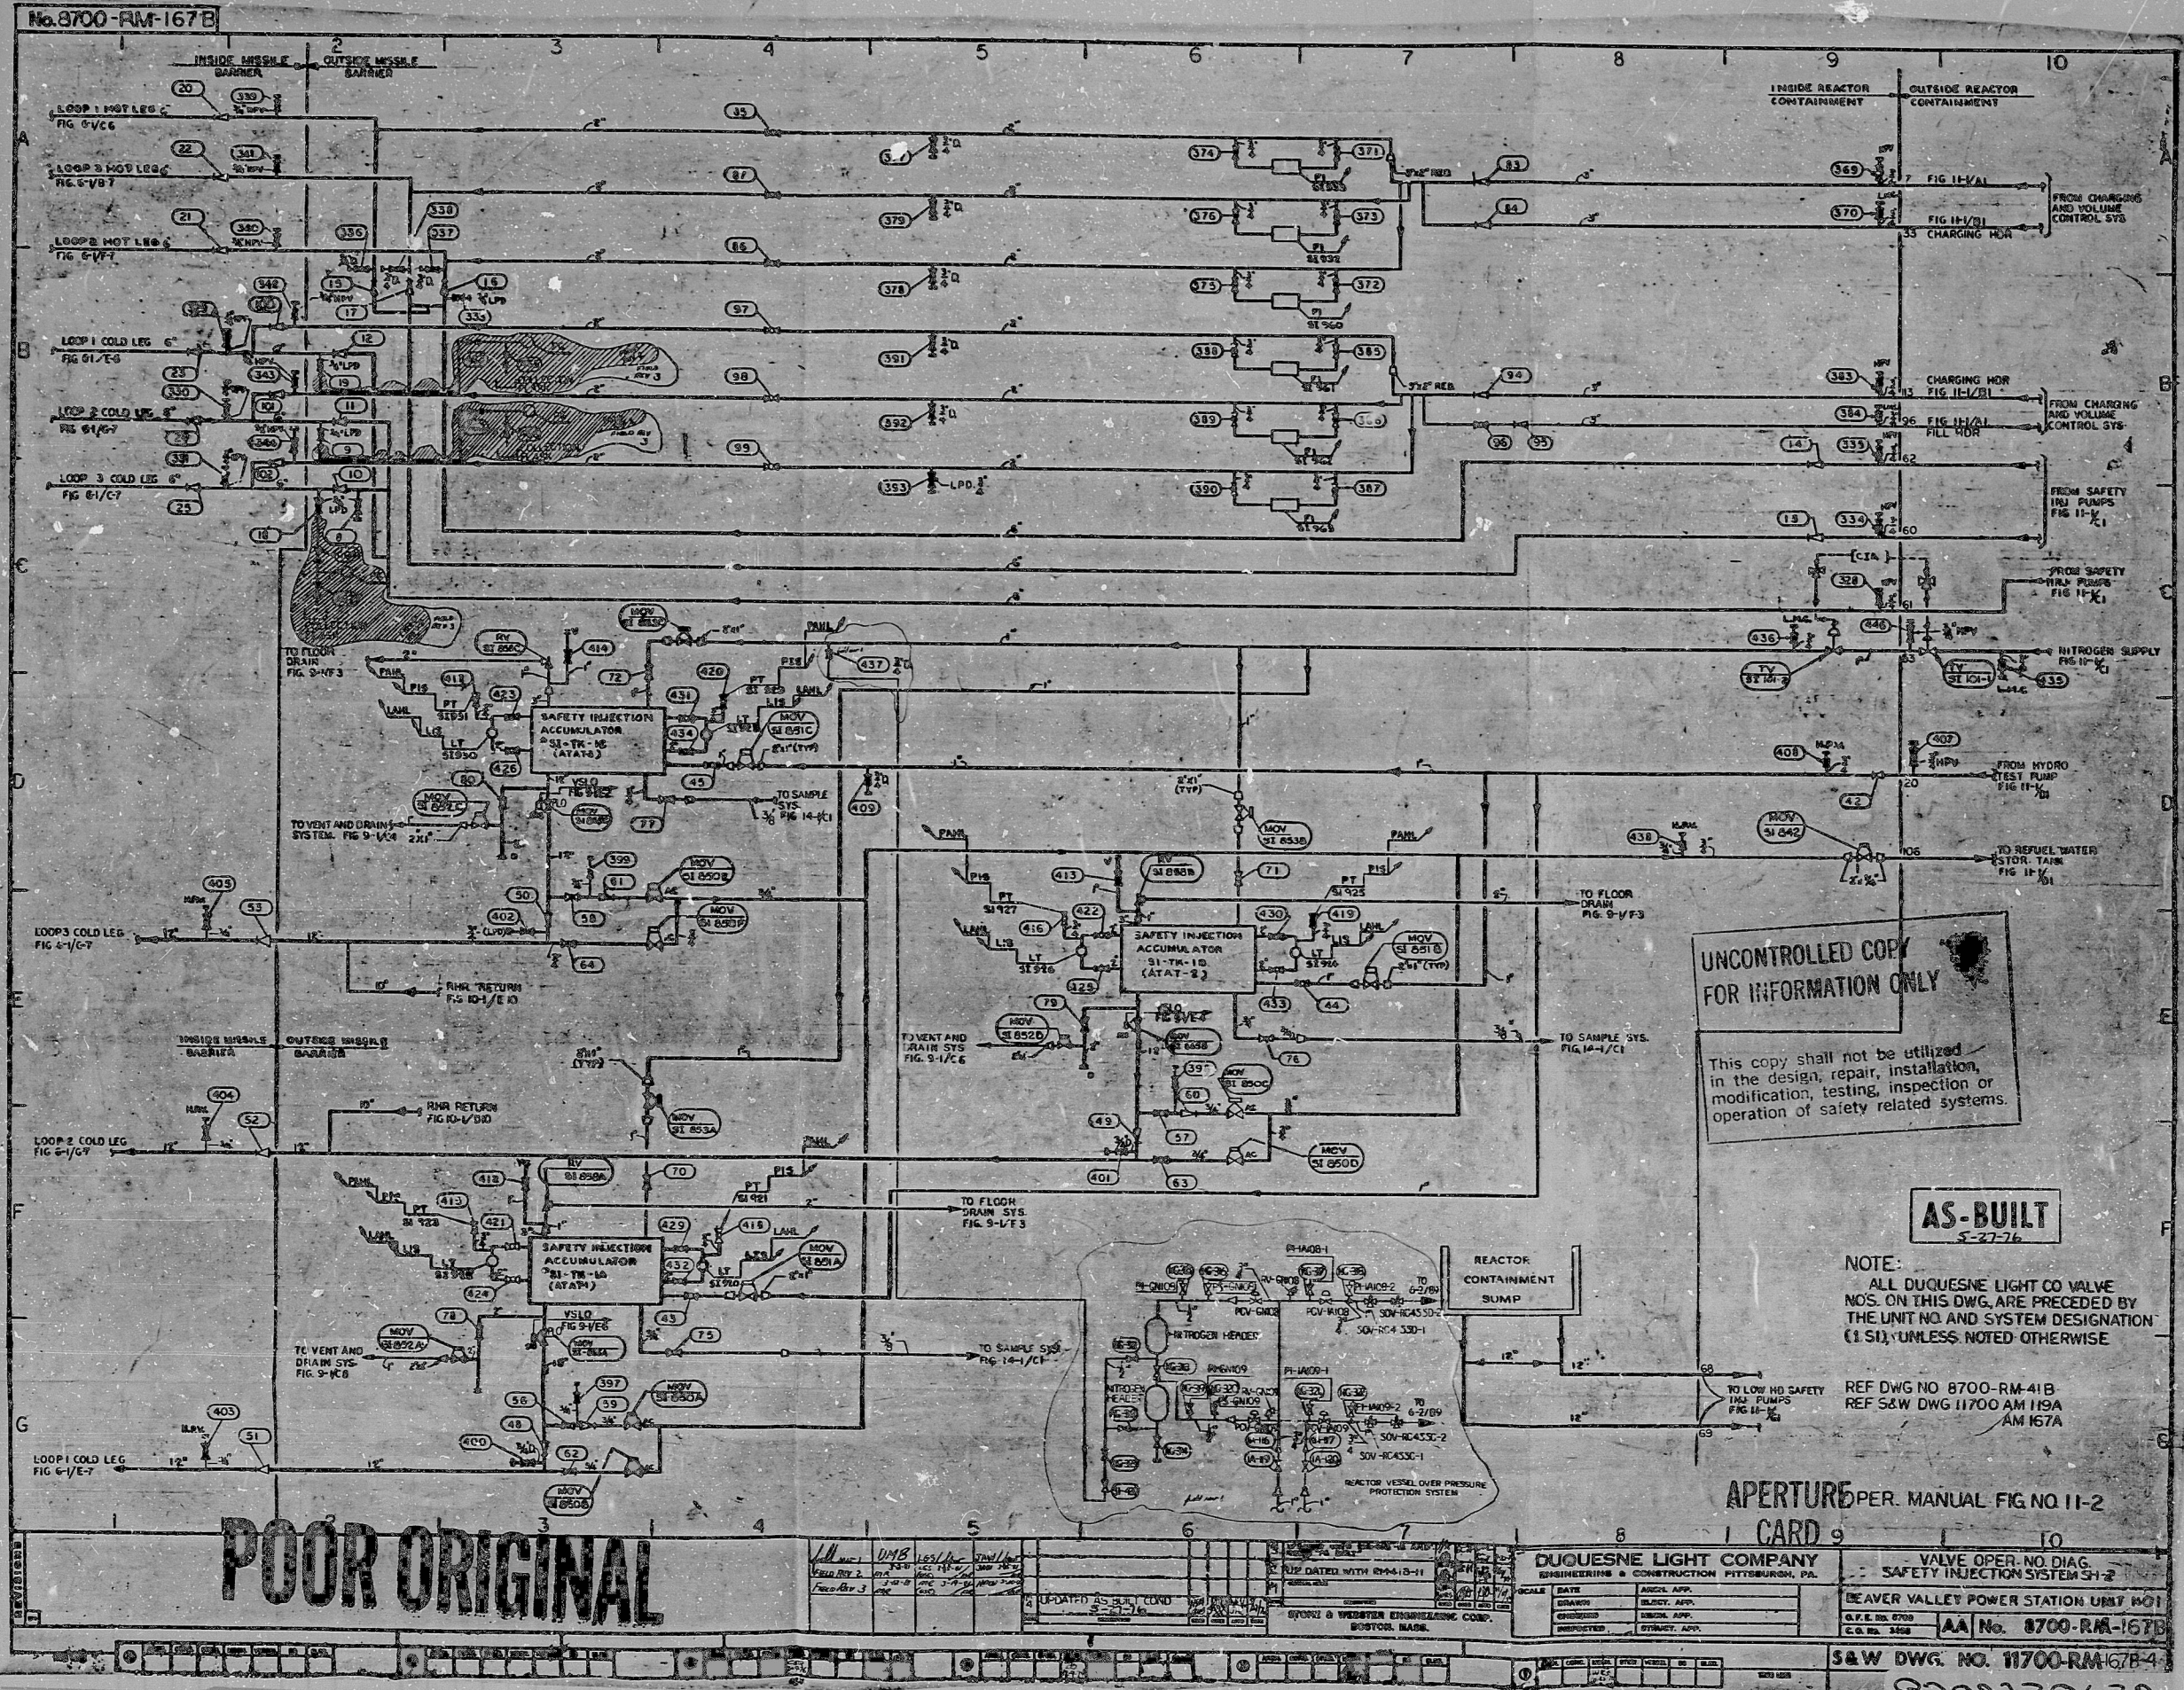